
KOLAR Document ID: 1494040

WATER WELL R			WWC-5		vision of Wat						
Original Record Correction Change			-	Resources App. No			т. <u>1. у</u> 1	Well ID			
1 LOCATION OF WATER WELL:			Fraction $\frac{1}{4}$ $\frac{1}{4}$ $\frac{1}{4}$	Section Number			Township Numb		$\Box E \Box W$		
County: 1/4					$\frac{\frac{1}{4}}{1}$ T S R Street or Rural Address where well is located (if unknown, dista						
					irection from nearest town or intersection): If at owner's address, check here:						
Address:				direction from	i nearest town c	or inter	isection). If at owner	s audiess, o			
Address:											
City:		State:	ZIP:								
3 LOCATE WELL	4 DEPTH	OF COM	IPLETED WELL:		ft. 5 Latit	nde.			(decimal degrees)		
WITH "X" IN SECTION BOX:		Encountered: 1)									
N N	2)	ft	3) ft., or 4)	🗌 Dry Well	Dry Well Datum: TWGS 84 TNAD 83 NAD 27						
			TER LEVEL:		Boulee for Editidae.						
			, measured on (mo-day			GPS (unit make/model:)					
NW NE			, measured on (mo-day vater was		········· (WAAS enabled? ☐ Yes ☐ No) ☐ Land Survey ☐ Topographic Map				10)		
W E		hours				e Mapper:					
			vater was			Jiiiii					
SWSE			s pumping	. gpm		- 4 :					
	Estimated Y				6 Elevation: ft. □ Ground Level □ TO and Source: □ Land Survey □ GPS □ Topographic M.						
S	Bore Hole L		in. to		Source		Other				
7 WELL WATER TO	DE LISED		in. to	II.							
1. Domestic:			ter Supply: well ID		10 🗆 0	il Fie	eld Water Supply: 16	226			
☐ Household	— 11 5										
Lawn & Garden			echarge: well ID								
Livestock	8.	Monitorin	g: well ID		12. Geot		al: how many bores				
2. Irrigation			al Remediation: well I				l Loop 🔲 Horizont				
3. Feedlot		Air Sparge		Extraction		b) Open Loop □ Surface Discharge □ Inj. of Water 13. □ Other (specify):					
4. Industrial		Recovery	5								
Was a chemical/bacteriological sample submitted to KDHE? Yes No If yes, date sample was submitted:											
Water well disinfected?				C A C		~ _					
8 TYPE OF CASING											
Casing diameter											
Casing height above land surface											
	nless Steel		□ PVC		🗆 Ot	her (S	Specify)				
□ Brass □ Galvanized Steel □ None used (open hole)											
SCREEN OR PERFORATION OPENINGS ARE:											
Continuous Slot	☐ Mill Slot						Other (Specify)	•••••			
□ Louvered Shutter SCREEN-PERFORAT				aw Cut				0.4.	0		
				,			,				
9 GROUT MATERIA			n ft. to								
Grout Intervals: From											
Nearest source of possible			potential source of con	ntamination w	ithin 200 ft.			16.			
Septic Tank		Lateral Line	es 🗌 Pit Privy		Livestock P	ens		cide Storage			
Sewer Lines		Cess Pool	🔲 Sewage La		Fuel Storage			oned Water			
U Watertight Sewer Lin			☐ Feedyard		Fertilizer St	orage	e 🗌 Oil We	ll/Gas Well			
☐ Other (Specify) Direction from well?							Ĥ				
10 FROM TO		ITHOLO		FROM	ТО	LIT	THO. LOG (cont.) or	· PLUGGIN	GINTERVALS		
	L			I KOW	10		110. LOG (cont.) 01	1200011	S IIIIII IIII		
					1						
				Notes:							
	11 CONTRACTOR'S OR LANDOWNER'S CERTIFICATION: This water well was constructed, reconstructed, or plugged under my jurisdiction and was completed on (mo-day-year) and this record is true to the best of my knowledge and belief.										
Kansas Water Well Co	ntractor's Lice	ense No	This W	ater Well Re	cord was co	mnle	eted on (mo-day-v	ear)			
under the business nam	e of										
Send one copy to WATER WELL OWNER and retain one for your records. Fee of \$5.00 for each constructed well.											
KS Department of Health and Environment, Bureau of Water, Geology Section, 1000 SW Jackson St., Suite 420, Topeka, Kansas 66612-1367. Telephone 785-296-3565. Visit us at http://www.kdheks.gov/waterwell/index.html KSA 82a-1212											

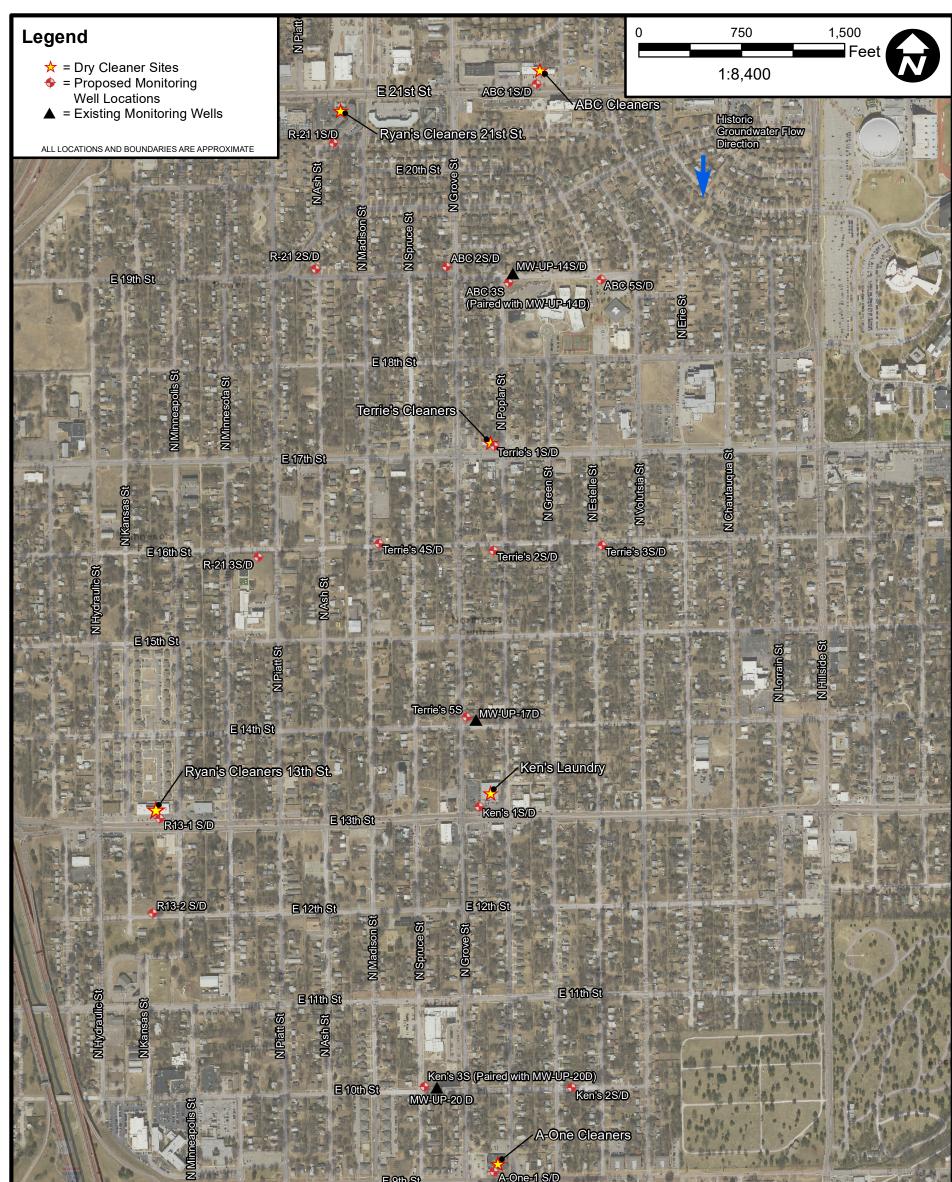

But I	E 9th St	A-One-1 S/D		T- LUMA	
		E 8th St A-One-2 S/D			
	Murdock St	A-One-3 S/D			
	e-4 S/D One-5 S/D A-One-6 S/D	Elm St	G	4503 East 4 Wichita, KS 316-554-072	67210
SITE BASE MAP WITH PROPOSED MONITORING WELL LOCATIONS	19th & Grove Dry (Wichita, K		PROJECT #: 1874235 DATE: 2019-01-10	DRAWN BY: CD PROJ. MNGR: KW	figure