	WELL REC		_	n WWC-							of Water			Wall ID	MW10
	nai Record	Correction		hange in Wel					Keso		App. No.			Well ID	
	CATION OF V		CLL:		ction			`			ection Numb			ber Rang	
	ty Sedgwick				E 1/4	SE ¼			NE	<u> </u>	21	<u> T</u>	27		I XE'
1 .	LL OWNER: ess: KDHE	Last Name:		Fir	st:						ss where wel intersection):				e and direction
	ess: 1000 SW.	Jackson Blvd					1		St., Wic		•	II at 0	wiici 5 au	diess, check	nore.
Addre		Jackson Diva					1,030 ;	L 2110	JI., WIC	viiita,	NO.				
City		peka	State: KS	S ZIF	P: 666	12									
	ATE WELL	4	DEPTH C	OF COMPI	LETED	WELL:	22	f	t	5	Latitude:	**********		grees,minute	,,,,,,,,,,,,,,,,,,,,,,,,,,,,,,,,,,,,,,,
	H "X" IN	Dep	th(s) Ground	lwater Enco	untered:	سر (1		f	t					grces,minute	
SECT	TION BOX:	1 1/2	!) LL'S STATIO	ft 3)	ft,	or 4)[_	JDry W				Horizontal Source for				D 83 NAD 2
l	N T		below lar			***************************************		ft. 	26/20			unit make/		•	,
	١.,	1 1 =		nd surface, r										Yes N	
→ NW	NE NE		ump test data				ft	***************************************			X Land S				,
w		l _E	after	hours p	oumping			m				Маррег			
		7		Water	well was	3	ft								
sw	SE SE	_ _	after	hours p	oumping	***************************************	gp	m		6				Ground	
`			stimated Yie	:ld:	gpm	1					SourceX				Topographic Ma
	S	—	ore Hole Dia	ameter:	7.25	in to		and	İ			Other	***************************************		***************************************
	1 mile			*******	***************************************	in to	п								
	L WATER TO		S:		·····						<u> </u>				
1 Domestic:		5	=	ater Supply:						10	Oil Field V	Vater Supp	oly: lease		
House		. 6□	=	ng: how ma	-	?				-	est Hole: well				
. =	1 & Garden	7	= '	echarge: we								Uncas		Geotechn	ical
Lives		_	Monitorin	•							eothermal: Ho		-		• •
2 Irriga 3 Feedl		9 6	nvironmenta								Closed Loo	. =		Vert	
4 Indus		<u> </u>	Air Sparg	_	Injection	ipor Extra	CHOF			<u>0)</u>	Other (spe	.:63.		_	Inj. of Water
ļ. —					· ·										
	ical/bacteriolo			to KDHE?		Yes X	No	I	f yes, da	ite sar	mple was sub	mitted:			
Water well di		Yes XN													
Casing diam	E OF CASING	in. to l	2 It,	Diameter	Other	in.	to	CAS	ING JO! ft,	INTS D	:Glu iameter ness or gauge	ed [Cl	ampled [] Welded ft	X Threaded
	ht above land su SCREEN OR		29 in.	Weighi	<u></u>		lbs	s./nt.	Well	thick	ness or gauge	: No	••••••	••••••••	
Steel		ess Steel	Fiberg		X PVC	,				Otho	r (Specify)				
Brass		nized Steel			_	e used (o	nen hole	٠,	ш	Other	(Specify)				
1 —	OR PERFORA					ic uscu (o	pen noic	.,							
. —		X Mill Slot		Gauze Wr	anned	Пт	orch Cu	, г	Drill	ed Ho	oles [Other	(Specify)		
	ered Shutter						aw Cut		=		en Hole)		(opeon)		
SCREEN-PE	ERFORATED	INTERVALS	: From	12 ft.	to	22 R,	From	_	· · · · · · · · · · · · · · · · · ·	ft. to		ft, From		ft. to	ft,
GRA	VEL PACK II	NTERVALS	: From	10 ft.			From		f	ft. to		ft, From	***************************************	ft. to	ñ,
9 GROUT	MATERIAL:	Neat	cement	Cemen	t grout	X Be	ntonite		Other	r Co	oncrete: 0-0.5	': Gravel			
Grout interva	als: From	l ft. to		ft, From	_	ft. to					ft.			***************************************	***************************************
Nearest sou	rce of possibl			• '	***************************************	*****	***************************************	********	,		***************************************				
_	c Tank		Lateral Lin	nes	Pit	Privy		Г	Lives	stock	Pens	∏ In	secticide	Storage	
Sewei	r Lines		Cess Pool		Sev	vage Lago	on	x	=	Stora		ΠA	bandoned	Water Well	
Water	rtight Sewer Lin	nes 🗀	Seepage P	it		dyard			=		Storage	_	il Well / (
	(Specity)					************	******	_	_		-				
Direction fron	n well? S				Dist	ance fron	well?	~40	•••••		***************************************		ft		
10 FROM			LITH	OLOGIC	LOG			F	ROM	T	то	LITHO.	LOG (con	t.) or PLUGG	ING INTERVALS
0	0.5	Concrete								I					
0.5 I	7	Gravel fill						<u> </u>		+		······································			
7	8	Silty clay Clayey silt				· · · · · · · · · · · · · · · · · · ·		 		+					
8		Fine silty san	d					<u> </u>		+					
10	14	Clayey silt					-			十				·	NOTE:
14	18	Medium sand	i								: Car Care;				7.7
18	22	Coarse sand										ıllow grou	ndwater,	<20' of grout	was installed at th
	<u> </u>	<u> </u>							tion of k					-,	- red Bay regulation of
	TRACTOR'S								[X]	const	ructed,	reconstru	ted, or	plugged	under my
		oleted on (mo-	uay-year)	X17477()	and	ınıs recor					nowledge and	ı bellet. K	ansas W	ne eo	ILLACTOL 2
		7 Т				alated	(ma dan		1014						
License N	lo 757		his Water W	ell Record v	vas comp		-	-	***************************************		onature	(The state of the s
License N	lo 757 business name o	of Larsen &	his Water Wo Associates,	ell Record v Inc.	vas comp					Si	gnature	nt, Bureau	Water.	oection,	
License N	business name of Mail 1 white		his Water Wo Associates, ith a fee of S5	ell Record v Inc. .00 for each c	vas comp	d well to:	Kansas D	epartm	ent of He	Sią ealth a	nd Environmen				

DURR ENGINEERING LLC 525 HOWARD HUTCHINSON, KS 67501 620-663-9613 9/14/2020

SURVEY MONITOR WELL MV10 CAR CARE 2ND AND PENNSYLVANIA 1630 E 2ND ST N WICHITA KS

THE ABOVE SITE IS IN THE SOUTHEAST QUARTER OF SECTION 21, TOWNSHIP 27 SOUTH, RANGE 1 EAST OF THE 6TH PRINCIPAL MERIDIAN. THE PREVIOUS SURVEY OF OTHER WELL AT THE SITE ASSIGNED COORDINATES OF NORTH 0.00 AND WEST 0.00 TO THE SOUTHEAST CORNER OF SAID SECTION 21, AND A BEARING OF NORTH TO THE EAST LINE.

VERTICLE CONTROL FOUND AT THE PROPERTY IS AN 'X' CUT IN THE SOUTHWEST CORNER OF A CONCRETE BASE FOR A SIGN AT THE NORTHEAST CORNER OF 2ND AND PENNSYLVANIA.

LATITUDE, LONGITUDE, AND ELEVATIONS ARE LISTED BELOW:

NORTH WEST LATITUDE LONGITUDE ELEVATION
MV10 4064.21 253.40 37°41'24.6" 97°19'05.4" 1299.70 TOP COVER
SE-SE-NE-NE 1299.41 TOP CASING


RESPECTFULLY SUBMITTED

BUNGAN W DURR, RLS 697

9/15/2020 REVISED ALIQUOT CALL

PROJECT # 20008

9/16/2020, 1:51 PM

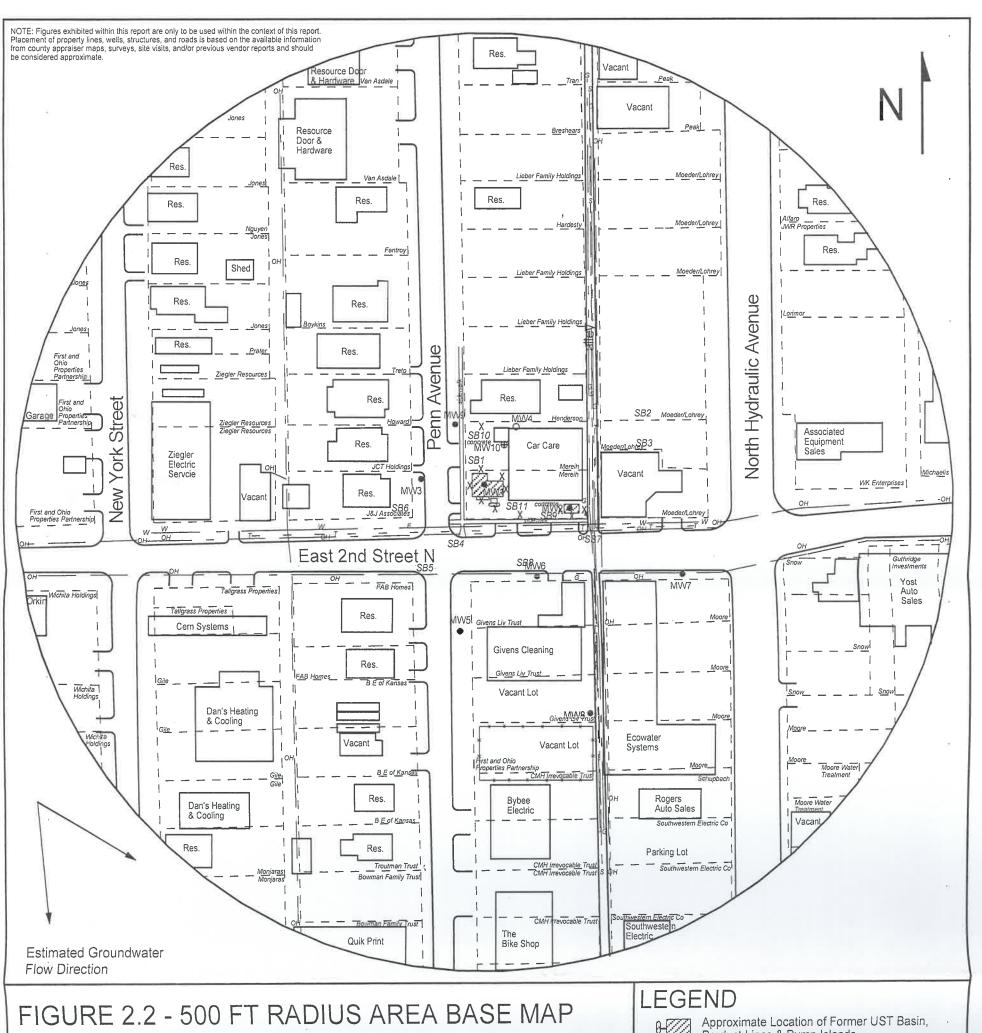



1311 E 25th St., Suite B Lawrence, KS 66046

785-841-8707 office 785-865-4282 fax

PROJECT:

Car Care 1630 E 2nd St. Wichita, KS

KDHE ID: U2-087-01307

Date: 8/25-26/20

100 ft

Approximate Location of Former UST Basin, Product Lines & Pump Islands

Approximate Location of Property Line

Existing Monitoring Well

⊕ Monitoring Well (Installed 8/24/20)

X Soil Boring (Drilled 8/25-26/20)

F Fire Hydrant

Gas Lines (1.5 - 3 ft bgs)

Overhead Lines (25'-40' high)

Sewer Lines (2 - 6 ft bgs) Telephone Lines (2 - 6 ft bgs)

Water Lines (2 - 6 ft bgs)

NOTE: SB5 & SB6 will be drilled to collect hydrologic samples. NOTE: Utility depths, heights and locations are approximate.