

WATER WELL RECORD Form WWC-5

Original Record Correction Change in Well Use

Division of Water Resources App. No.

MW-739A

Well ID

1 LOCATION OF WATER WELL: County: Sedgwick	Fraction ¼ SE ¼ NW ¼ NW ¼	Section Number 33	Township Number T 27 S	Range Number R 1 E W
--	------------------------------	----------------------	---------------------------	-------------------------

2 WELL OWNER: Last Name: First: Business: City of Wichita/Environmental Health Address: 455 N. Main City: Wichita State: KS ZIP: 67202	Street or Rural Address where well is located (if unknown, distance and direction from nearest town or intersection): If at owner's address, check here: <input type="checkbox"/> 1758 St. Francis, Wichita, KS. Well located on the SW corner of the property.
--	---

3 LOCATE WELL WITH "X" IN SECTION BOX:

N

NW	NE
SW	SE

S

-----1 mile-----

4 DEPTH OF COMPLETED WELL: 37.5 ft.

Depth(s) Groundwater Encountered: 1) 18.5 ft.
2) _____ ft. 3) _____ ft., or 4) Dry Well

WELL'S STATIC WATER LEVEL: 19.55 ft.

below land surface, measured on (mo-day-yr) 12-1-20
 above land surface, measured on (mo-day-yr) _____

Pump test data: Well water was _____ ft.
after _____ hours pumping _____ gpm
Well water was _____ ft.
after _____ hours pumping _____ gpm

Estimated Yield: _____ gpm

Bore Hole Diameter: 3.25 in. to 37.5 ft. and _____ in. to _____ ft.

5 Latitude: 37.66078 (decimal degrees)
Longitude: 97.33152 (decimal degrees)

Horizontal Datum: WGS 84 NAD 83 NAD 27

Source for Latitude/Longitude:
 GPS (unit make/model: Garmin c60
(WAAS enabled? Yes No)
 Land Survey Topographic Map
 Online Mapper: _____

6 Elevation: _____ ft. Ground Level TOC
Source: Land Survey GPS Topographic Map
 Other _____

7 WELL WATER TO BE USED AS:

1. Domestic: <input type="checkbox"/> Household <input type="checkbox"/> Lawn & Garden <input type="checkbox"/> Livestock	5. <input type="checkbox"/> Public Water Supply: well ID _____ 6. <input type="checkbox"/> Dewatering: how many wells? _____ 7. <input type="checkbox"/> Aquifer Recharge: well ID _____ 8. <input checked="" type="checkbox"/> Monitoring: well ID MW-739A	10. <input type="checkbox"/> Oil Field Water Supply: lease _____ 11. Test Hole: well ID _____ <input type="checkbox"/> Cased <input type="checkbox"/> Uncased <input type="checkbox"/> Geotechnical
2. <input type="checkbox"/> Irrigation	9. Environmental Remediation: well ID _____ <input type="checkbox"/> Air Sparge <input type="checkbox"/> Soil Vapor Extraction	12. Geothermal: how many bores? _____ a) Closed Loop <input type="checkbox"/> Horizontal <input type="checkbox"/> Vertical b) Open Loop <input type="checkbox"/> Surface Discharge <input type="checkbox"/> Inj. of Water
3. <input type="checkbox"/> Feedlot	4. <input type="checkbox"/> Industrial	13. <input type="checkbox"/> Other (specify): _____

Was a chemical/bacteriological sample submitted to KDHE? Yes No If yes, date sample was submitted: _____
Water well disinfected? Yes No

8 TYPE OF CASING USED: Steel PVC Other _____ CASING JOINTS: Glued Clamped Welded Threaded

Casing diameter 1.25 in. to 27.5 ft., Diameter _____ in. to _____ ft., Diameter _____ in. to _____ ft.
Casing height above land surface 0.3 in. Weight _____ lbs./ft. Wall thickness or gauge No. Sch. 40

TYPE OF SCREEN OR PERFORATION MATERIAL:
 Steel Stainless Steel Fiberglass PVC Other (Specify) _____
 Brass Galvanized Steel Concrete tile None used (open hole)

SCREEN OR PERFORATION OPENINGS ARE:
 Continuous Slot Mill Slot Gauze Wrapped Torch Cut Drilled Holes Other (Specify) _____
 Louvered Shutter Key Punched Wire Wrapped Saw Cut None (Open Hole)

SCREEN-PERFORATED INTERVALS: From 27.5 ft. to 37.5 ft., From _____ ft. to _____ ft., From _____ ft. to _____ ft.
GRAVEL PACK INTERVALS: From 24.5 ft. to 37.5 ft., From _____ ft. to _____ ft., From _____ ft. to _____ ft.

9 GROUT MATERIAL: Neat cement Cement grout Bentonite Other _____
Grout Intervals: From 2 ft. to 24.5 ft., From _____ ft. to _____ ft., From _____ ft. to _____ ft.

Nearest source of possible contamination:
 Septic Tank Lateral Lines Pit Privy Livestock Pens Insecticide Storage
 Sewer Lines Cess Pool Sewage Lagoon Fuel Storage Abandoned Water Well
 Watertight Sewer Lines Seepage Pit Feedyard Fertilizer Storage Oil Well/Gas Well
 Other (Specify) _____

Direction from well? _____ Distance from well? _____ ft.

10 FROM	TO	LITHOLOGIC LOG	FROM	TO	LITHO. LOG (cont.) or PLUGGING INTERVALS
0	7	Silty Clay			
7	37	Sand			
37		Weathered Shale			
Notes:					

11 CONTRACTOR'S OR LANDOWNER'S CERTIFICATION: This water well was constructed, reconstructed, or plugged under my jurisdiction and was completed on (mo-day-year) 11/23/2020 and this record is true to the best of my knowledge and belief. Kansas Water Well Contractor's License No. 710 This Water Well Record was completed on (mo-day-year) 12/9/2020 under the business name of Below Ground Surface, Inc. Signature _____

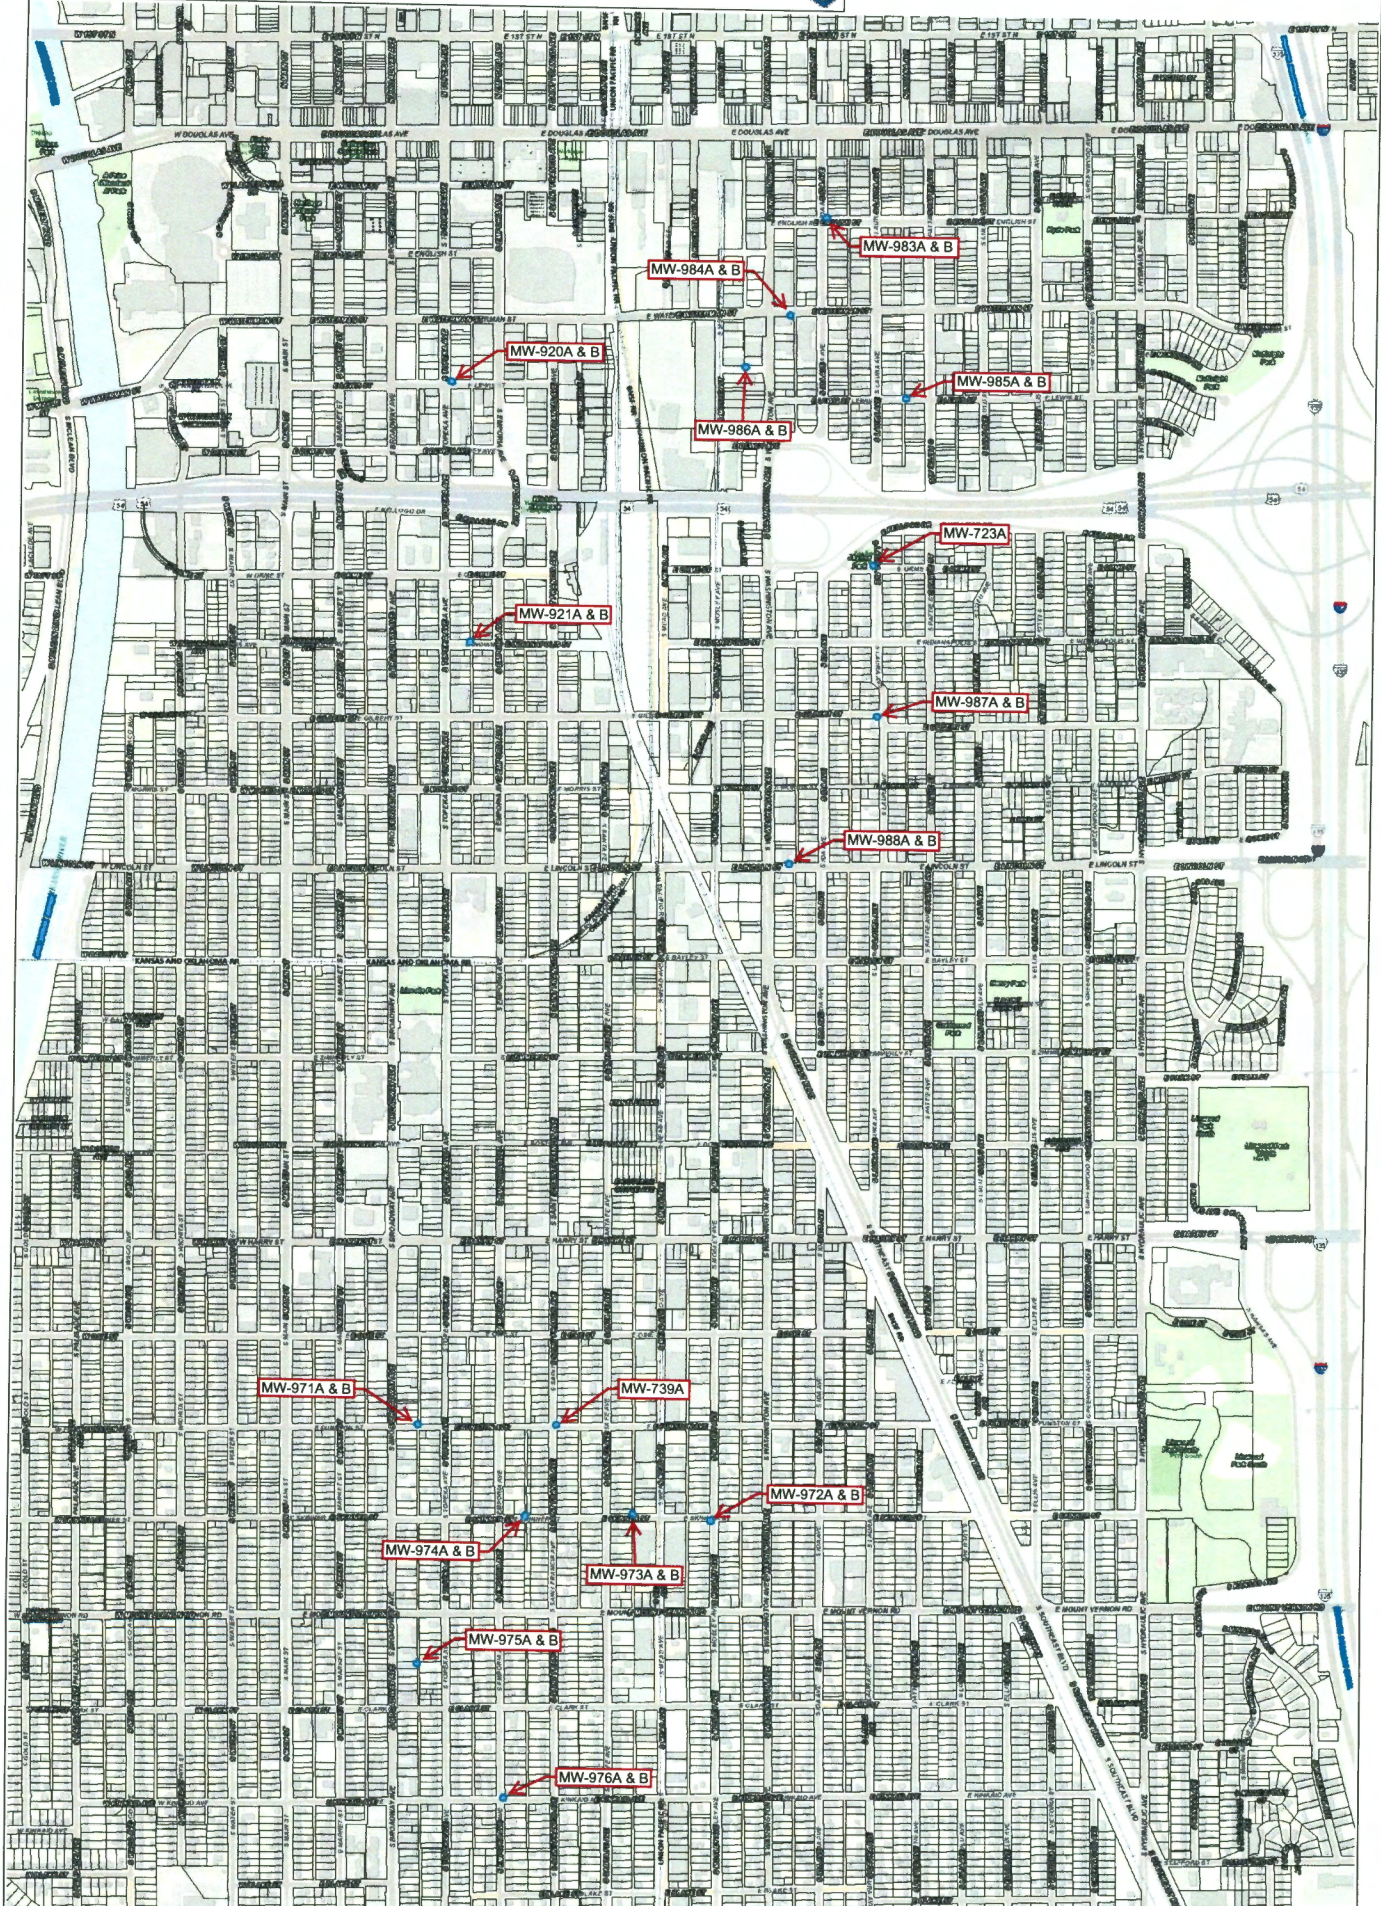


FIGURE-2
Gilbert and Mosley
New Monitoring Wells

This information is not an official record, and cannot be used as such. The user should rely only upon official records available from the custodian of records in the appropriate City and/or County department. Some data provided here and used for the preparation of these maps has been obtained from public records not created or maintained by the City of Kansas City.
Map Created On: 7/15/20 4:03 PM

□ Points
□ Address Labels
● New Single or Nested Pair Monitoring Well(s) Location

1:4,800