

WATER WELL RECORD Form WWC-5

Division of Water Resources App. No.

Well ID NMW-705

Original Record Correction Change in Well Use

1 LOCATION OF WATER WELL: County: Sedgwick Fraction NW 1/4 SW 1/4 NW 1/4 SE 1/4 Section Number 16 Township Number T 27 S Range Number R 1 E W

2 WELL OWNER: Last Name: City of Wichita/Environmental Health Business: 455 N. Main City: Wichita State: KS ZIP: 67202 Street or Rural Address where well is located: SW Corner right-of-way of E. 8th St and N. Wabash Ave. Wichita, KS

3 LOCATE WELL WITH "X" IN SECTION BOX: N W E S 1 mile

4 DEPTH OF COMPLETED WELL: 21 ft. Depth(s) Groundwater Encountered: 1) 13 ft. 2) 13.67 ft. 3) 13.67 ft. WELL'S STATIC WATER LEVEL: 13.67 ft. below land surface, measured on (mo-day-yr) 3/13/20

5 Latitude: 37.69892 Longitude: 97.32545 Horizontal Datum: WGS 84 GPS (unit make/model: Garmin c60) (WAAS enabled? Yes No) Land Survey Topographic Map Online Mapper

6 Elevation: Ground Level TOC Source: Land Survey GPS Topographic Map Other

7 WELL WATER TO BE USED AS: 1. Domestic: Household, Lawn & Garden, Livestock, Irrigation, Feedlot, Industrial. 5. Public Water Supply: well ID. 6. Dewatering: how many wells? 7. Aquifer Recharge: well ID. 8. Monitoring: well ID NMW-705. 9. Environmental Remediation: well ID. 10. Oil Field Water Supply: lease. 11. Test Hole: well ID. 12. Geothermal: how many bores? 13. Other (specify):

Was a chemical/bacteriological sample submitted to KDHE? Yes No If yes, date sample was submitted: Water well disinfected? Yes No


8 TYPE OF CASING USED: Steel PVC Other CASING JOINTS: Glued Clamped Welded Threaded Casing diameter 1.25 in. to 11 ft. Diameter 7 in. to 7 ft. Diameter 7 in. to 7 ft. Casing height above land surface 9.3 in. Weight lbs./ft. Wall thickness or gauge No. Sch. 40 TYPE OF SCREEN OR PERFORATION MATERIAL: Steel Stainless Steel Fiberglass PVC Other (Specify) Brass Galvanized Steel Concrete tile None used (open hole) SCREEN OR PERFORATION OPENINGS ARE: Continuous Slot Mill Slot Gauze Wrapped Torch Cut Drilled Holes Other (Specify) Louvered Shutter Key Punched Wire Wrapped Saw Cut None (Open Hole) SCREEN-PERFORATED INTERVALS: From 11 ft. to 21 ft. From 7 ft. to 7 ft. From 7 ft. to 7 ft. GRAVEL PACK INTERVALS: From 9 ft. to 21 ft. From 7 ft. to 7 ft. From 7 ft. to 7 ft.

9 GROUT MATERIAL: Neat cement Cement grout Bentonite Other Bentonite-Granular Grout Intervals: From 2 ft. to 7 ft. From 7 ft. to 7 ft. From 9 ft. to 9 ft. Nearest source of possible contamination: Septic Tank Lateral Lines Pit Privy Livestock Pens Insecticide Storage Sewer Lines Cess Pool Sewage Lagoon Fuel Storage Abandoned Water Well Watertight Sewer Lines Seepage Pit Feedyard Fertilizer Storage Oil Well/Gas Well Other (Specify) Direction from well? Distance from well? ft.

Table with 5 columns: 10 FROM, TO, LITHOLOGIC LOG, FROM, TO, LITHO. LOG (cont.) or PLUGGING INTERVALS. Row 1: 0, 5.5, Silty clay, , , . Row 2: 5.5, 28, Sand, , , .

Notes: Lithologic log based on Electrical Conductivity logging data.

11 CONTRACTOR'S OR LANDOWNER'S CERTIFICATION: This water well was constructed, reconstructed, or plugged under my jurisdiction and was completed on (mo-day-year) 3/13/20 and this record is true to the best of my knowledge and belief. Kansas Water Well Contractor's License No. 710 This Water Well Record was completed on (mo-day-year) 3/23/20 under the business name of Below Ground Surface, Inc. Signature

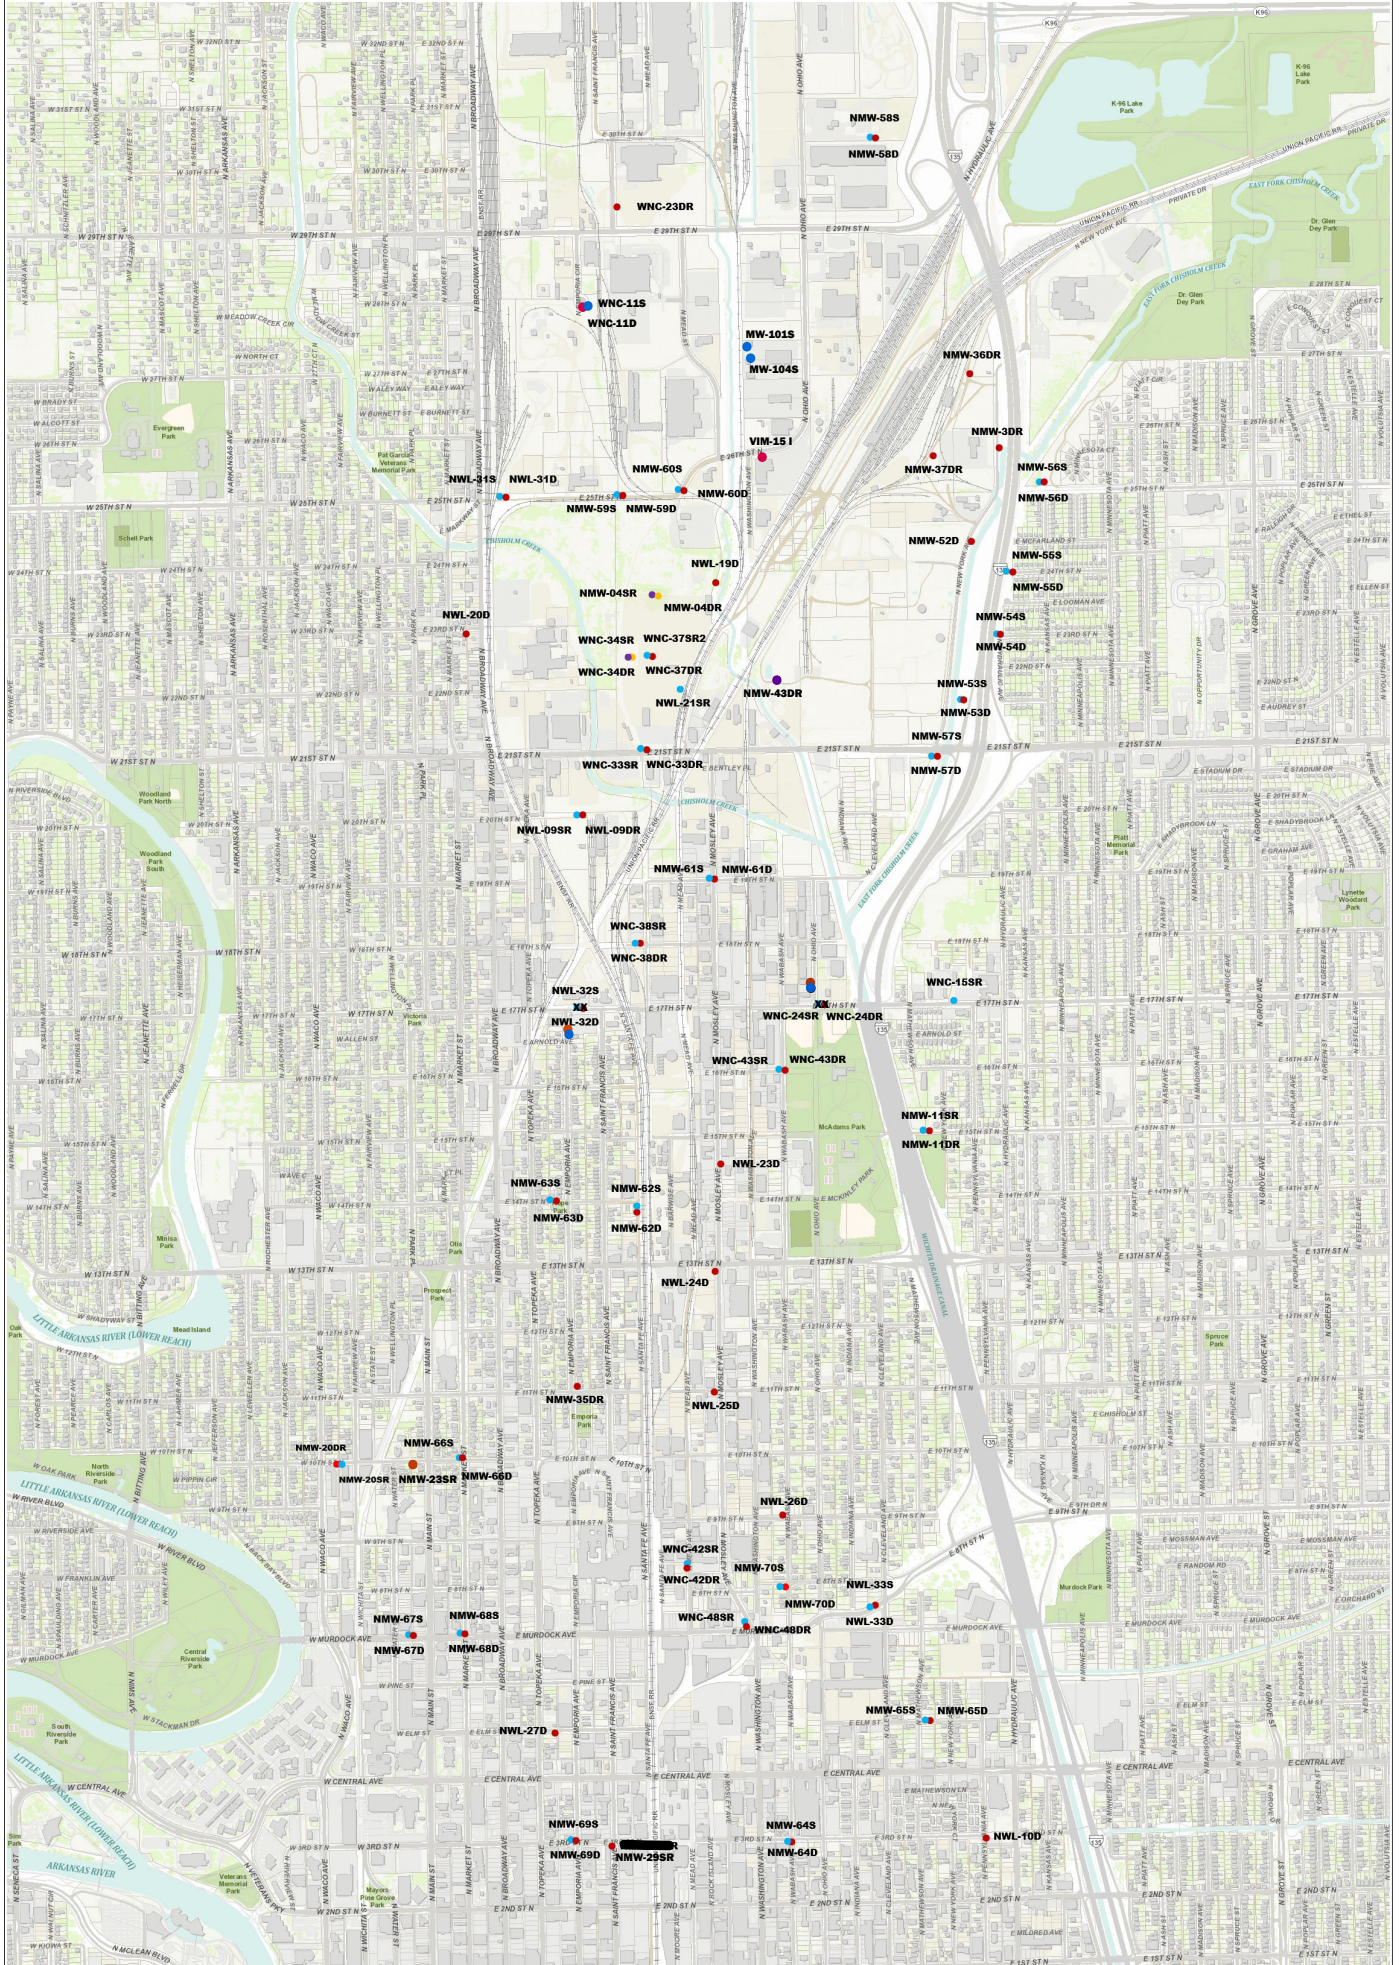

1:2000 0 600.00 1,200.00 Feet
This information is not an official record, and cannot be used as such. The user should rely only upon official records available from the custodian of records in the appropriate City and/or County department. Some data provided here was used for the preparation of these maps has been obtained from public records not created or maintained by the City of Wichita.
Map Created On: 06/19/2019 10:37 AM

- Shallow Monitoring Well with Stickup Surface Completion
- Deep Monitoring Well with Stickup Surface Completion
- Shallow Monitoring Well with Flushmount Surface Completion
- Deep Monitoring Well with Flushmount Surface Completion

1:7,200

