

WATER WELL RECORD Form WWC-5


Division of Water
Resources App. No.

Well ID **NMW-67D**

Original Record Correction Change in Well Use

1 LOCATION OF WATER WELL:
County: Sedgwick Fraction 1/4 SE 1/4 SW 1/4 NE 1/4 Section Number 17 Township Number T 27 S Range Number R 1 E W

2 WELL OWNER: Last Name: City of Wichita/Environmental Health First: Address: 455 N. Main Street or Rural Address where well is located (if unknown, distance and direction from nearest town or intersection): If at owner's address, check here: Northside right-of-way on W. Murdock Ave. approx. 100 ft. east of N. Waters St., Wichita, KS City: Wichita State: KS ZIP: 67202

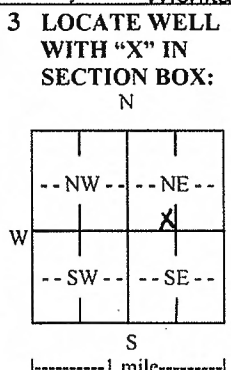

4 DEPTH OF COMPLETED WELL: 38 ft.
Depth(s) Groundwater Encountered: 1) 14 ft. 2) ft. 3) ft. or 4) Dry Well
WELL'S STATIC WATER LEVEL: 14.61 ft. TOC
 below land surface, measured on (mo-day-yr) 2/20/2020
 above land surface, measured on (mo-day-yr)
Pump test data: Well water was ft. after hours pumping gpm
Well water was ft. after hours pumping gpm
Estimated Yield: gpm
Bore Hole Diameter: 3.25 in. to 38 ft. and in. to ft.

5 Latitude: 37.697611 (decimal degrees)
Longitude: 97.338888 (decimal degrees)
Horizontal Datum: WGS 84 NAD 83 NAD 27
Source for Latitude/Longitude:
 GPS (unit make/model: Garmin c60) (WAAS enabled? Yes No)
 Land Survey Topographic Map
 Online Mapper:

6 Elevation: ft. Ground Level TOC
Source: Land Survey GPS Topographic Map
 Other

7 WELL WATER TO BE USED AS:
1. Domestic: Household Lawn & Garden Livestock
2. Irrigation
3. Feedlot
4. Industrial
5. Public Water Supply: well ID
6. Dewatering: how many wells?
7. Aquifer Recharge: well ID
8. Monitoring: well ID NMW-67D
9. Environmental Remediation: well ID
 Air Sparge Soil Vapor Extraction
 Recovery Injection
10. Oil Field Water Supply: lease
11. Test Hole: well ID
 Cased Uncased Geotechnical
12. Geothermal: how many bores?
a) Closed Loop Horizontal Vertical
b) Open Loop Surface Discharge Inj. of Water
13. Other (specify):

Was a chemical/bacteriological sample submitted to KDHE? Yes No If yes, date sample was submitted:
Water well disinfected? Yes No

8 TYPE OF CASING USED: Steel PVC Other CASING JOINTS: Glued Clamped Welded Threaded
Casing diameter 1.25 in. to 2.9 ft., Diameter in. to ft., Diameter in. to ft.
Casing height above land surface 0.3 in. Weight lbs./ft. Wall thickness or gauge No. Sch. 40

TYPE OF SCREEN OR PERFORATION MATERIAL:
 Steel Stainless Steel Fiberglass PVC Other (Specify)
 Brass Galvanized Steel Concrete tile None used (open hole)

SCREEN OR PERFORATION OPENINGS ARE:
 Continuous Slot Mill Slot Gauze Wrapped Torch Cut Drilled Holes Other (Specify)
 Louvered Shutter Key Punched Wire Wrapped Saw Cut None (Open Hole)

SCREEN-PERFORATED INTERVALS: From 2.8 ft. to 3.8 ft. From ft. to ft., From ft. to ft.
GRAVEL PACK INTERVALS: From 2.4 ft. to 3.8 ft. From ft. to ft., From ft. to ft.

9 GROUT MATERIAL: Neat cement Cement grout Bentonite Other
Grout Intervals: From 2 ft. to 2.4 ft., From ft. to ft., From ft. to ft.


Nearest source of possible contamination:
 Septic Tank Lateral Lines Pit Privy Livestock Pens Insecticide Storage
 Sewer Lines Cess Pool Sewage Lagoon Fuel Storage Abandoned Water Well
 Watertight Sewer Lines Seepage Pit Feedyard Fertilizer Storage Oil Well/Gas Well
 Other (Specify)

Direction from well? Distance from well? ft.

10 FROM	TO	LITHOLOGIC LOG	FROM	TO	LITHO. LOG (cont.) or PLUGGING INTERVALS
0	9	Silty Clay			
9	38	Sand			
38	-	Shale			

Notes: Lithologic log based on Electrical Conductivity logging data.

11 CONTRACTOR'S OR LANDOWNER'S CERTIFICATION: This water well was constructed, reconstructed, or plugged under my jurisdiction and was completed on (mo-day-year) 2/20/2020 and this record is true to the best of my knowledge and belief. Kansas Water Well Contractor's License No. 710 This Water Well Record was completed on (mo-day-year) 3/10/2020 under the business name of Below Ground Surface, Inc. Signature [Signature]

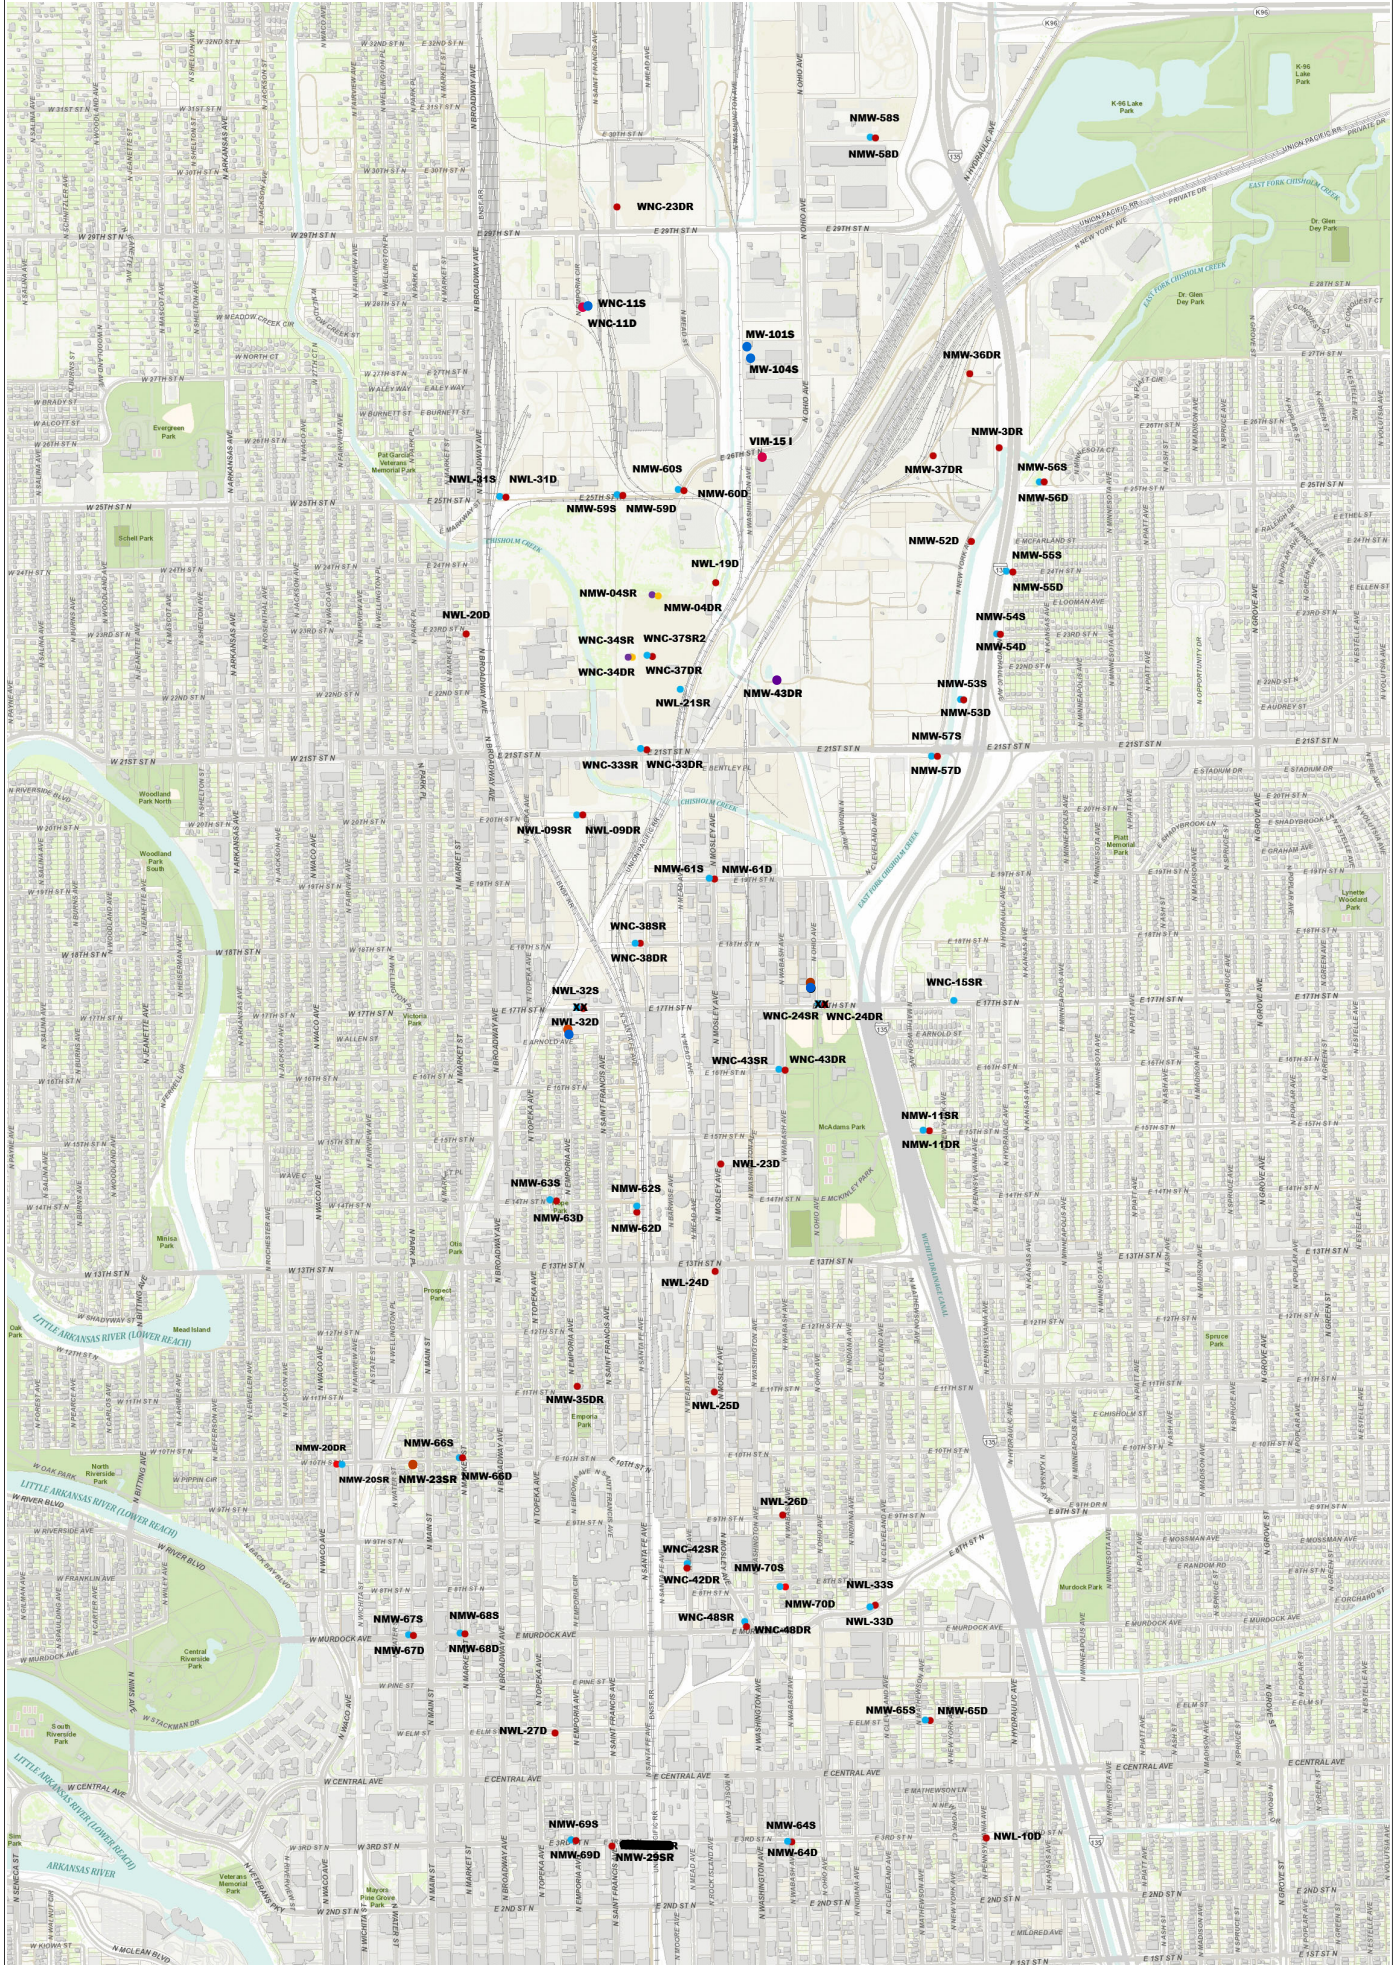

1:2000 0 600.00 1,200.00 Feet
This information is not an official record, and cannot be used as such. The user should rely only upon official records available from the custodian of records in the appropriate City and/or County department. Some data provided here was used for the preparation of these maps has been obtained from public records not created or maintained by the City of Wichita.
Map Created On: 06/19 10:37 AM

- Shallow Monitoring Well with Stickup Surface Completion
- Deep Monitoring Well with Stickup Surface Completion
- Shallow Monitoring Well with Flushmount Surface Completion
- Deep Monitoring Well with Flushmount Surface Completion

1:7,200

