

WATER WELL RECORD Form WWC-5

Division of Water Resources App. No.

MW-11

Original Record Correction Change in Well Use

Well ID

1 LOCATION OF WATER WELL: County: Sedgwick	Fraction ¼ SW ¼ SW ¼ SW ¼	Section Number 36	Township Number T 27 S	Range Number R 1 E W
---	------------------------------	-----------------------------	----------------------------------	--------------------------------

2 WELL OWNER: Last Name: QuikTrip Corporation Business: QuikTrip Corporation Address: 4705 S. 129th East Avenue Address: City: Tulsa State: OK ZIP: 74134	Street or Rural Address where well is located (if unknown, distance and direction from nearest town or intersection): If at owner's address, check here: <input type="checkbox"/> Froggy's Liquour (Formerly QuikTrip #312) 2336 South Oliver Avenue, Wichita, KS 67218
--	---

3 LOCATE WELL WITH "X" IN SECTION BOX:
N

NW	NE
SW	SE

S

1 mile

4 DEPTH OF COMPLETED WELL: **20.0** ft.

Depth(s) Groundwater Encountered: 1) **14** ft.
2) ft. 3) ft., or 4) Dry Well

WELL'S STATIC WATER LEVEL: **13.92** ft.
 below land surface, measured on (mo-day-yr) **12-6-2022**
 above land surface, measured on (mo-day-yr)

Pump test data: Well water was ft.
after hours pumping gpm
Well water was ft.
after hours pumping gpm

Estimated Yield: gpm
Bore Hole Diameter: **8.25** in. to **20.0** ft. and
..... in. to ft.

5 Latitude: **37.65064** (decimal degrees)
Longitude: **-97.28019** (decimal degrees)
Horizontal Datum: WGS 84 NAD 83 NAD 27
Source for Latitude/Longitude:
 GPS (unit make/model:)
(WAAS enabled? Yes No)
 Land Survey Topographic Map
 Online Mapper: **Google Earth**

6 Elevation: **1314** ft. Ground Level TOC
Source: Land Survey GPS Topographic Map
 Other **Google Earth**

7 WELL WATER TO BE USED AS:

1. Domestic: <input type="checkbox"/> Household <input type="checkbox"/> Lawn & Garden <input type="checkbox"/> Livestock <input type="checkbox"/> Irrigation <input type="checkbox"/> Feedlot <input type="checkbox"/> Industrial	5. <input type="checkbox"/> Public Water Supply: well ID	10. <input type="checkbox"/> Oil Field Water Supply: lease
2. <input type="checkbox"/> Irrigation	6. <input type="checkbox"/> Dewatering: how many wells?	11. Test Hole: well ID
3. <input type="checkbox"/> Feedlot	7. <input type="checkbox"/> Aquifer Recharge: well ID	<input type="checkbox"/> Cased <input type="checkbox"/> Uncased <input type="checkbox"/> Geotechnical
4. <input type="checkbox"/> Industrial	8. <input checked="" type="checkbox"/> Monitoring: well ID MW-11	12. Geothermal: how many bores?
	9. Environmental Remediation: well ID	a) Closed Loop <input type="checkbox"/> Horizontal <input type="checkbox"/> Vertical b) Open Loop <input type="checkbox"/> Surface Discharge <input type="checkbox"/> Inj. of Water
	<input type="checkbox"/> Air Sparge <input type="checkbox"/> Soil Vapor Extraction <input type="checkbox"/> Recovery <input type="checkbox"/> Injection	13. <input type="checkbox"/> Other (specify):

Was a chemical/bacteriological sample submitted to KDHE? Yes No If yes, date sample was submitted:

Water well disinfected? Yes No

8 TYPE OF CASING USED: Steel PVC Other

Casing diameter **2** in. to **10.0** ft., Diameter in. to ft., Diameter in. to ft.

Casing height above land surface **0** in. Weight lbs./ft. Wall thickness or gauge No. **Sch. 40**

TYPE OF SCREEN OR PERFORATION MATERIAL:
 Steel Stainless Steel Fiberglass PVC Other (Specify)

Brass Galvanized Steel Concrete tile None used (open hole)

SCREEN OR PERFORATION OPENINGS ARE:
 Continuous Slot Mill Slot Gauze Wrapped Torch Cut Drilled Holes Other (Specify)

Louvered Shutter Key Punched Wire Wrapped Saw Cut None (Open Hole)

SCREEN-PERFORATED INTERVALS: From **10.0** ft. to **20.0** ft., From ft. to ft., From ft. to ft.

GRAVEL PACK INTERVALS: From **8.0** ft. to **20.0** ft., From ft. to ft., From ft. to ft.

9 GROUT MATERIAL: Neat cement Cement grout Bentonite Other **Concrete 0-2 feet**

Grout Intervals: From **2.0** ft. to **8.0** ft., From ft. to ft., From ft. to ft.

Nearest source of possible contamination:
 Septic Tank Lateral Lines Pit Privy Livestock Pens Insecticide Storage
 Sewer Lines Cess Pool Sewage Lagoon Fuel Storage Abandoned Water Well
 Watertight Sewer Lines Seepage Pit Feedyard Fertilizer Storage Oil Well/Gas Well
 Other (Specify)


Direction from well? **Southeast** Distance from well? **65.0** ft.

10 FROM	TO	LITHOLOGIC LOG	FROM	TO	LITHO. LOG (cont.) or PLUGGING INTERVALS
0	1	Asphalt/Fill			
1	20	Brown clay			

11 CONTRACTOR'S OR LANDOWNER'S CERTIFICATION: This water well was constructed, reconstructed, or plugged under my jurisdiction and was completed on (mo-day-year) **12-5-2022** and this record is true to the best of my knowledge and belief. Kansas Water Well Contractor's License No. **759** This Water Well Record was completed on (mo-day-year) **12-7-2022** under the business name of **RAZEK Environmental, LLC** Signature *[Signature]*

LEGEND:

- - EXISTING MONITORING WELL
- ⊗ - PLUGGED WELL
- - DESTROYED WELL
- - UNDERGROUND UTILITIES
- - OVERHEAD UTILITIES

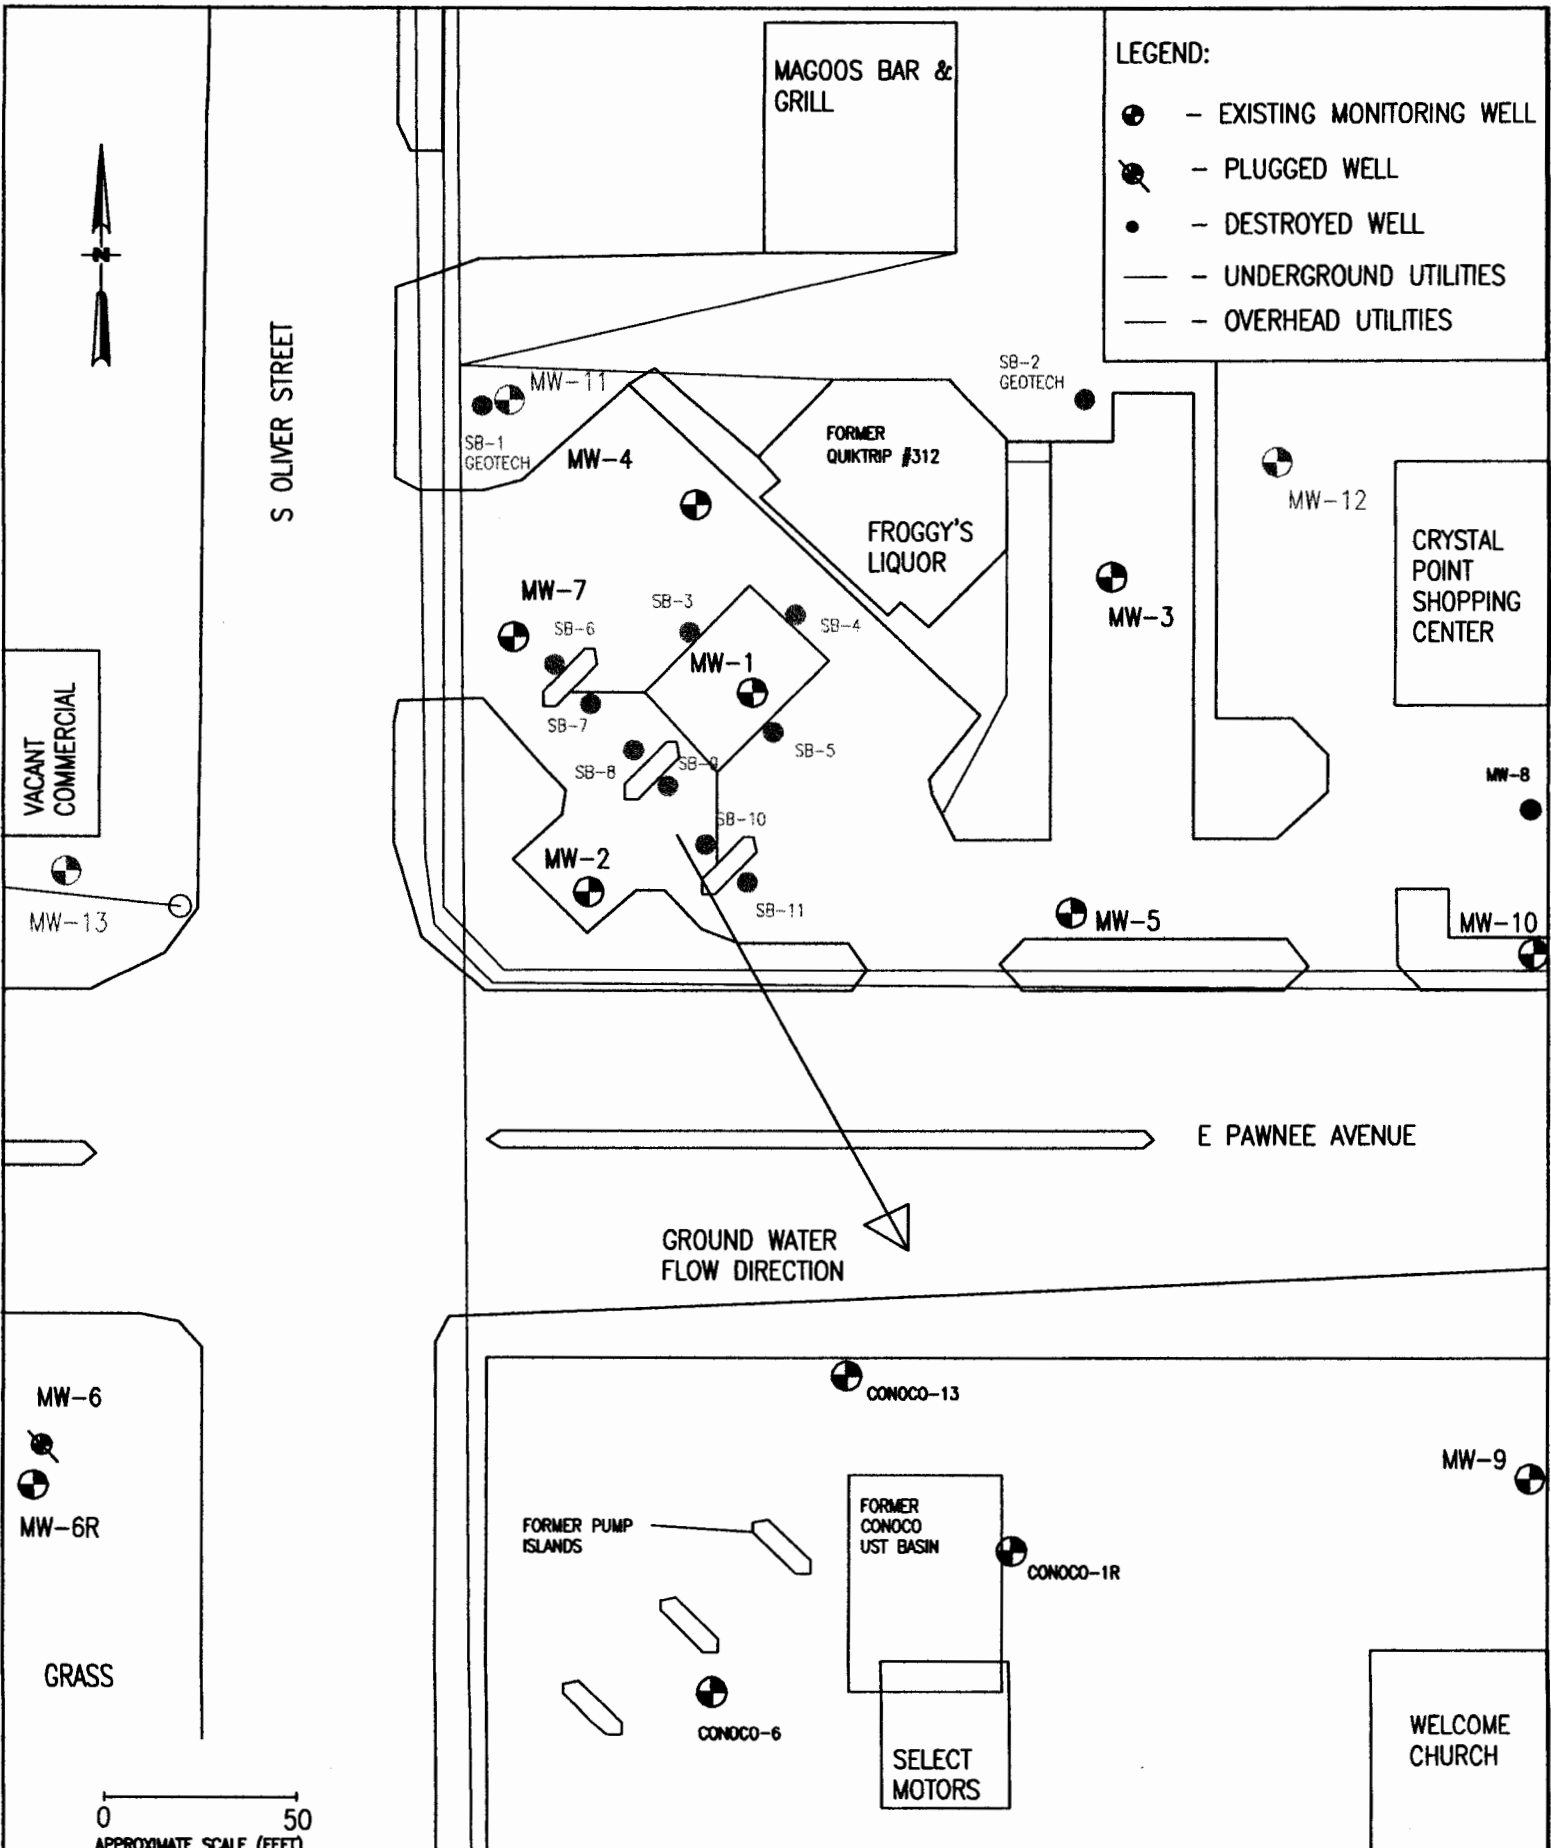

PROJ.# 17102733	PAGE#
SCALE: AS SHOWN	DRAWN BY: MW
FILE NO. 2733-F2	DESIGNED BY:
DATE: 08/31/22	APPROVED BY:



f27 R1E
Sec. 35:36
Sedgwich
County

FIGURE 2
 SITE MAP
 QUIK TRIP #312
 U2-287-10558
 2336 S OLIVER
 WICHITA, KANSAS