

WATER WELL RECORD

Form WWC-5

Division of Water Resources App. No.

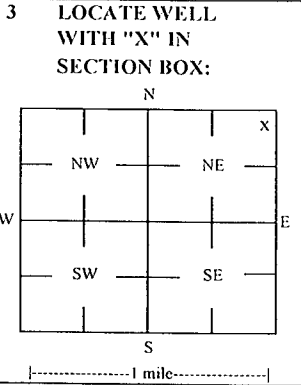
Well ID

MW23

Original Record Correction Change in Well Use

1 LOCATION OF WATER WELL: County Sedgwick Fraction NE 1/4 NE 1/4 NE 1/4 NE 1/4 Section Number 19 Township Number T 27 S Range Number R 2 E W

2 WELL OWNER: Last Name: First: Street or Rural Address where well is located (if unknown, distance and direction from nearest town or intersection): If at owner's address, check here: Business: El Paso Remediatin Company Address: 1001 Louisiana St. Room 757C City Houston State: TX ZIP: 77002



4 DEPTH OF COMPLETED WELL: 16.5 ft Depth(s) Groundwater Encountered: 1) 16.5 ft 2) ft 3) ft, or 4) Dry Well WELL'S STATIC WATER LEVEL: 10.17 ft. X below land surface, measured on (mo-day-yr) 5/11/20

5 Latitude: 37.69305 (decimal degrees) Longitude: 97.24475 (decimal degrees) Horizontal Datum: X WGS 84 Source for Latitude/Longitude: X Land Survey

7 WELL WATER TO BE USED AS: 1 Domestic: Household, Lawn & Garden, Livestock, Irrigation, Feedlot, Industrial. 5 Public Water Supply: well ID. 6 Dewatering: how many wells? 7 Aquifer Recharge: well ID. 8 Monitoring: well ID MW23. 9 Environmental Remediation: well ID. 10 Oil Field Water Supply: lease. 11 Test Hole: well ID. 12 Geothermal: How many bores?

Was a chemical/bacteriological sample submitted to KDHE? Yes No X No If yes, date sample was submitted: Water well disinfected? Yes No X No

8 TYPE OF CASING USED: Steel PVC Other CASING JOINTS: Glued Clamped Welded X Threaded Casing diameter 2 in. to 6.5 ft, Diameter in. to ft, Diameter in. to ft, Casing height above land surface -0.4 in. Weight lbs./ft. Well thickness or gauge No. TYPE OF SCREEN OR PERFORATION MATERIAL: Steel Stainless Steel Fiberglass X PVC Other (Specify) SCREEN OR PERFORATION OPENINGS ARE: Continuous Slot X Mill Slot Gauze Wrapped Torch Cut Drilled Holes Other (Specify) Louvered Shutter Key Punched Wire Wrapped Saw Cut None (Open Hole) SCREEN-PERFORATED INTERVALS: From 6.5 ft. to 16.5 ft. GRAVEL PACK INTERVALS: From 4.5 ft. to 16.5 ft.

9 GROUT MATERIAL: Neat cement Cement grout X Bentonite X Other Concrete: 0-0.5' Grout intervals: From 0.5 ft. to 4.5 ft. From ft. to ft. From ft. to ft.

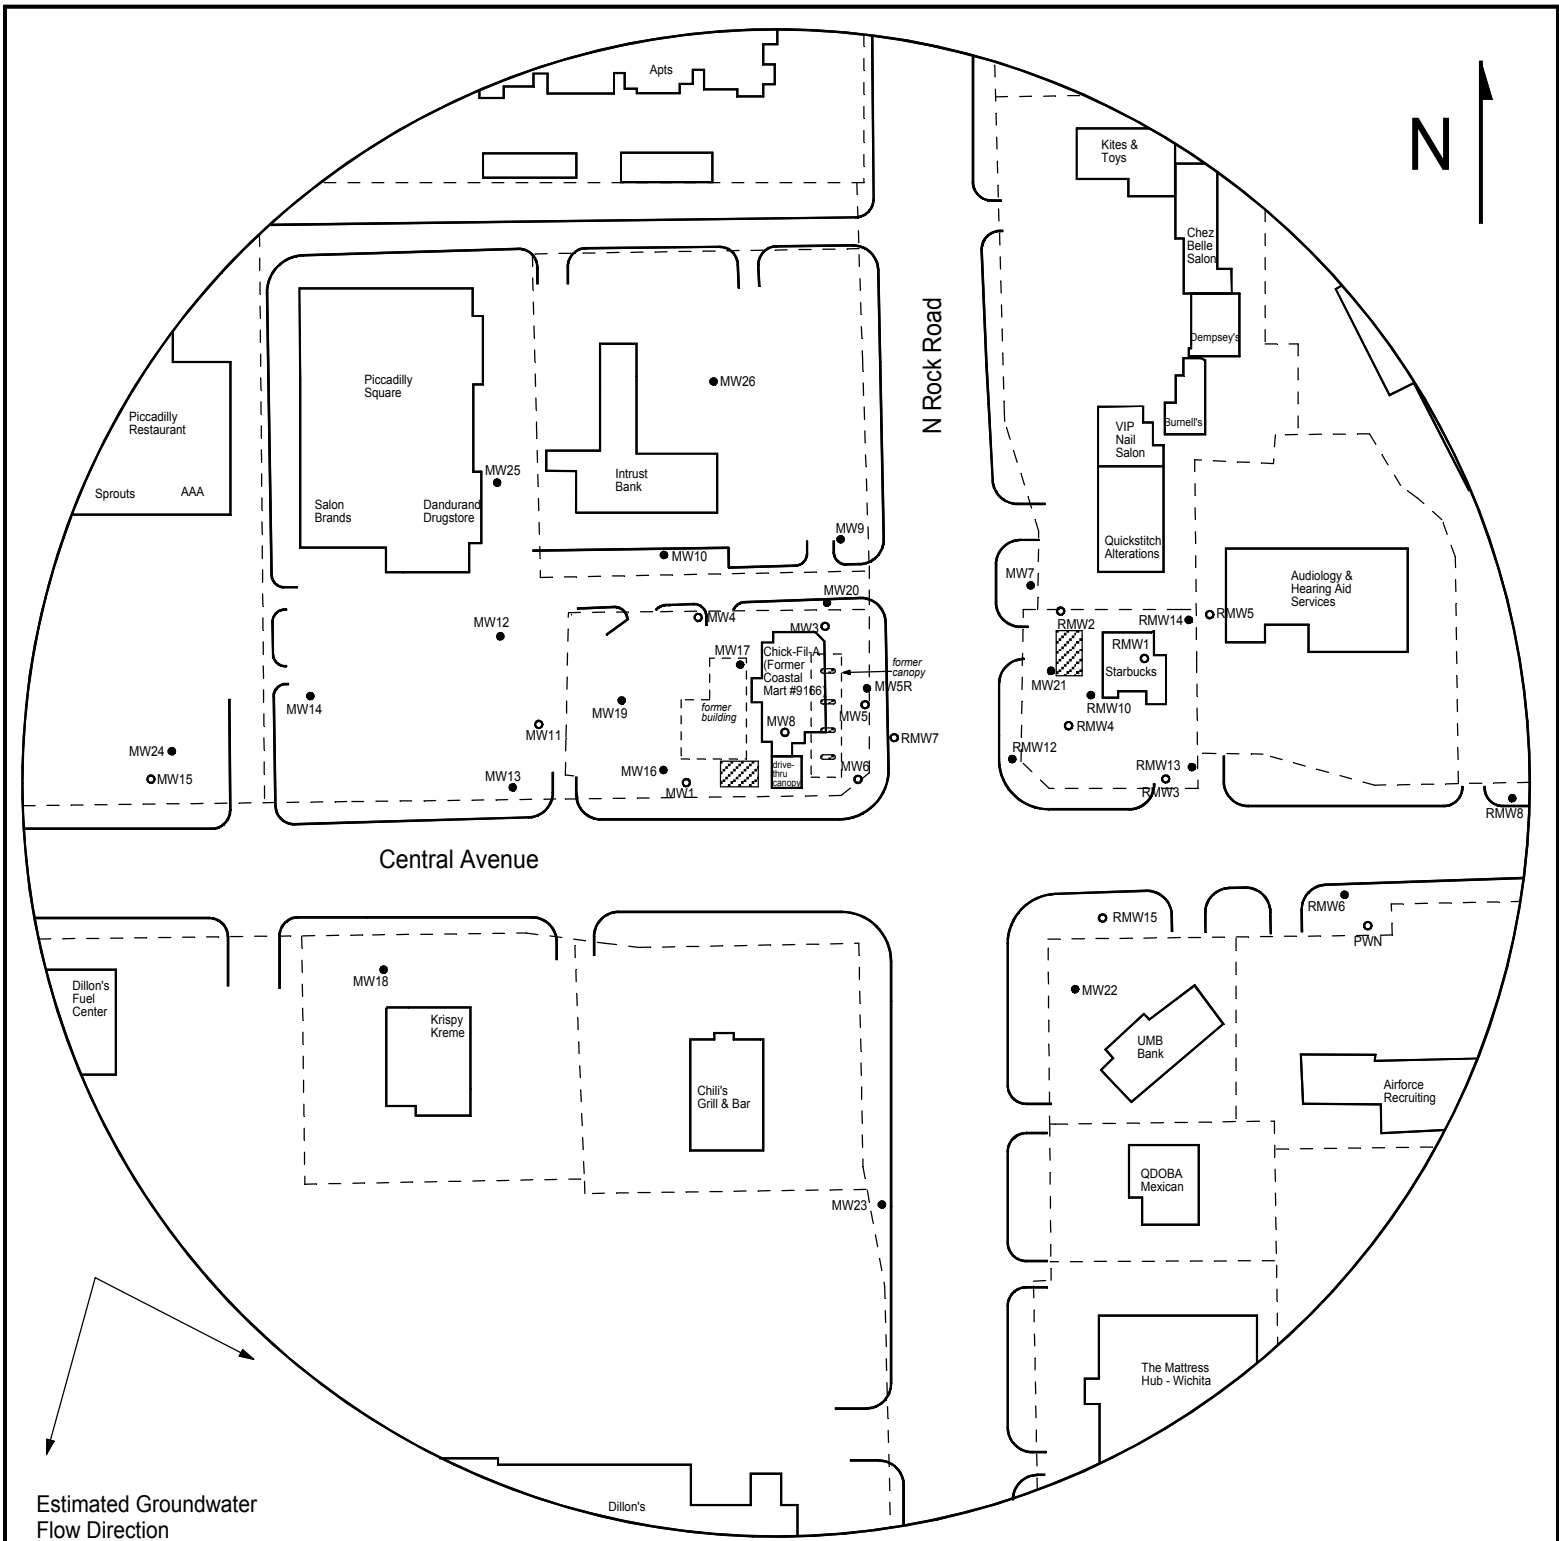
Nearest source of possible contamination: Septic Tank Lateral Lines Pit Privy Livestock Pens Insecticide Storage Sewer Lines Cess Pool Sewage Lagoon X Fuel Storage Abandoned Water Well Watertight Sewer Lines Seepage Pit Feedyard Fertilizer Storage Oil Well / Gas Well Other (Specify) Direction from well? Unknown Distance from well? Unknown ft

10 FROM TO LITHOLOGIC LOG FROM TO LITHO. LOG (cont.) or PLUGGING INTERVALS

0	0.5	Grass/topsoil			
0.5	8	Silty clay			
8	16.5	Fine sandy clay			

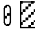
 


Notes: KDHE ID: Coastal Mart #9166; U2-087-13081 Target of monitoring well is shallow groundwater, <20' of grout was installed at the direction of KDHE.

11 CONTRACTOR'S OR LANDOWNER'S CERTIFICATION: This water well was X constructed, reconstructed, or plugged under my jurisdiction and was completed on (mo-day-year) 5/4/20 and this record is true to the best of my knowledge and belief. Kansas Water Well Contractor's License No 757 This Water Well Record was completed on (mo-day-year) 6/11/20 under the business name of Larsen & Associates, Inc. Signature



Estimated Groundwater Flow Direction

LEGEND

-  Approximate Location of Former UST Basin & Pump Islands
-  Approximate Location of Property Line
-  Existing Monitoring Well
-  Plugged Well

PROJECT:

Coastal Mart #9166
 7990 E Central
 Wichita, KS
 KDHE ID: U2-087-13081
 Date: 9/21/20



1311 E 25th St., Suite B
 Lawrence, KS 66046

785-841-8707 office
 785-865-4282 fax

NOTE: RMW wells are associated with Rock Road 66; U2-087-12613