

WATER WELL RECORD Form WWC-5

Original Record Correction Change in Well Use

Division of Water Resources App. No.

Well ID

Well ID

1 LOCATION OF WATER WELL: County: Fraction Section Number Township Number Range Number

2 WELL OWNER: Last Name: Business: Address: City: State: ZIP: Street or Rural Address where well is located

3 LOCATE WELL WITH "X" IN SECTION BOX: NW NE SW SE

4 DEPTH OF COMPLETED WELL: Depth(s) Groundwater Encountered: WELL'S STATIC WATER LEVEL: Pump test data: Estimated Yield: Bore Hole Diameter:

5 Latitude: Longitude: Datum: Source for Latitude/Longitude: 6 Elevation: Source:

7 WELL WATER TO BE USED AS: 1. Domestic: 2. Irrigation: 3. Feedlot: 4. Industrial: 5. Public Water Supply: 6. Dewatering: 7. Aquifer Recharge: 8. Monitoring: 9. Environmental Remediation: 10. Oil Field Water Supply: 11. Test Hole: 12. Geothermal: 13. Other

Was a chemical/bacteriological sample submitted to KDHE? Water well disinfected?



8 TYPE OF CASING USED: CASING JOINTS: TYPE OF SCREEN OR PERFORATION MATERIAL: SCREEN OR PERFORATION OPENINGS ARE: SCREEN-PERFORATED INTERVALS: GRAVEL PACK INTERVALS:

9 GROUT MATERIAL: Grout Intervals: Nearest source of possible contamination: Direction from well? Distance from well?

Table with 6 columns: FROM, TO, LITHOLOGIC LOG, FROM, TO, LITHO. LOG (cont.) or PLUGGING INTERVALS

11 CONTRACTOR'S OR LANDOWNER'S CERTIFICATION: This water well was constructed, reconstructed, or plugged under my jurisdiction and was completed on (mo-day-year) and this record is true to the best of my knowledge and belief.

W. 7th Avenue (Highway 54)

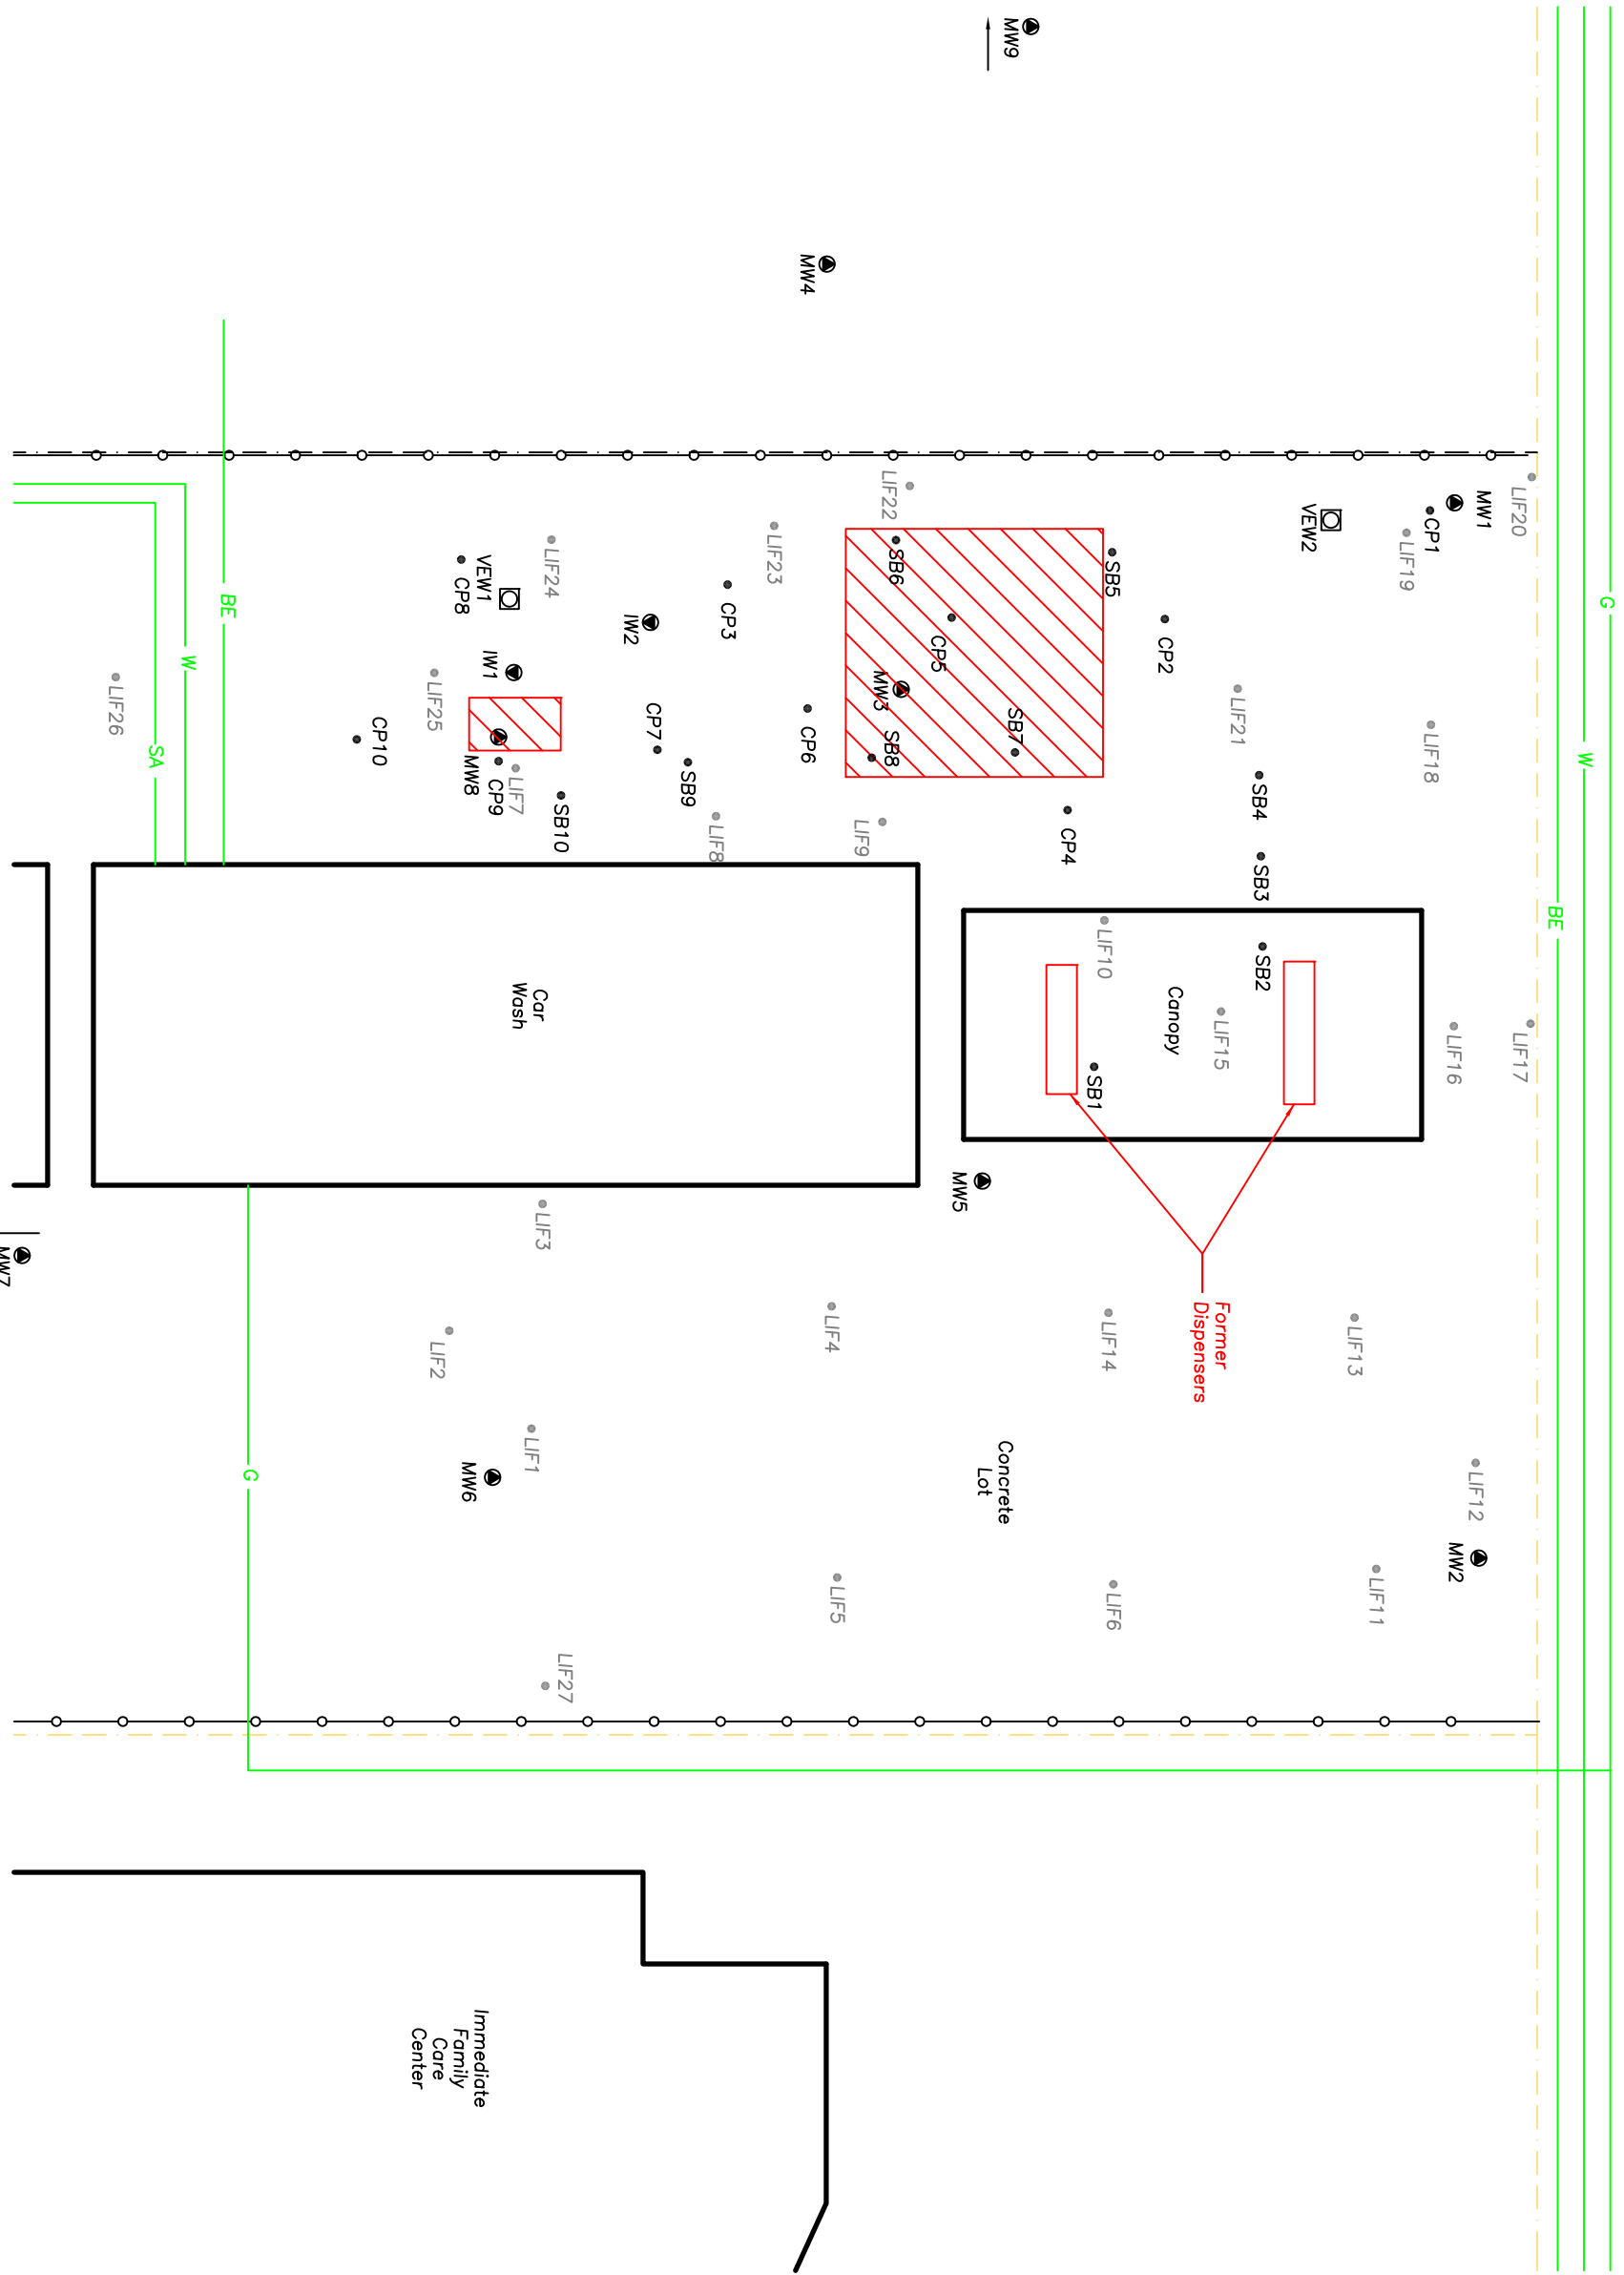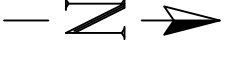

Legend

- MW1 – Monitoring Well Location
- “PMW” Wells Associated with Pemco #244
- ☐ VEW1 – Multi-Phase Extraction Well
- ☐ VEW2 – Air Sparge Well
- IW1 – Continuous Probe Location (CGP 2019)
- LIF1 – Laser Induced Fluorescence Probe (SCS 2017)
- SB1 – Soil Probe Location (SCS 2017)
- ▨ – Former UST
- — — Property Line
- Clark – Property Owner Name
- OH — Overhead Power Line
- SA — Sanitary Sewer Line (~4’ deep)
- FO — Fiber Optic (~3’ Deep)
- W — Water Line (~4’ deep)
- G — Gas Line (~3’ deep)
- BT — Buried Telephone (~2’ deep)
- ST — Storm Sewer (Culvert) (~1’ deep)
- PP ● — Power Pole
- LP ● — Light Pole
- MH ● — Manhole
- Ped ● — Phone Pedestal
- WM ● — Water Meter
- FH ● — Fire Hydrant
- CO ● — Clean Out
- — Tree



Site Detail Map
Moore Washes
Augusta, Kansas
KDHE Project Code: U2-008-13132
Remedial Design Report
CGP Project #18852K
Prepared By: MK Date: 04-06-2021
Reviewed By: MK Date: 04-06-2021
Figure 1.4
CGP, Inc. P0 Box 23, Wahoo, NE 68066

Immediate Family Care Center

Car Wash

Concrete Lot

Former Dispensers