

WATER WELL RECORD Form WWC-5

Division of Water Resources App. No.

MW-11R

Original Record Correction Change in Well Use

Well ID

1 LOCATION OF WATER WELL: County: Sedgwick Fraction NW 1/4 SW 1/4 SW 1/4 SW 1/4 Section Number 32 Township Number T 28 S Range Number R 1 E W

2 WELL OWNER: Last Name: KDHE-BER First: Street or Rural Address where well is located (if unknown, distance and direction from nearest town or intersection): 140 North Main Street, Haysville, Ks.

3 LOCATE WELL WITH 'X' IN SECTION BOX: 4 DEPTH OF COMPLETED WELL: 25 ft. 5 Latitude: 37.565382 Longitude: -97.352005

7 WELL WATER TO BE USED AS: 1. Domestic: 2. Irrigation 3. Feedlot 4. Industrial 5. Public Water Supply: well ID 6. Dewatering: how many wells? 7. Aquifer Recharge: well ID 8. Monitoring: well ID MW-11R 9. Environmental Remediation: well ID 10. Oil Field Water Supply: lease 11. Test Hole: well ID 12. Geothermal: how many bores? 13. Other (specify):

Was a chemical/bacteriological sample submitted to KDHE? No If yes, date sample was submitted: Water well disinfected? No

8 TYPE OF CASING USED: PVC CASING JOINTS: Threaded Casing diameter: 2 in. to 10 ft., Diameter: in. to ft., Diameter: in. to ft. Casing height above land surface: 0 in. Weight: lbs./ft. Wall thickness or gauge No. sch 40


9 GROUT MATERIAL: Cement grout Bentonite Other Cement pad Grout Intervals: From 1 ft. to 8 ft., From 0 ft. to 1 ft., From ft. to ft., From ft. to ft.

Nearest source of possible contamination: Contaminated Site Direction from well? Distance from well? ft.

Table with 6 columns: 10 FROM, TO, LITHOLOGIC LOG, FROM, TO, LITHO. LOG (cont.) or PLUGGING INTERVALS. Rows show sand and sandy clay layers.


11 CONTRACTOR'S OR LANDOWNER'S CERTIFICATION: This water well was constructed, reconstructed, or plugged under my jurisdiction and was completed on (mo-day-year) 9-16-2022 and this record is true to the best of my knowledge and belief.

N. MAIN STREET

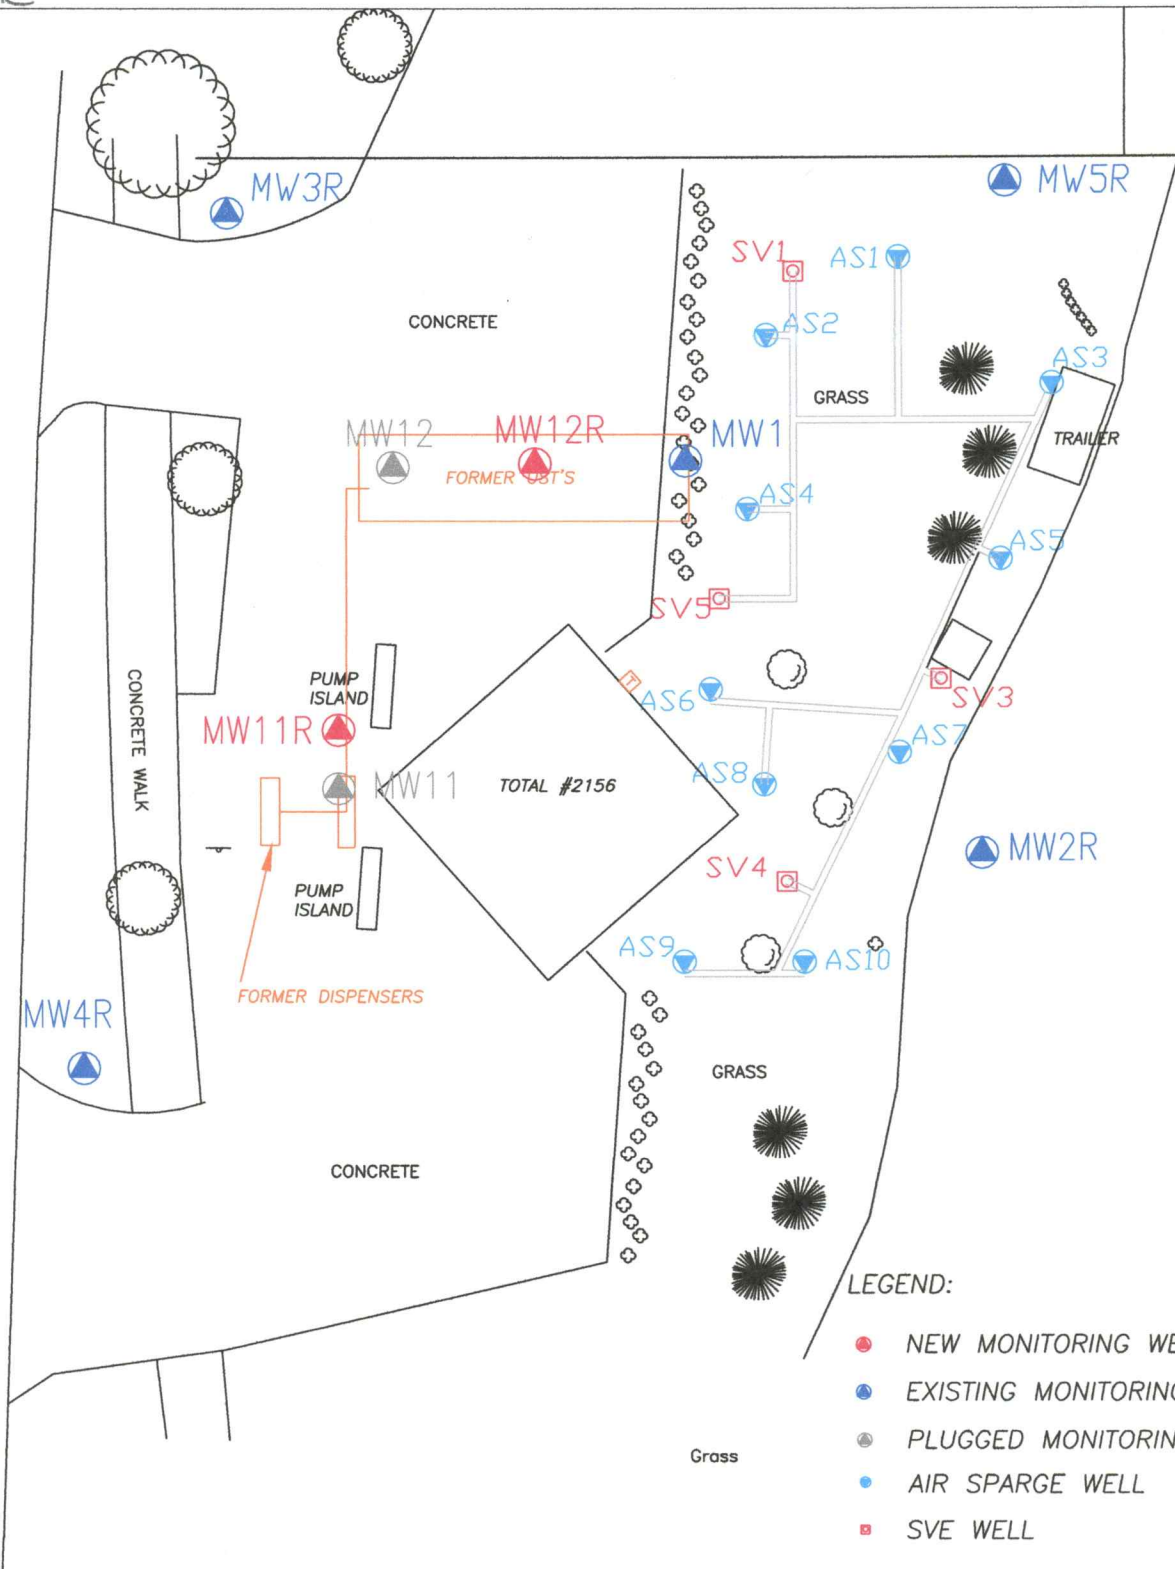

LEGEND:



- NEW MONITORING WELL
- EXISTING MONITORING WELL
- PLUGGED MONITORING WELL
- AIR SPARGE WELL
- SVE WELL

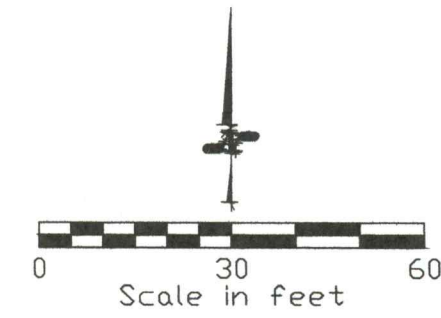

**SCS ENGINEERS**  
 ENVIRONMENTAL CONSULTANTS AND CONTRACTORS  
 8575 West 110th Street  
 Overland Park, Kansas 66210

**New Monitor Wells**  
**Total #2156**  
 140 North Main  
 Haysville, Kansas

Project Mgr. SLM	Date 9/28/2022	KDHE Code: U2-087-01320	Project No. 27217283.01
Scale: NOT TO SCALE		File Name Total #2156.dwg	Figure

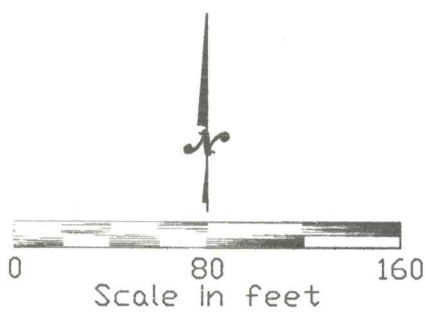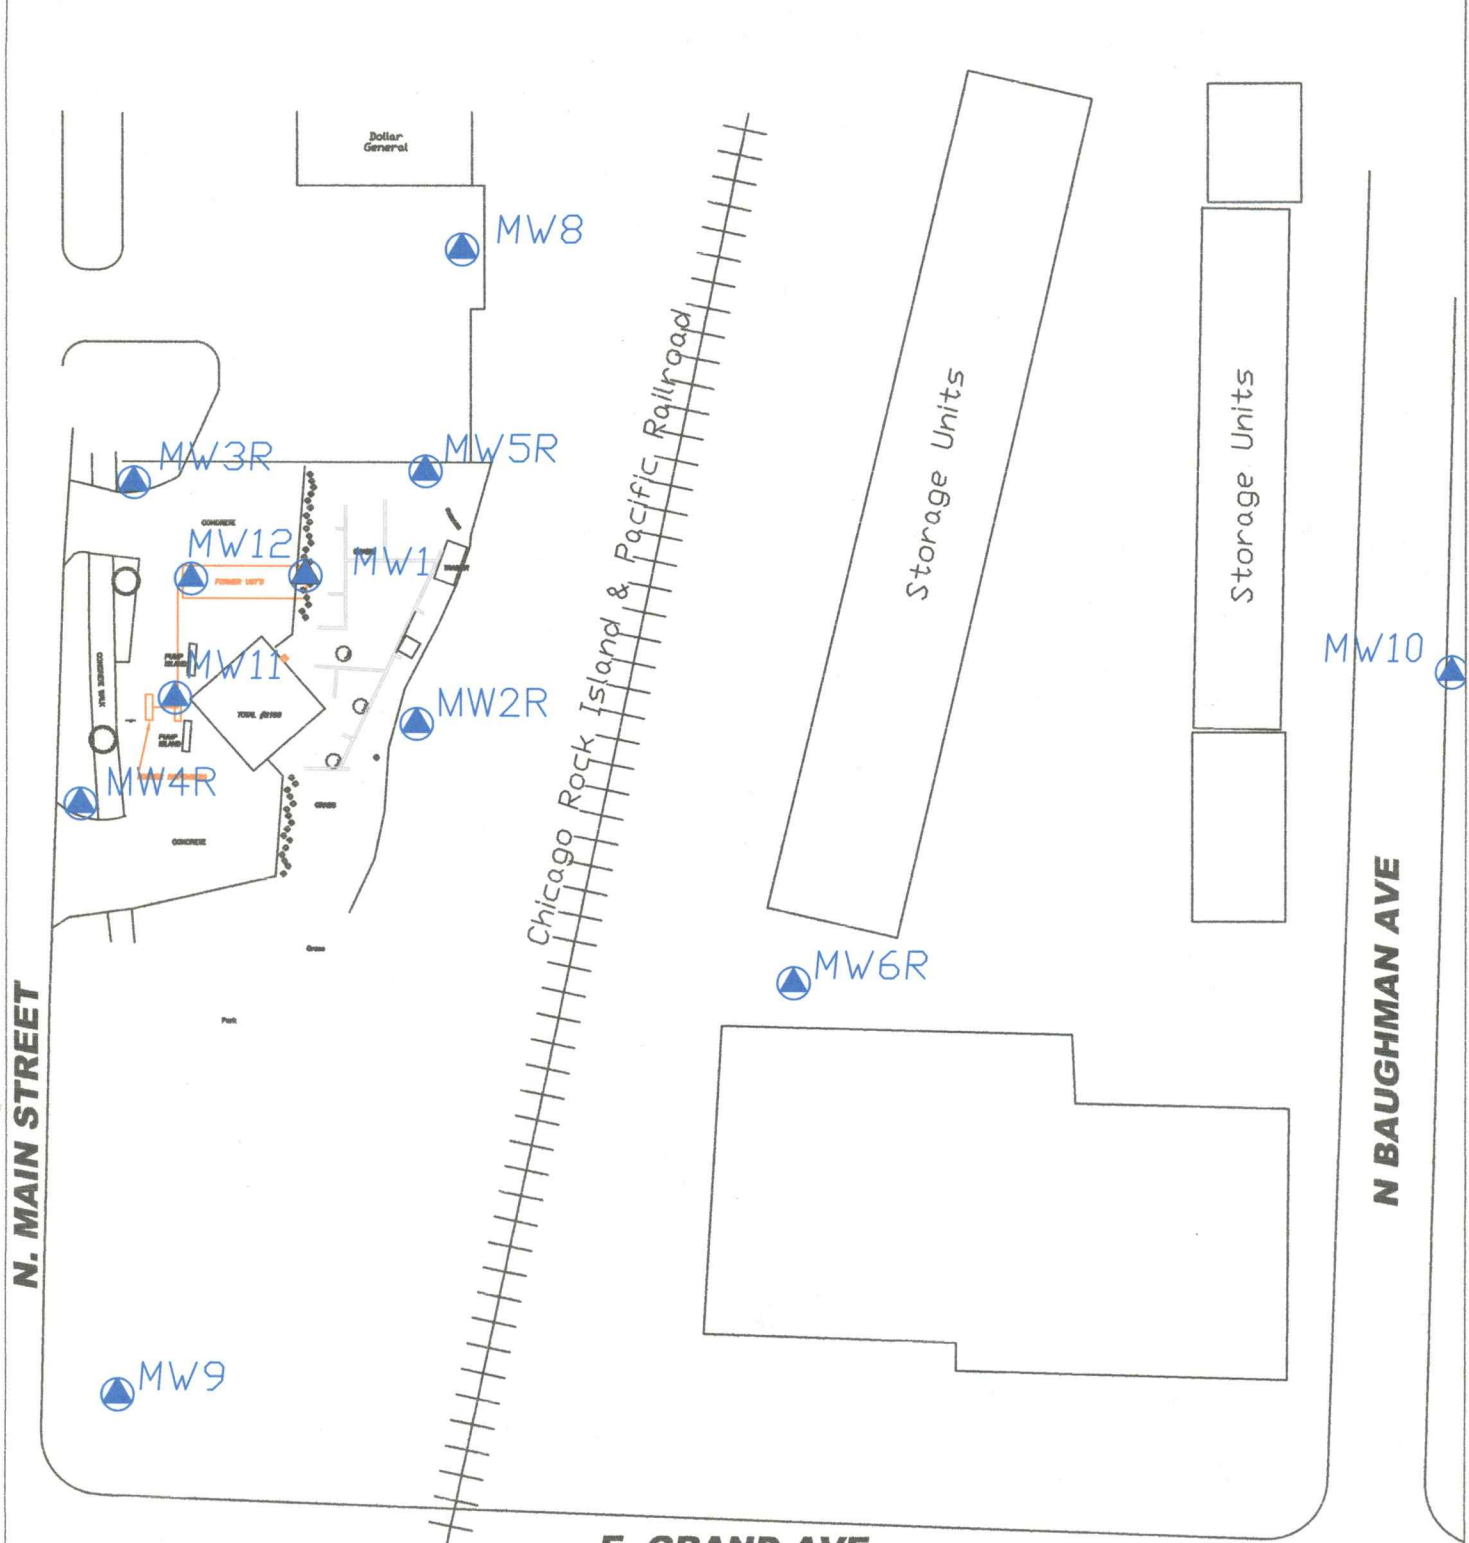

**E. GRAND AVE**

<b>SCS ENGINEERS</b>			
ENVIRONMENTAL CONSULTANTS AND CONTRACTORS			
8575 West 110th Street Overland Park, Kansas 66210			
<b>Site Base Map</b> <b>Total #2156</b> 140 North Main Haysville, Kansas			
Project Mgr.	SLM	Date	8/29/22
		KDHE Code:	U2-087-01320
		Project No.	27217283.00
Scale:	NOT TO SCALE	File Name	Total Q21.dwg
		Figure	