

WATER WELL RECORD Form WWC-5

Division of Water Resources App. No.


MW-12R

Original Record Correction Change in Well Use

Well ID

1 LOCATION OF WATER WELL: County: Sedgwick Fraction NW 1/4 SW 1/4 SW 1/4 SW 1/4 Section Number 32 Township Number T 28 S Range Number R 1 E W

2 WELL OWNER: Last Name: KDHE-BER First: Street or Rural Address where well is located (if unknown, distance and direction from nearest town or intersection): 140 North Main Street, Haysville, Ks.

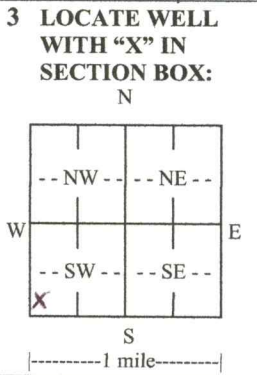

4 DEPTH OF COMPLETED WELL: 25 ft. Depth(s) Groundwater Encountered: 1) 22 ft. 2) ft. 3) ft., or 4) Dry Well WELL'S STATIC WATER LEVEL: ft. below land surface, measured on (mo-day-yr) above land surface, measured on (mo-day-yr) Pump test data: Well water was ft. after hours pumping gpm Well water was ft. after hours pumping gpm Estimated Yield: gpm Bore Hole Diameter: 8.75 in. to 25 ft. and in. to ft.

5 Latitude: 37.565504 (decimal degrees) Longitude: -97.351928 (decimal degrees) Horizontal Datum: WGS 84 NAD 83 NAD 27 Source for Latitude/Longitude: GPS (unit make/model) (WAAS enabled? Yes No) Land Survey Topographic Map Online Mapper

6 Elevation: NA ft. Ground Level TOC Source: Land Survey GPS Topographic Map Other

7 WELL WATER TO BE USED AS: 1. Domestic: Household Lawn & Garden Livestock Irrigation Feedlot Industrial 2. Public Water Supply: well ID 3. Dewatering: how many wells? 4. Aquifer Recharge: well ID 5. Monitoring: well ID MW-12R 6. Environmental Remediation: well ID 7. Air Sparge 8. Soil Vapor Extraction 9. Recovery 10. Injection 11. Oil Field Water Supply: lease 12. Test Hole: well ID Cased Uncased Geotechnical 13. Geothermal: how many bores? a) Closed Loop Horizontal Vertical b) Open Loop Surface Discharge Inj. of Water 14. Other (specify):

Was a chemical/bacteriological sample submitted to KDHE? Yes No If yes, date sample was submitted: Water well disinfected? Yes No

8 TYPE OF CASING USED: Steel PVC Other CASING JOINTS: Glued Clamped Welded Threaded Casing diameter 2 in. to 10 ft., Diameter in. to ft., Diameter in. to ft. Casing height above land surface 0 in. Weight lbs./ft. Wall thickness or gauge No. sch. 40

TYPE OF SCREEN OR PERFORATION MATERIAL: Steel Stainless Steel Fiberglass PVC Brass Galvanized Steel Concrete tile None used (open hole) Other (Specify)

SCREEN OR PERFORATION OPENINGS ARE: Continuous Slot Mill Slot Gauze Wrapped Torch Cut Drilled Holes Other (Specify) Louvered Shutter Key Punched Wire Wrapped Saw Cut None (Open Hole)

SCREEN-PERFORATED INTERVALS: From 10 ft. to 25 ft., From ft. to ft., From ft. to ft. GRAVEL PACK INTERVALS: From 8 ft. to 25 ft., From ft. to ft., From ft. to ft.

9 GROUT MATERIAL: Neat cement Cement grout Bentonite Other Cement pad Grout Intervals: From 1 ft. to 8 ft., From 0 ft. to 1 ft., From ft. to ft.

Nearest source of possible contamination: Septic Tank Lateral Lines Pit Privy Livestock Pens Insecticide Storage Sewer Lines Cess Pool Sewage Lagoon Fuel Storage Abandoned Water Well Watertight Sewer Lines Seepage Pit Feedyard Fertilizer Storage Oil Well/Gas Well Other (Specify) Contaminated Site Direction from well? Distance from well? ft.

Table with columns: FROM, TO, LITHOLOGIC LOG, FROM, TO, LITHO. LOG (cont.) or PLUGGING INTERVALS. Rows: 0-4 Silty Clay, dark brown, soft; 4-8 Clay, dark brown, soft; 8-12 Silty/Sandy Clay, light brown; 12-25 Sand, light brown.

Original Returned to Sender for Correction Date: 1-12-2023

Notes: KDHE# 42-087-01320


11 CONTRACTOR'S OR LANDOWNER'S CERTIFICATION: This water well was constructed, reconstructed, or plugged under my jurisdiction and was completed on (mo-day-year) 9-16-2022 and this record is true to the best of my knowledge and belief. Kansas Water Well Contractor's License No. 604. This Water Well Record was completed on (mo-day-year) 10-28-2022 under the business name of Environmental Priority Service, Inc. Signature: [Signature]

N. MAIN STREET



LEGEND:

- NEW MONITORING WELL
- EXISTING MONITORING WELL
- PLUGGED MONITORING WELL
- AIR SPARGE WELL
- SVE WELL

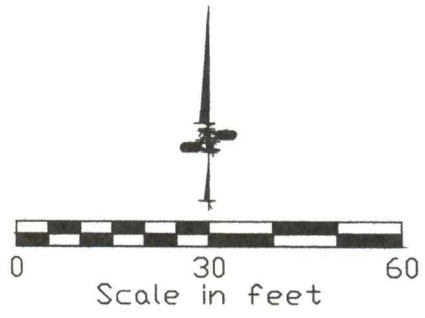


SCS ENGINEERS
 ENVIRONMENTAL CONSULTANTS AND CONTRACTORS
 8575 West 110th Street
 Overland Park, Kansas 66210

New Monitor Wells
Total #2156
 140 North Main
 Haysville, Kansas

Project Mgr. SLM	Date 9/28/2022	KDHE Code: U2-087-01320	Project No. 27217283.01
Scale: NOT TO SCALE		File Name Total #2156.dwg	Figure

xyywlca

20-08-1E

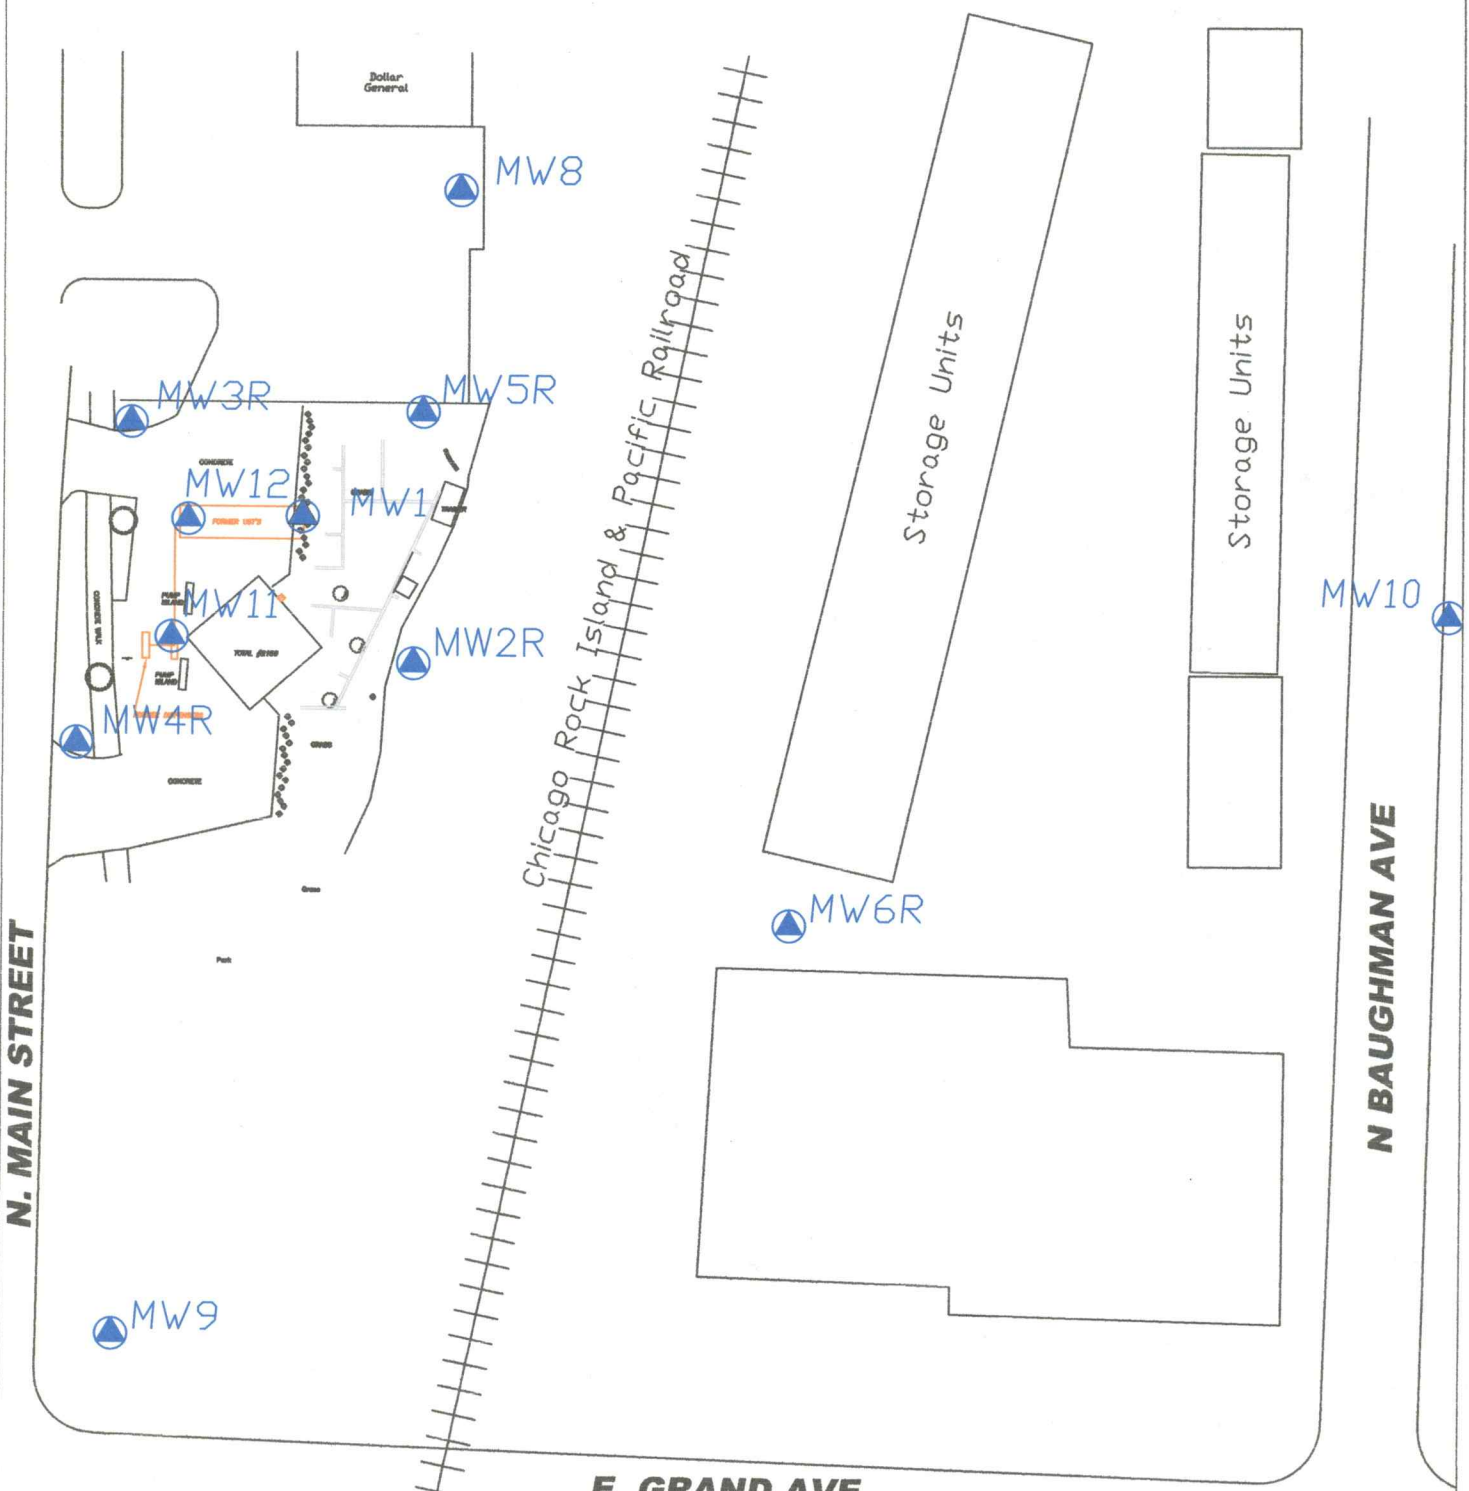

E. GRAND AVE

N BAUGHMAN AVE

SCS ENGINEERS
 ENVIRONMENTAL CONSULTANTS AND CONTRACTORS
 8575 West 110th Street
 Overland Park, Kansas 66210

Site Base Map
Total #2156
 140 North Main
 Haysville, Kansas

Project Mgr.	SLM	Date	8/29/22	KDHE Code:	U2-087-01320	Project No.	27217283.00
Scale:	NOT TO SCALE		File Name	Total Q21.dwg		Figure	

