

WATER WELL RECORD Form WWC-5

Original Record Correction Change in Well Use

Division of Water Resources App. No.

[Blank Box]

Well ID

SS03-MW33

1 LOCATION OF WATER WELL: County: Sedgwick Fraction 1/4 SW 1/4 SE 1/4 SW 1/4 Section Number 6 Township Number T 28 S Range Number R 2 E W

2 WELL OWNER: Last Name: First: Street or Rural Address where well is located (if unknown, distance and direction from nearest town or intersection): If at owner's address, check here: Well located within McConnell AFB, Wichita, KS

3 LOCATE WELL WITH 'X' IN SECTION BOX: N W E S 4 DEPTH OF COMPLETED WELL: 22.2 ft. 5 Latitude: 37.6324 Longitude: 97.2548

7 WELL WATER TO BE USED AS: 1. Domestic: Household, Lawn & Garden, Livestock, Irrigation, Feedlot, Industrial 5. Public Water Supply, Dewatering, Aquifer Recharge, Monitoring, Environmental Remediation, Air Sparge, Soil Vapor Extraction, Recovery, Injection 10. Oil Field Water Supply, Test Hole, Geothermal, Closed Loop, Open Loop, Other


Was a chemical/bacteriological sample submitted to KDHE? Water well disinfected?

8 TYPE OF CASING USED: Steel, PVC, Other CASING JOINTS: Glued, Clamped, Welded, Threaded Casing diameter, Casing height, Weight, Wall thickness or gauge No. TYPE OF SCREEN OR PERFORATION MATERIAL: Steel, Stainless Steel, Fiberglass, PVC, Brass, Galvanized Steel, Concrete tile, None used (open hole) SCREEN OR PERFORATION OPENINGS ARE: Continuous Slot, Mill Slot, Gauze Wrapped, Torch Cut, Drilled Holes, Louvered Shutter, Key Punched, Wire Wrapped, Saw Cut, None (Open Hole) SCREEN-PERFORATED INTERVALS: From 22.0 ft. to 12.0 ft. GRAVEL PACK INTERVALS: From 23.0 ft. to 10.0 ft.


9 GROUT MATERIAL: Neat cement, Cement grout, Bentonite, Other Grout Intervals: From 10.0 ft. to 7.0 ft. Nearest source of possible contamination: Septic Tank, Lateral Lines, Pit Privy, Livestock Pens, Insecticide Storage, Sewer Lines, Cess Pool, Sewage Lagoon, Fuel Storage, Abandoned Water Well, Watertight Sewer Lines, Seepage Pit, Feedyard, Fertilizer Storage, Oil Well/Gas Well

10 FROM TO LITHOLOGIC LOG FROM TO LITHO. LOG (cont.) or PLUGGING INTERVALS

11 CONTRACTOR'S OR LANDOWNER'S CERTIFICATION: This water well was constructed, reconstructed, or plugged under my jurisdiction and was completed on (mo-day-year) 6/26/2018 and this record is true to the best of my knowledge and belief. Kansas Water Well Contractor's License No. 710 This Water Well Record was completed on (mo-day-year) 7/21/2018 under the business name of Below Ground Surface, Inc.

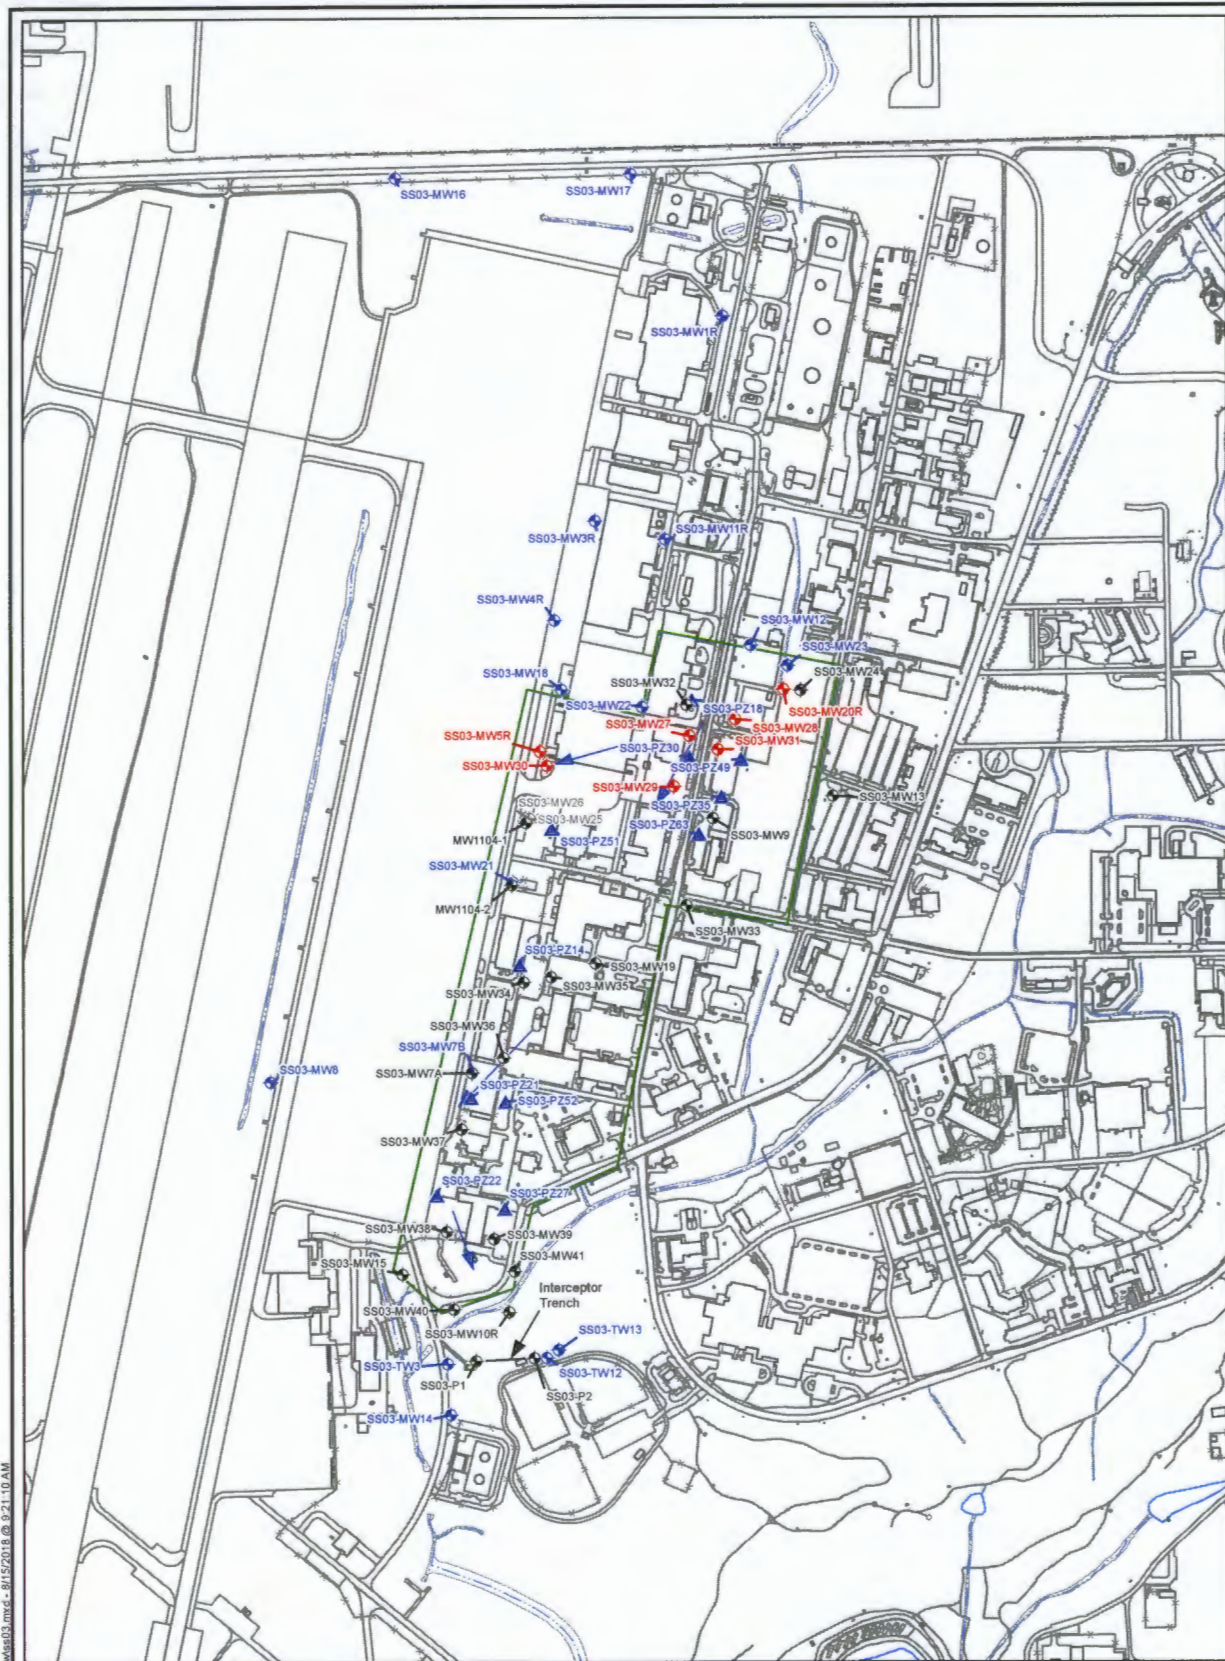

C:\DCS\Projects\ENV\GIS\mccconell\Erns\m2018\m2018\ss03.mxd - 8/15/2018 @ 9:21:10 AM

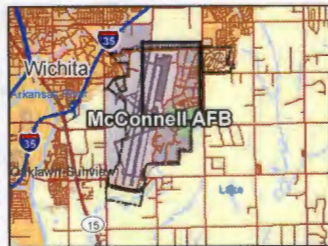

Legend

- ◆ ISCR Performance Monitoring Well
- ◆ Annual Monitoring Well
- ◻ Water Level Only Monitoring Well
- ▲ Piezometer for Water Level Only
- Monitoring Well
- Groundwater Flow Direction
- Fence
- - - Drainage Ditch
- Institutional Control Boundary
- Surface Water
- Installation Boundary

ISCR = *in situ* chemical reduction
 ISOC = *in situ* submerged oxygen curtain

- Notes:**
- 1) Performance monitoring wells are sampled as part of performance monitoring events in addition to annual monitoring events.
 - 2) Monitoring wells SS03-MW25 and SS03-MW26 contain ISOC units.

Rev. 1 / August 2018



SS03 Monitoring Well Locations
 Base Wide GW Monitoring Plan
 McConnell Air Force Base,
 Wichita, Kansas

Prepared By: DPG	Date: 8/15/2018	Project No: 60416270
Checked By: SH	Revision: 0	