

WATER WELL RECORD Form WWC-5

Original Record Correction Change in Well Use

Division of Water Resources App. No. Well ID

1 LOCATION OF WATER WELL: County: Fraction Section Number Township Number Range Number

2 WELL OWNER: Last Name: Business: Address: City: State: ZIP: Street or Rural Address where well is located

3 LOCATE WELL WITH 'X' IN SECTION BOX: N W E S 4 DEPTH OF COMPLETED WELL: 5 Latitude: Longitude: Datum: Source for Latitude/Longitude: 6 Elevation:

7 WELL WATER TO BE USED AS: 1. Domestic: 2. Irrigation: 3. Feedlot: 4. Industrial: 5. Public Water Supply: 6. Dewatering: 7. Aquifer Recharge: 8. Monitoring: 9. Environmental Remediation: 10. Oil Field Water Supply: 11. Test Hole: 12. Geothermal: 13. Other

Was a chemical/bacteriological sample submitted to KDHE? Water well disinfected?


8 TYPE OF CASING USED: CASING JOINTS: Casing diameter: Casing height above land surface: TYPE OF SCREEN OR PERFORATION MATERIAL: SCREEN OR PERFORATION OPENINGS ARE: SCREEN-PERFORATED INTERVALS: GRAVEL PACK INTERVALS:

9 GROUT MATERIAL: Grout Intervals: Nearest source of possible contamination: Direction from well?

Table with columns: FROM, TO, LITHOLOGIC LOG, FROM, TO, LITHO. LOG (cont.) or PLUGGING INTERVALS. Includes Notes section.


11 CONTRACTOR'S OR LANDOWNER'S CERTIFICATION: This water well was constructed, reconstructed, or plugged under my jurisdiction and was completed on (mo-day-year) and this record is true to the best of my knowledge and belief.

DRAWING: P:\Subway\AFCEE\8903.0005 - RI FS PP ROD MAFB\4.0 Site Data\4.6 Drawings\DWG\GSI\Planning Figures\FIG X Round 4 December 2019 Proposed Sample Locations.DWG

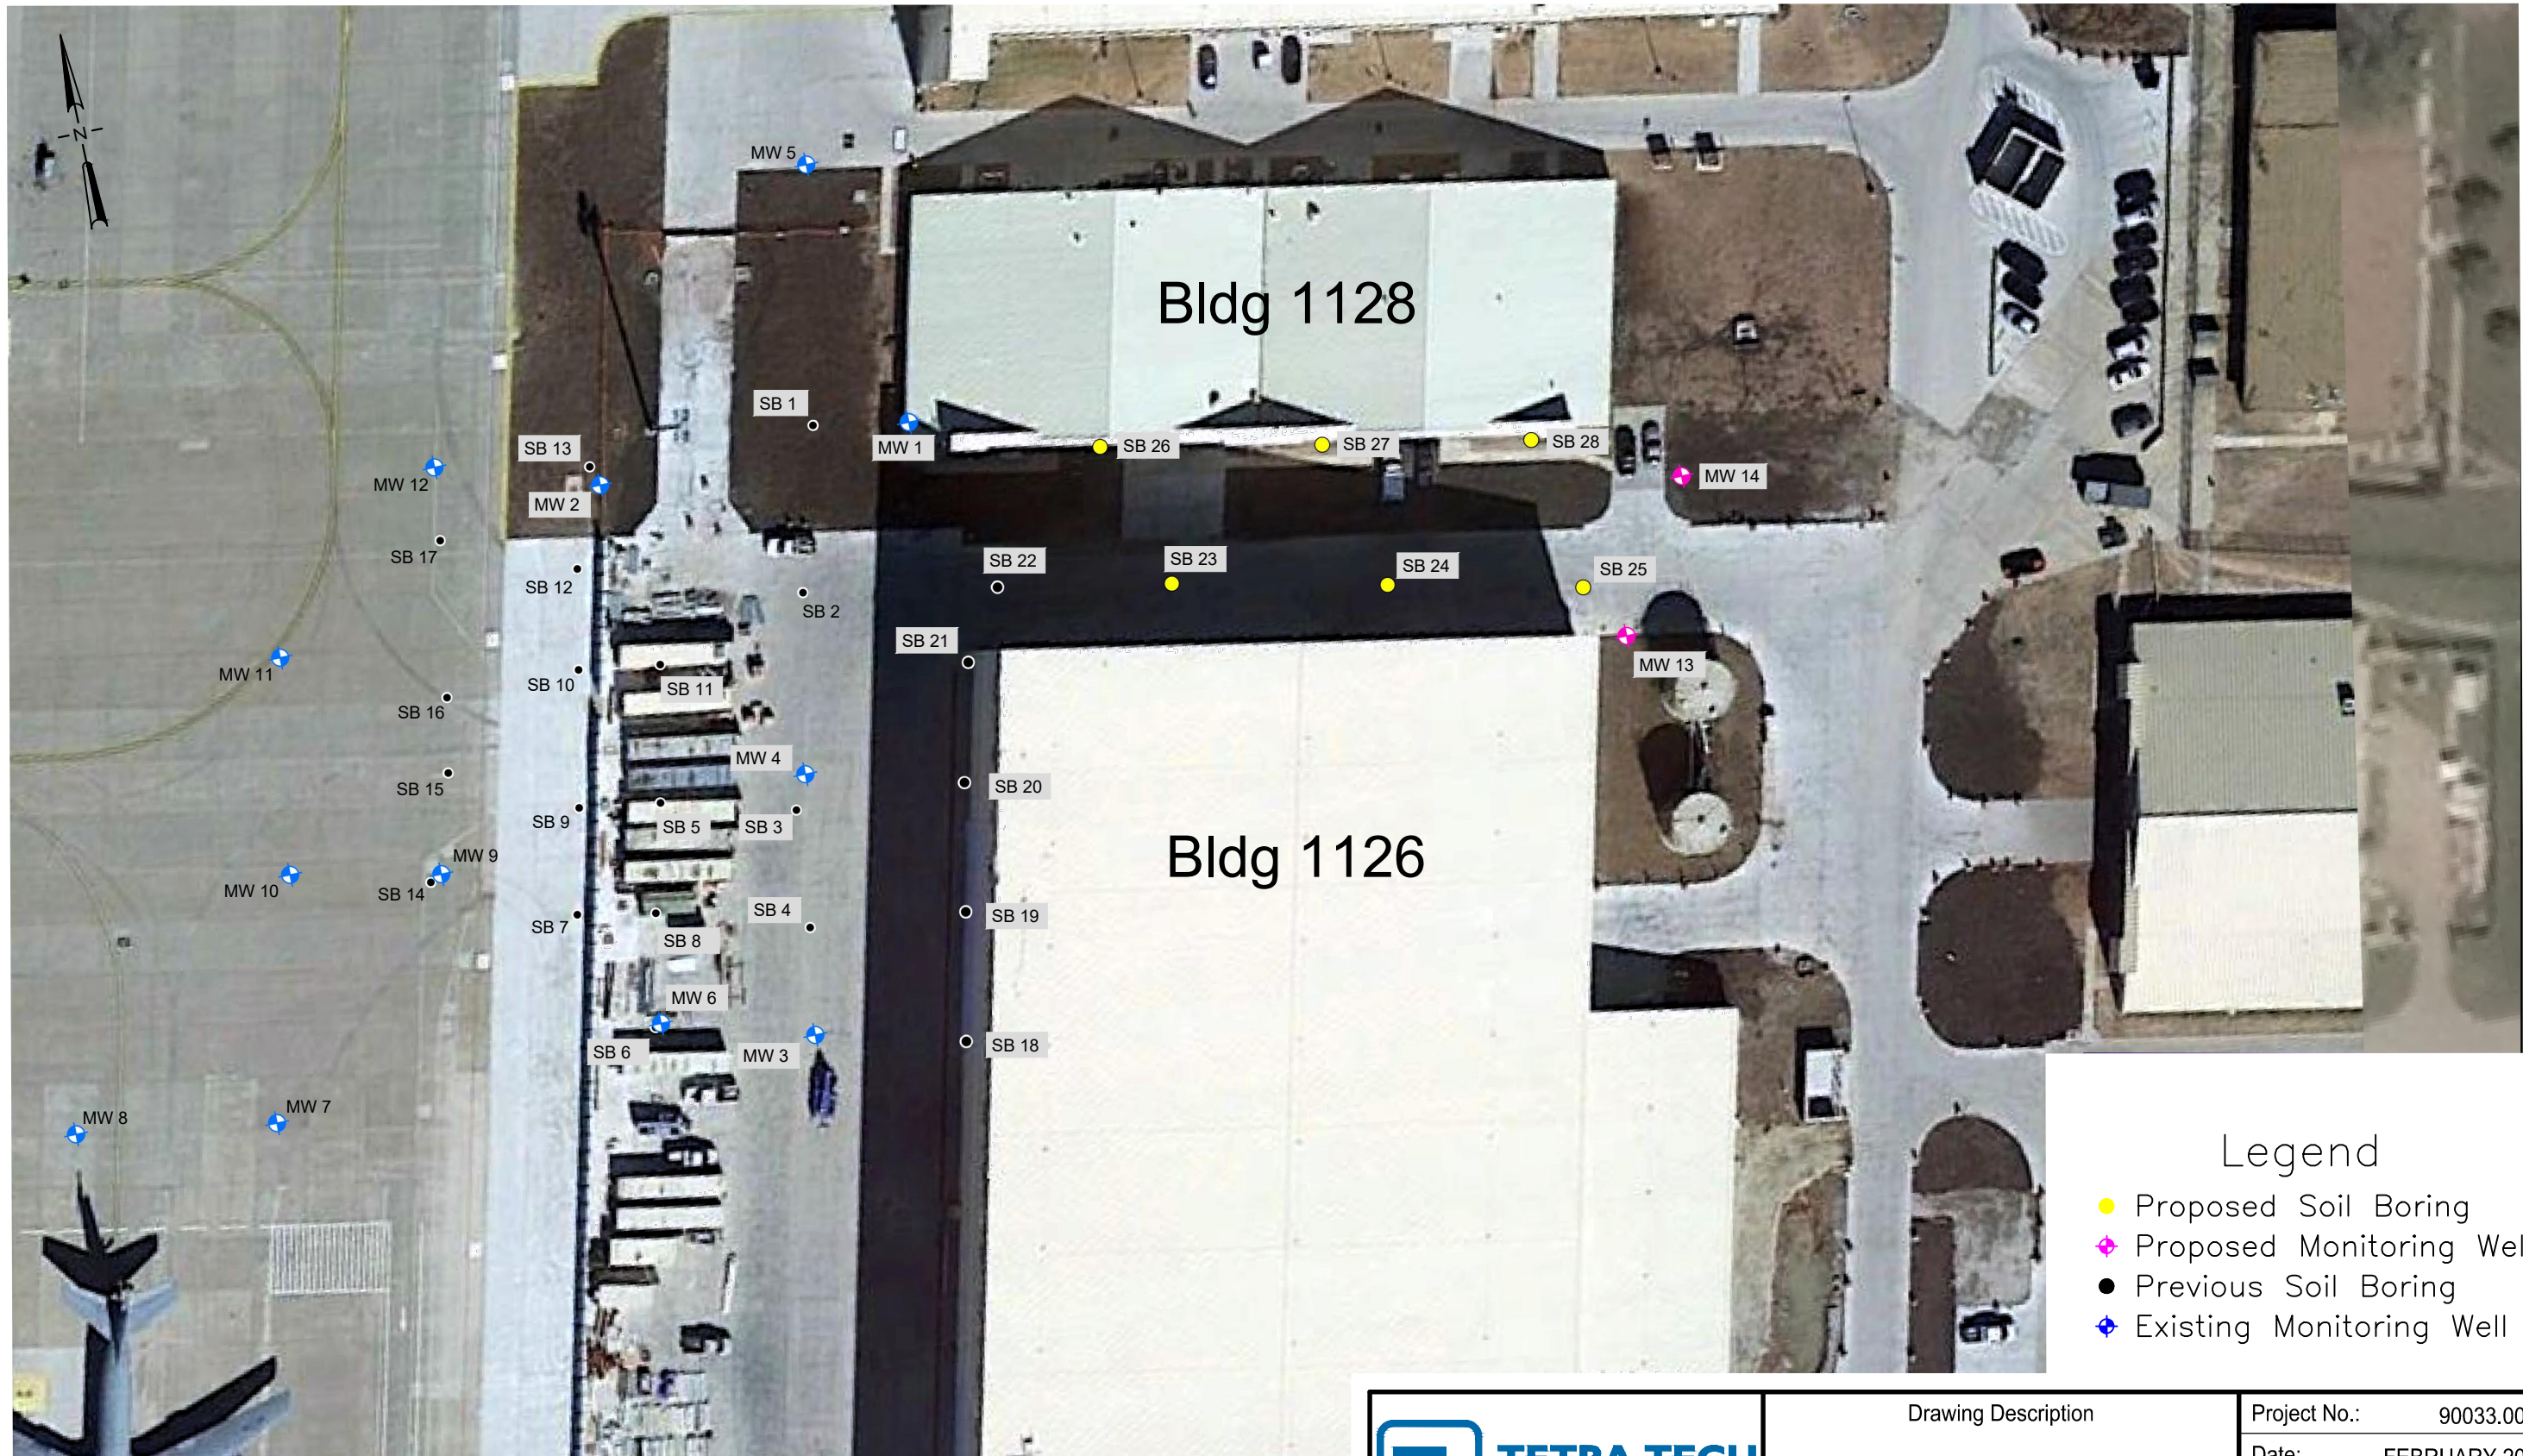

Source: Google Earth, Tetra Tech

- ### Legend
- Proposed Soil Boring
 - ◆ Proposed Monitoring Well
 - Previous Soil Boring
 - ◆ Existing Monitoring Well

 <p>TETRA TECH</p> <p>www.tetrattech.com</p> <p>1634 Eastport Plaza Drive Collinsville, IL 62234 PHONE: 618-343-2300 FAX: 618-345-1281</p>	Drawing Description McConnell Air Force Base SS 005 Round 4 Proposed Locations	Project No.: 90033.0005 Date: FEBRUARY 2020 Drawn By: DEF
	SS005 Remedial Investigation McConnell Air Force Base, Kansas	Figure Number <h1>4</h1>

Copyright: Tetra Tech