
	WELL F		WWC-5			ion of Water		1			
					rces App. No.		Well ID				
1 LOCATION OF WATER WELL: County: SEDGWICK			Fraction SE ¹ / ₄ SE ¹ / ₄ NE ¹ / ₅	Section Num			Township Numb T 29 S		E U W		
and the second se			First:		r Rura						
2 WELL OWNER: Last Name: Business: DERBY, CITY OF First: Street or Rural Address where well is located (if unknown direction from nearest town or intersection): If at owner's address								r's address,	check here:		
Address:	611 N . M	ULBERRY ST 300		309 N. WOODLAWN BLVD.							
Address: City:	DERBY	State: KS	ZIP: 67037 DERBY, KS 67037								
3 LOCAT											
Denth(a) Groundwa			MPLETED WELL:			5 Latitud	de: -97.26	322	(decimal degrees)		
	N BOX:		2) ft. 3) ft., or 4) Dry Well				al Datum: WGS 8	4 I NAD	83 INAD 27		
1	14	WELL'S STATIC WATER LEVEL: 20 ft.				Source for Latitude/Longitude:					
		below land surface	 below land surface, measured on (mo-day-yr).10-11-2022 above land surface, measured on (mo-day-yr) Pump test data: Well water was					GPS (unit make/model: <u>1</u> -PHONE (WAAS enabled? ☐ Yes ☐ No) (WAAS unit of the termination of			
NW	NE - 7										
w	Е	after hours pumping					ne Mapper:				
SW SE		Well water was ft.									
SW	SE	after hour	after hours pumping				6 Elevation:ft. Ground Level TOC				
S Bore Hole Diamet						Source: Land Survey GPS Dopographic Map					
	mile		in. to			Other					
7 WELL	WATER TO	D BE USED AS:									
1. Domestic			ater Supply: well ID			10. Oil Field Water Supply: lease					
□ Household 6. □ Dewater ■ Lawn & Garden 7. □ Aquifer			ng: how many wells?			11. Test Hole: well ID					
Livest		echarge: well ID g: well ID				mal: how many bore					
			d Remediation: well ID			a) Clos	a) Closed Loop Horizontal Vertical				
3. Feedlot Air Sparge							b) Open Loop 🗌 Surface Discharge 🔲 Inj. of Water				
4. 🗌 Indust		Recovery					r (specify):				
Was a chemical/bacteriological sample submitted to KDHE? ☐ Yes ■ No If yes, date sample was submitted:											
					ACTA	O LODITO		1	1 - 1 - 1 - 1 - 1		
Casing dian	of CASING	in to 100 A	C U Other	in to	ASIN	A Diamet	Glued Clampe	a 🗌 weide			
Casing heig	ht above land	USED: Steel PV 	n. Weight 2.	35ıb	s./ft.	Wall thickne	ss or gauge No. SD.	R26			
TYPE OF	SCREEN O	R PERFORATION MA	TERIAL:					-			
□ Steel □ Stainless Steel □ Fiberglass ■ PVC □ Other (Specify)											
Brass Galvanized Steel Concrete tile None used (open hole) SCREEN OR PERFORATION OPENINGS ARE:											
	nuous Slot			Forch Cut	[] Dr	illed Holes	Other (Specify)				
Louv	ered Shutter	Key Punched V	Vire Wrapped	Saw Cut	D No	one (Open Hol	e)	1			
SCREEN-	PERFORAT	ED INTERVALS: From	m .50 ft. to .100	ft., F	rom	ft. to .	ft., From	ft. to) ft.		
G	RAVEL PA	CK INTERVALS: From	m 24 ft. to 10	10 ft., F	rom	ft. to .	ft., From	ft. to) ft.		
9 GROU	I MATERL	AL: Neat cement 4 ft. to .24	Cement grout	Bentonite	Ot	her	Δ 40	·····			
Nearest sou	irce of possib	le contamination:	IL, FIOM	п. ю	•••••	IL., From	п. ю	n.			
Septic		🗌 Lateral Lin	es 🛛 Pit Privy			ivestock Pens	Insect	icide Storage			
Sewer		Cess Pool	Sewage I			fuel Storage		loned Water			
Water	tight Sewer L	ines 🗌 Seepage Pi	t Feedyard		Шł	Fertilizer Stora	ge 🗌 Oil W	ell/Gas Well	•		
Direction fr	om well? .NO	ORTH	Distance from	well? .15	+		f	t.			
10 FROM	TO	LITHOLO	GIC LOG	FRC			ITHO. LOG (cont.) o		IG INTERVALS		
0		TOP SOIL									
3		CLAY		-							
35 56		MEDIUM SAND									
95		GRAY SHALE		-							
30	100	LIVIESTONE									
				Note	5:						
11 CONT	11 CONTRACTOR'S OR LANDOWNER'S CERTIFICATION: This water well was constructed, reconstructed, or plugged under my jurisdiction and was completed on (mo-day-year) .10-1.1-2022 and this record is true to the best of my knowledge and belief.										
under my	jurisdiction a	and was completed on (236 This W	-40.44	and t	his record is	true to the best of r	ny knowled	lge and belief.		
under the	Kansas Water Well Contractor's License No. 236										
Mail	1 white copy a	long with a fee of \$5.00 for ea	ach constructed well to: K	ansas Depa	rtment o	of Health and Er	vironment, Bureau of V	Vater, GWTS	Section,		
		St., Suite 420, Topeka, Kansa	s 66612-1367. Mail one t				for your records. Telep				
Visit us at http://www.kdheks.gov/waterwell/index.html KSA 82a-1212 Revised 7/10/2015											

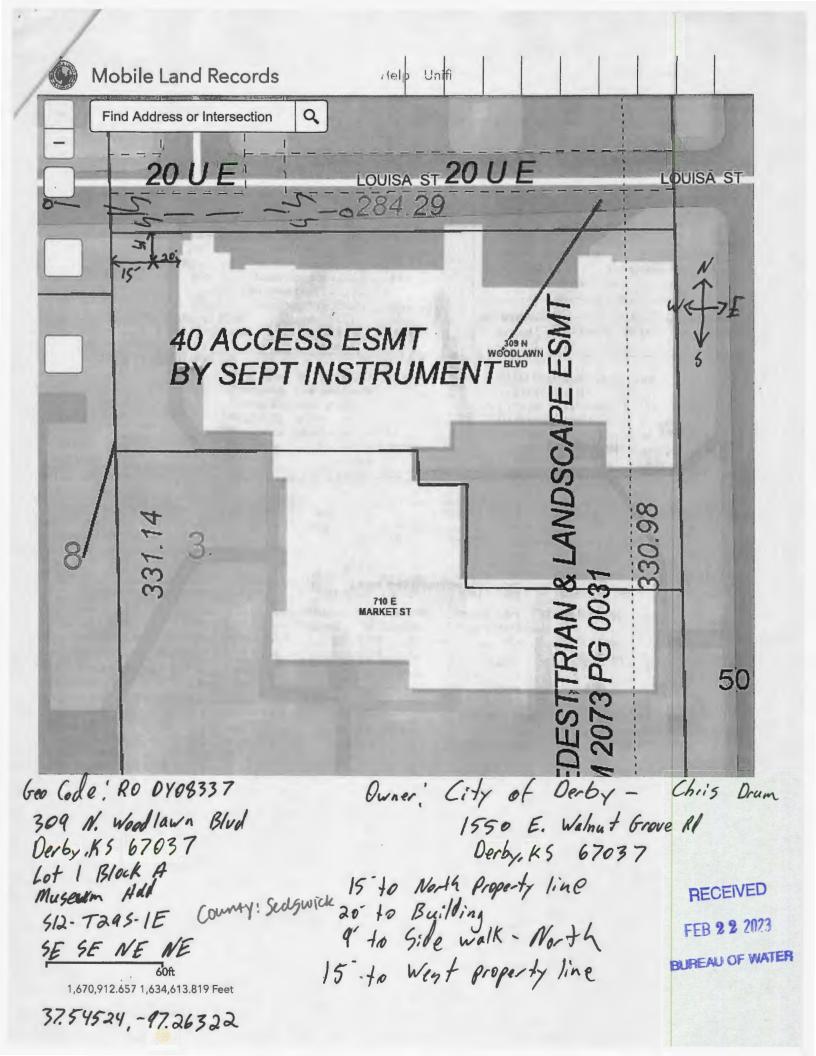

t, 295 R 1E Sec. 12 Sedgwich county								
jui jui coo de								
RECEIVED								
AUG 2 5 2022								
Martin DIGTOD								
611 Mulberry Road, Suite 300	-							
Derby, KS 67037								
DERBY Phone 316-788-6632 Email: permits@derbyweb.com www.derbyks.com								
A PLOT PLAN SHOWING PROPERTY LINES, EASEMENTS & STRUCTURES MUST BE ATTACHED								
A COPY OF THE PERMIT MUST BE KEPT ON SITE AT ALL TIMES. Date: <u>6-24-2022</u> FEE: \$25.0	o							
CONTACT INFORMATION	C. Martin & State							
Address of Well: 309 N. Woodlawn Blud. Derby, KS 67037								
Property Owner Name: City OF Perby								
Property Owner Phone:Email:	- Age							
Contractor Name/Company: Harp Well & Pump Service Inc								
Contractor Address: 215 5. Tyle- Ru. Wichita, KS 67209								
Contractor Phone: (3/6) 722-1411 Email: havp wello lex & yahoo. com	+							
PROJECT INFORMATION Legal Description: Lot Block A Museum Add								
I / We understand and agree to follow the provisions of Ordinance No. 1797, especially as it pertains to the following								
construction and connection requirements; The property owner and any water well contractor acting on behalf of the property owner shall be responsible for meeting								
the following minimum requirements:								
 All active, inactive, or abandoned water-wells are to meet all current City and State construction, reconstruction, location, and plugging standards. 								
The separation distance between wells and soils or foundations, which have been treated or								
pretreated with a subsurface pressurized application of a termiticide, shall be a minimum of 25 feet. 3. Pressure Water Line and Sewer Line Requirements:								
 a. The sewer line is to be two or more feet below the waterline, or; b. If a sewer line is within ten feet of a water line, the sewer line is to be constructed of cast iron pipe with fitted 								
joints or approved plastic pipe with solvent weld joints.								
 No water well shall be constructed in any public easement or right-of-way. The separation distance between wells and sewer lines shall be a minimum of 25 feet. When 								
sewer lines are constructed of cast iron, plastic, or other equally tight material, the minimum separation distance shall be 10 feet.								
It is the responsibility of the applicant to provide the owner with a copy of this agreement.								
inspected.								
AN INSPECTION IS REQUIRED. CONTACT (316) 788-6632 OPTION 2 TO SCHEDULE								
Alex 10								
Applicant Signature Date								
Alejandro Olmos								
OFFICIAL USE ONLY Permit Number: 019700								
Required Documents: Image: Construction of the second se	RECEIVED							
1 miles								
Authorized Agent Permit Issue Date	FEB 2 2 2023							
Notes/Conditions:								
	UREAU OF WATER							
Revised 2022								
	A Martin							