
			WWC-5		Division of Water			IAS4			
		Correction Chang	ge in Well Use		sources App. No.		Well ID				
		WATER WELL:	Fraction		ection Number	Township Number		ige Number			
	y: Sedgwid		SE 1/4 SE 1/4 SE 1/4 First: Mohammad					■ E □ W			
		Last Name: Saeed		ral Address where well is located (if unknown, distance and_							
Business Address:		rosandu Driva		direction from nearest town or intersection): If at owner's address, check here:							
Address	3008 NO	rmandy Drive	*	615 N. Rock Road, Derby							
City:	McKinne	State: TX	ZIP: 75070	To M. Nook Nood, Bolby							
3 LOCAT							_				
WITH "			MPLETED WELL:		ft. 5 Latitud	e: 37.54890	0	(decimal degrees)			
1	ON BOX:	Depth(s) Groundwater	Encountered: 1)19	2.5 ft. Longitude: -97.24467 (decimal degrees)							
2) ft. 3) ft., or 4) [☐ Dry Well Horizontal Datum: ☐ WGS 84 ■ NAD 83 ☐ NAD 27						
			TER LEVEL:	ft. Source for Latitude/Longitude:							
'	'		e, measured on (mo-day-								
NW	NE		, measured on (mo-day-		······ (WAAS enabled? \(\subseteq \text{ Yes} \(\supseteq \text{ No)}						
		Pump test data: Well v	vater was ft		■ Land Survey □ Topographic Map						
W	E	after hour	s pumping	gpm	☐ Onli	ne Mapper:					
sw	SE		water was fi								
	IV	after hours	s pumping	nping gpm			Cround	Laval D TOC			
L	S	Estimated Yield:	8 in. to22 ft. and Source:			on: .1287.63ft. ☐ Ground Level ☐ TOC ☐ Land Survey ☐ GPS ☐ Topographic Map					
1	s mile						her				
		O BE USED AS:	in. to	π.				• • • • • • • • • • • • • • • • • • • •			
1. Domestic											
Domestic			ater Supply: well ID			ield Water Supply: le	ase	•••••			
_	Moid & Garden	6. Dewaterin	ng: how many wells?	•••••	11. Test Ho	11. Test Hole: well ID					
Livest		/. Aquiter R	echarge: well ID	• • • • • • • • • • • • • • • • • • • •		d Uncased G					
2. Irrigat		8. Monitorin	g: well ID	ΙΔΟΛ		mal: how many bores					
3. Feedlo			al Remediation: well ID		,	ed Loop Horizonta					
4. Indust		Air Sparge		xtraction	b) Oper	b) Open Loop Surface Discharge Inj. of Water 13. Other (specify):					
		Recovery	_ •								
Was a che	mical/bacte	eriological sample subm	itted to KDHE? \square	Yes 🔳 No	If yes, date s	ample was submitted	i:				
		? ☐ Yes ■ No									
8 TYPE C	OF CASING	G USED: 🗆 Steel 🔳 PV	C Other	CAS	ING JOINTS: [☐ Glued ☐ Clamped	☐ Welded	Threaded			
Casing diam	ieter2.	in. to20 ft.,	Diameter	in. to	ft., Diamete	er in. to	ft.				
Casing heigh	ht above land	in. to	ı. Weight	lbs./ft	. Wall thickne	ss or gauge No. Sch.	40				
TYPE OF	SCREEN O	R PERFORATION MA	TERIAL:								
☐ Steel		inless Steel	glass PVC		☐ Other	(Specify)					
☐ Brass	☐ Ga	Ivanized Steel		ed (open ho		(1)					
SCREEN (OR PERFO	RATION OPENINGS A	RE:		,						
	nuous Slot	■ Mill Slot □ Ga	auze Wrapped Tor	ch Cut 🔲	Drilled Holes	Other (Specify)					
☐ Louve	ered Shutter	☐ Key Punched ☐ W	ire Wrapped Sav	v Cut 🔲	None (Open Hole	:)					
SCREEN-I	PERFORAT	TED INTERVALS: From	1.20 ft. to .22	ft From	ft. to	ft From	ft. to	ft.			
G	RAVEL PA	ACK INTERVALS: From	n 17 ft. to 22	ft., From	ft. to	ft., From	ft. to	ft.			
9 GROUT	MATERI	AL: Neat cement	Cement grout Ber	tonite \square	Other						
Grout Interv	als: From .	AL: Neat cement 3 ft. to .17	ft., From f	t. to	ft., From	ft. to	ft.				
Nearest sou	rce of possil	ole contamination:			,	200					
☐ Septic	Tank	☐ Lateral Line	es 🔲 Pit Privy		Livestock Pens	☐ Insectici	de Storage				
☐ Sewer		☐ Cess Pool	☐ Sewage Lag	oon [Fuel Storage	☐ Abandor		Well			
	ight Sewer L				Fertilizer Storag	e 🔲 Oil Well	l/Gas Well				
Other (Specify) .C	ontaminated site									
Direction fro	om well?		Distance from we			ft.					
10 FROM	ТО	LITHOLOG		FROM	TO LI	THO. LOG (cont.) or l	PLUGGING	3 INTERVALS			
0	5	Silt, sl. clayey, sandy									
5	19.5	Sand, f-c w/f gravel, B									
19.5	22	Sand, vf-f, silty, clayey	, Yellow Brn								
				Notes:	KDHE Project #U2	2-087-12717					
				Hotes.	NDHE Floject#02	2-007-12717					
				-				**			
11 CONT	DACTOD'	S OD I ANDOWNED'S	CEDTIFICATION	This wet	or well was	anstructed recen	actmusted	n Dugged			
11 CONTRACTOR'S OR LANDOWNER'S CERTIFICATION: This water well was constructed, reconstructed, or plugged under my jurisdiction and was completed on (mo day year) 4/26/2021 and this record is true to the heat of my knowledge and belief											
under my jurisdiction and was completed on (mo-day-year) .4/26/2021 and this record is true to the best of my knowledge and belief. Kansas Water Well Contractor's License No. 527 This Water Well Record was completed on (mo-day-fear) .0.1/20/2022											
under the business name of GeoCore, LLC Signature											
Mail 1 white copy along with a fee of \$5.00 for each constructed well to: Kansas Department of Health and Environment, Bureau of Water, GWTS Section,											
1		St., Suite 420, Topeka, Kansas	_	-							
1		ks.gov/waterwell/index.html		KSA 82a-1				7/10/2015			

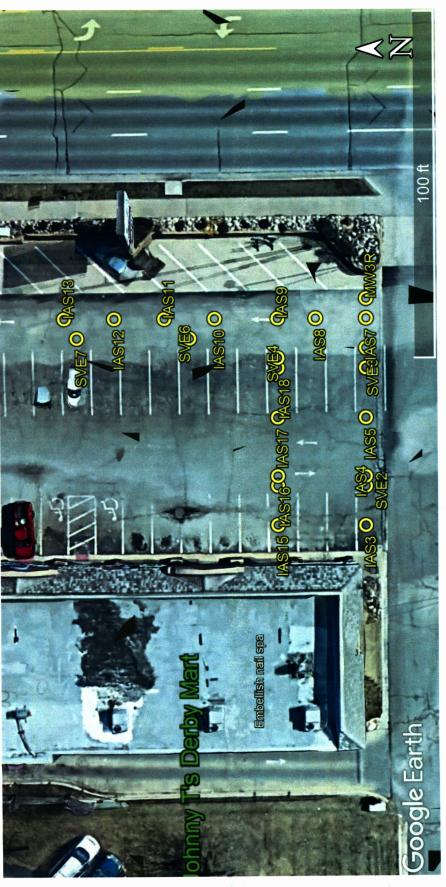

Project Site:

Johnny T's Derby Mart, 615 N. Rock Road, Derby

KDHE Project Code: U2-087-12717

GPS Coordinates:

AS11: 37.54906, -97.24451	37.54910, -97.24451	AS13: 37.54914, -97.24451	AS15: 37.54897, -97.24472	AS16: 37.54897, -97.24467	AS17: 37.54897, -97.24461	AS18: 37.54897, -97.24456
IAS11:	IAS12:	IAS13:	IAS15:	IAS16:	IAS17:	IAS18:
37.54890, -97.24472	37.54890, -97.24467	37.54890, -97.24461	37.54890, -97.24456	37.54890, -97.24451	37.54894, -97.24451	37.54897, -97.24451
IAS3:	IAS4:	IAS5:	IAS6:	IAS7:	IAS8:	IAS9:

MW3R: 37.54890, -97.24449

IAS10: 37.54902, -97.24451

37.54890, -97.24468 37.54890, -97.24454 37.54897, -97.24455 37.54897, -97.24468 37.54904, -97.24453 37.54913, -97.24453

SVE2: SVE3:

SVE4: SVE5:

SVE6: SVE7: