
	R WELL RECORD Form WWC-5			Division of Water IAS13						
Original Record		e in Well Use		ources App. No.		Well ID				
1 LOCATION OF W		Fraction		ction Number	Township Numbe		ge Number			
County: Sedgwick		NE 1/4 SE 1/4 SE 1/4		6	T 29 S		■ E □ W			
2 WELL OWNER: Last Name: Saeed First: Mohammad Street or Rural Address where well is located (if unknown, distance										
Business:	an and de Dates		direction from nearest town or intersection): If at owner's address, check here:							
Address: 3008 Norr	mandy Drive		615 N. Rock Road, Derby							
City: McKinney State: TX ZIP: 75070										
3 LOCATE WELL										
WITH "X" IN	4 DEPTH OF COM	PLETED WELL:	22 fi	. 5 Latitude	37.54914	(decimal degrees)			
SECTION BOX:	Depth(s) Groundwater I	Encountered: 1)19	ft. Longitude: -97.24451 (decimal degrees)							
N N	2) ft. 3	6) ft., or 4)	Dry Well Horizontal Datum: ☐ WGS 84 ■ NAD 83 ☐ NAD 27							
	WELL'S STATIC WA			ft. Source for Latitude/Longitude:						
' '		measured on (mo-day-y		····· GPS (unit make/model:						
NW NE	☐ above land surface,	measured on (mo-day-y	/r)	(WAAS enabled? ☐ Yes ☐ No)						
	Pump test data: Well w			■ Land Survey □ Topographic Map						
W E	after hours	pumping §	gpm	☐ Onlin	Online Mapper:					
SW SE		rater was ft								
	after hours	pumping	gpm	6 Flavation	1: 1287.46 ft.	Ground	Laval T TOC			
	Estimated Yield:	gpm			Land Survey G					
S 1 mile	Bore Hole Diameter:	o in. to 2.2	. It. and		Other					
		in. to	ft.							
7 WELL WATER TO				10 5 5	1177. 2					
1. Domestic:		ter Supply: well ID			eld Water Supply: lea					
		g: how many wells?								
Lawn & Garden	7. ☐ Aquifer Re	charge: well ID			☐ Uncased ☐ G					
Livestock	8. \square Monitoring	g: well ID	10613		nal: how many bores?					
2. Irrigation		l Remediation: well ID		a) Closed Loop Horizontal Vertical						
3. Feedlot	Air Sparge		xtraction		b) Open Loop Surface Discharge Inj. of Water 13. Other (specify):					
4. Industrial	☐ Recovery	☐ Injection		13. \square Other	(specify):	••••••				
Was a chemical/bacter	riological sample subm	itted to KDHE? 🔲 Y	es 🔳 No	If yes, date sa	mple was submitted	:				
Water well disinfected?										
8 TYPE OF CASING	USED: ☐ Steel ■ PV	C Other	CASI	NG JOINTS:	Glued Clamped	☐ Welded	Threaded			
Casing diameter2	in. to 20 ft.,	Diameter	in. to	ft., Diameter	in. to	ft.				
Casing height above land s	surface10.32 in	Weight	lbs./ft.	Wall thicknes	s or gauge No. Sch.	4.0				
Casing diameter										
☐ Steel ☐ Stair	nless Steel	glass PVC		☐ Other (Specify)					
☐ Brass ☐ Galv	vanized Steel	ete tile	ed (open hole		• • • • • • • • • • • • • • • • • • • •					
SCREEN OR PERFOR	ATION OPENINGS AF	Æ:	•	,						
☐ Continuous Slot	■ Mill Slot □ Ga	uze Wrapped Tor	ch Cut 🔲 🛭	Orilled Holes	Other (Specify)					
	☐ Key Punched ☐ W	ire Wrapped Sav	v Cut 🔲 N	None (Open Hole)						
SCREEN-PERFORATI	ED INTERVALS: From	.20 ft. to .22	ft., From .	ft. to	ft., From	ft. to .	ft.			
GRAVEL PACK INTERVALS: From										
9 GROUT MATERIA	L: Neat cement	Cement grout Ben	tonite 🔲 (Other						
9 GROUT MATERIAL: ☐ Neat cement ☐ Cement grout ☐ Bentonite ☐ Other										
Nearest source of possibl	e contamination:									
☐ Septic Tank	☐ Lateral Line:			Livestock Pens	☐ Insectici	de Storage				
☐ Sewer Lines	☐ Cess Pool	☐ Sewage Lag		Fuel Storage	☐ Abandon	ned Water W	/ell			
☐ Watertight Sewer Lin		☐ Feedyard		Fertilizer Storage	Oil Well	/Gas Well				
Other (Specify) .Co	ntaminated site									
Direction from well?		Distance from we								
10 FROM TO	LITHOLOG	SIC LOG	FROM	TO LIT	HO. LOG (cont.) or F	LUGGING	INTERVALS			
	Asphalt									
	Clay, silty, Brown									
	Sand, vf-c, sl. silty, Gra	ay Brown								
	Sand, vf-c, Dark Gray	Brown								
	Clay, silty, Gray Brown									
	Clay, Gray Brown									
	Sand, vf-c, silty, Gray		Notes: K	DHE Project #U2	-087-12717					
	-a.ia, ti o, onty, oray		1,5005							
							,			
11 CONTRACTOR'S OR LANDOWNER'S CERTIFICATION: This water well was constructed, reconstructed, or plugged										
under my jurisdiction ar	nd was completed on (m	o-day-year) 4/29/20	21 and	this record is tr	ie to the best of my	knowledg	e and belief.			
under my jurisdiction and was completed on (mo-day-year) .4/29/2021 and this record is true to the best of my knowledge and belief. Kansas Water Well Contractor's License No. 527										
under the business name of GeoCore, LLC Signature Management of GeoCore, LLC										
Mail 1 white copy along with a fee of \$5.00 for each constructed well to: Kansas Department of Health and Environment, Bureau of Water, GWTS Section,										
	t., Suite 420, Topeka, Kansas 6									
Visit us at http://www.kdheks			KSA 82a-12		•		7/10/2015			

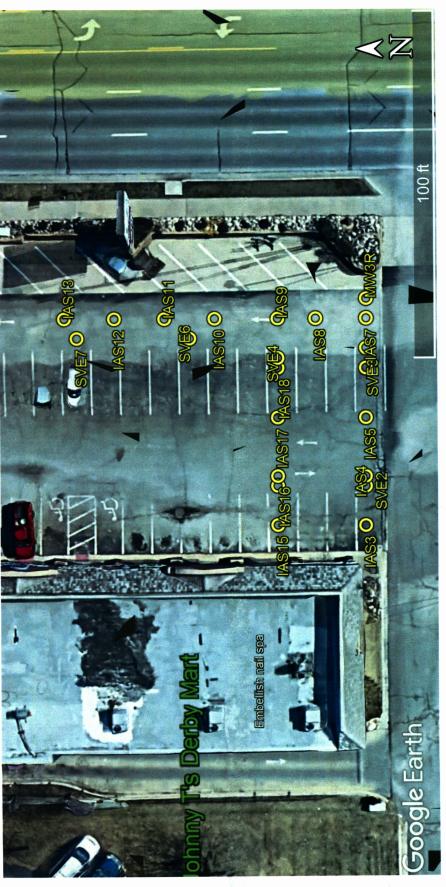

Project Site:

Johnny T's Derby Mart, 615 N. Rock Road, Derby

KDHE Project Code: U2-087-12717

GPS Coordinates:

AS11: 37.54906, -97.24451	37.54910, -97.24451	AS13: 37.54914, -97.24451	AS15: 37.54897, -97.24472	AS16: 37.54897, -97.24467	AS17: 37.54897, -97.24461	AS18: 37.54897, -97.24456
IAS11:	IAS12:	IAS13:	IAS15:	IAS16:	IAS17:	IAS18:
37.54890, -97.24472	37.54890, -97.24467	37.54890, -97.24461	37.54890, -97.24456	37.54890, -97.24451	37.54894, -97.24451	37.54897, -97.24451
IAS3:	IAS4:	IAS5:	IAS6:	IAS7:	IAS8:	IAS9:

MW3R: 37.54890, -97.24449

IAS10: 37.54902, -97.24451

37.54890, -97.24468 37.54890, -97.24454 37.54897, -97.24455 37.54897, -97.24468 37.54904, -97.24453 37.54913, -97.24453

SVE2: SVE3:

SVE4: SVE5:

SVE6: SVE7: