
WATER WELL R		WWC-5		ision of Water			SVE2			
Original Record		e in Well Use		ources App. No.		Well ID	\ \ \ \ \ \ \ \ \ \ \ \ \ \ \ \ \ \ \			
1 LOCATION OF W.	Fraction	Section Number Township Number				nge Number				
County: Sedgwick	SE 1/4 SE 1/4 SE 1/4		6	T 29 S		E D W				
2 WELL OWNER: La Business:	ast Name: Saeed		Street or Rural Address where well is located (if unknown, distance and							
	nandy Drive	· · · · · · · · · · · · · · · · · · ·	direction from nearest town or intersection): If at owner's address, check here:							
Address:	nanay Biivo		615 N. Rock Road, Derby							
City: McKinnev	State: TX	ZIP: 75070								
3 LOCATE WELL	4 DEPTH OF COM	IPLETED WELL:	10 n	5 Latitude	37.5489	0	(decimal degrees)			
WITH "X" IN SECTION BOX:		Encountered: 1)		ft. 5 Latitude: 37.54890 (decimal degrees) Longitude: -97.24468 (decimal degrees)						
SECTION BOX:		3) ft., or 4) \square	☐ Dry Well Horizontal Datum: ☐ WGS 84 ■ NAD 83 ☐ NAD 27							
		TER LEVEL:	ft. Source for Latitude/Longitude:							
' '		, measured on (mo-day-y		_ = = = (==============================						
NW NE		, measured on (mo-day-y		(WAAS enabled? ☐ Yes ☐ No)						
		vater was ft.			■ Land Survey □ Topographic Map □ Online Mapper:					
E	1	vater was ft.		Unii	ne Mapper:					
SW SE	i	s pumpingg			4007 FO					
	Estimated Yield:	gpm	-		n: 1287.53 ft.					
S	Bore Hole Diameter:	11 in. to10	. ft. and		Land Survey					
mile		in. to	ft.		Other	••••••				
7 WELL WATER TO		. 0 1 ""		10 🗖 0	11177					
1. Domestic: ☐ Household		ter Supply: well ID			ield Water Supply: le					
☐ Lawn & Garden		g: how many wells? echarge: well ID								
Livestock		g: well ID			nal: how many bores					
2. Irrigation		al Remediation: well ID			d Loop Horizont					
3. Feedlot	☐ Air Sparge	Soil Vapor E	xtraction		Loop Surface Di					
4. Industrial	☐ Recovery	☐ Injection		13. 🗌 Other	(specify):					
Was a chemical/bacter	iological sample subm	itted to KDHE? 🗆 Y	es No	If yes, date sa	imple was submitte	d:				
Water well disinfected?	☐ Yes ■ No									
8 TYPE OF CASING	USED: ☐ Steel ■ PV	C Other	CASI	NG JOINTS: [☐ Glued ☐ Clamped	l □ Welde	d 🔳 Threaded			
Casing diameter										
			lbs./ft.	Wall thickne	ss or gauge No. SCN	40				
TYPE OF SCREEN OR					(0					
	iless Steel		ed (open hole		(Specify)					
☐ Brass ☐ Galvanized Steel ☐ Concrete tile ☐ None used (open hole) SCREEN OR PERFORATION OPENINGS ARE:										
Continuous Slot			ch Cut 🗆 D	rilled Holes	Other (Specify)	·				
☐ Louvered Shutter	☐ Key Punched ☐ W	ire Wrapped	v Cut N	Ione (Open Hole						
SCREEN-PERFORATED INTERVALS: From .5 ft. to .10 ft., From ft. to ft. to ft.										
GRAVEL PACK INTERVALS: From										
9 GROUT MATERIA Grout Intervals: From	L: Neat cement	Cement grout Ben	ntonite 🔲 C	Other						
		ft., From f	t. to	ft., From	ft. to	ft.				
Nearest source of possible		□ n: n :	_	T: 1 D		· 1 - C4				
☐ Septic Tank☐ Sewer Lines	☐ Lateral Line ☐ Cess Pool	es	_	Livestock Pens Fuel Storage		ide Storage oned Water				
☐ Watertight Sewer Lin				Fertilizer Storage		ll/Gas Well	Well			
Other (Specify) .Contaminated site										
Direction from well?		Distance from we	11?							
10 FROM TO	LITHOLO		FROM	TO LI	THO. LOG (cont.) or	PLUGGIN	G INTERVALS			
	Silt, sandy, vf-f, claye									
5 10 5	Sand, f-c w/f gravel, B	Brown								
							•			
	· · · · · · · · · · · · · · · · · · ·									
			Notes: K	DHE Project #U2	2-087-12717					
11 CONTRACTORIS OR LANDOWNERDS CERTIFICATION. This was all the second of										
11 CONTRACTOR'S OR LANDOWNER'S CERTIFICATION: This water well was constructed, reconstructed, or plugged under my jurisdiction and was completed on (mo-day-year) .4/26/2021 and this record is true to the best of my knowledge and belief.										
Kansas Water Well Contractor's License No. 527 This Water Well Record was completed on (mo-day-year) .1/20/2022										
under the business name of GeoCore, LLC Signature										
Mail 1 white copy along with a fee of \$5.00 for each constructed well to: Kansas Department of Health and Environment, Bureau of Water, GWTS Section, 1000 SW Jackson St., Suite 420, Topeka, Kansas 66612-1367. Mail one to Water Well Owner and retain one for your records. Telephone 785-296-5524.										
					for your records. Teleph	one 785-296-	·5524.			
Visit us at http://www.kdheks	gov/waterwell/index.html		KSA 82a-12	.12		Kevised	7/10/2015			

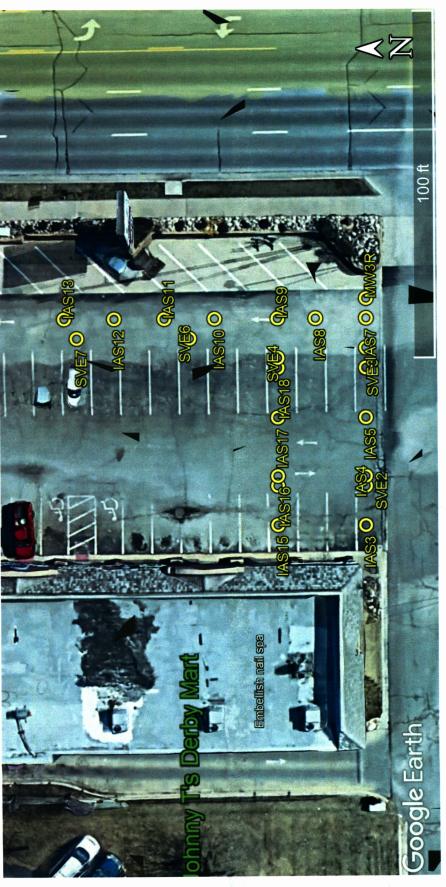

Project Site:

Johnny T's Derby Mart, 615 N. Rock Road, Derby

KDHE Project Code: U2-087-12717

GPS Coordinates:

AS11: 37.54906, -97.24451	37.54910, -97.24451	AS13: 37.54914, -97.24451	AS15: 37.54897, -97.24472	AS16: 37.54897, -97.24467	AS17: 37.54897, -97.24461	AS18: 37.54897, -97.24456
IAS11:	IAS12:	IAS13:	IAS15:	IAS16:	IAS17:	IAS18:
37.54890, -97.24472	37.54890, -97.24467	37.54890, -97.24461	37.54890, -97.24456	37.54890, -97.24451	37.54894, -97.24451	37.54897, -97.24451
IAS3:	IAS4:	IAS5:	IAS6:	IAS7:	IAS8:	IAS9:

MW3R: 37.54890, -97.24449

IAS10: 37.54902, -97.24451

37.54890, -97.24468 37.54890, -97.24454 37.54897, -97.24455 37.54897, -97.24468 37.54904, -97.24453 37.54913, -97.24453

SVE2: SVE3:

SVE4: SVE5:

SVE6: SVE7: