
			WWC-5		ivision of Water			SVE3			
		Correction Chang	e in Well Use		sources App. No.		Well ID				
1 LOCAT	ION OF V	VATER WELL:	Fraction		ection Number	Township Numb		ige Number			
	: Sedgwid		SE 1/4 SE 1/4 SE 1/4		6	T 29 S		■ E □ W			
2 WELL OWNER: Last Name: Saeed First: Mohammad Street or Rural Address where well is located (if unknown, distance											
Business	2000 11	man and a Data		direction fron	tion from nearest town or intersection): If at owner's address, check here:						
Address: Address:	3008 No	rmandy Drive		615 N. Rock Road, Derby							
City:											
3 LOCATE	McKinne		ZIP: 75070	· · · · · · · · · · · · · · · · · · ·							
WITH "Y		4 DEPTH OF COM	IPLETED WELL:	10	ft. 5 Latitud	e: 37.5489	0	(decimal degrees)			
SECTIO		Depth(s) Groundwater 1	Encountered: 1)	ft.	Longitu	de: -97.244	54	(decimal degrees)			
SECTION N			3) ft., or 4)	Horizontal Datum: WGS 84 NAD 83				83 \square NAD 27			
		WELL'S STATIC WA	WELL'S STATIC WATER LEVEL: ft.					55 — 141D 27			
	. !	☐ below land surface,	measured on (mo-day-	y r) .	□ GPS	Source for Latitude/Longitude: GPS (unit make/model:)					
NW	NE	☐ above land surface,	measured on (mo-day-		(WAAS enabled? ☐ Yes ☐ No)						
	F .	Pump test data: Well w	Pump test data: Well water was ft.			■ Land Survey □ Topographic Map					
w	E	after hours pumping gpm				Online Mapper:					
sw	SF	Well w	Well water was ft.								
		after hours	pumping	gpm	6 Florestic	6 Elevation: 1288.46ft. ■ Ground Level □ TOC					
		Estimated Yield:	Estimated Yield:gpm			Source: Land Survey GPS Topographic					
S			Bore Hole Diameter:11 in. to10				her				
			in. to	ft.	· I	Otner	• • • • • • • • • • • • • • • • • • • •	•••••			
1	VATERT	O BE USED AS:									
1. Domestic:	-1.1	5. ☐ Public Wa	ter Supply: well ID	•••••	10. ☐ Oil F	ield Water Supply: le					
Househ			g: how many wells?			le: well ID					
Lawn &		7. ∐ Aquifer Re	echarge: well ID								
Livesto		8. Monitoring	g: well ID	C)/E2		mal: how many bores					
2. Irrigation			l Remediation: well ID			ed Loop Horizont					
3. ☐ Feedlot 4. ☐ Industri		☐ Air Sparge		xtraction		Loop Surface Dis					
		☐ Recovery				r (specify):					
Was a chen	nical/bacte	eriological sample subm	itted to KDHE? 🔲 Y	Yes 🔳 No	If yes, date s	ample was submitte	d:				
Water well	disinfected	? ☐ Yes ■ No									
8 TYPE O	F CASINO	G USED: ☐ Steel ■ PV	C 🔲 Other	CAS	NG JOINTS: [☐ Glued ☐ Clamped	☐ Welded	Threaded			
Casing diame	eter4	in. to	Diameter	in. to	ft., Diamete	er in. to	ft.				
Casing height	t above land	surface7.08 in	Weight	lbs./ft.	Wall thickne	ss or gauge No. Sch.	. 40				
TYPE OF S	CREEN O	R PERFORATION MAT	TERIAL:								
☐ Steel	☐ Sta	inless Steel	glass PVC		☐ Other	(Specify)					
☐ Brass		vanized Steel	rete tile None us	ed (open ho							
SCREEN O	R PERFO	RATION OPENINGS AF	RE:								
☐ Continu		■ Mill Slot □ Ga	uze Wrapped Tor	ch Cut	Drilled Holes	Other (Specify)					
☐ Louver	red Shutter	☐ Key Punched ☐ Wi	ire Wrapped 🔲 Sav	v Cut 🔲	None (Open Hole	e)					
SCREEN-P	ERFORAT	ED INTERVALS: From	5 ft. to .10	ft., From	ft. to	ft., From	ft. to	ft.			
GR	RAVEL PA	CK INTERVALS: From	4 ft. to 10	ft., From	ft. to	ft., From	ft. to	ft.			
9 GROUT	MATERI	AL: Neat cement 3	Cement grout Ber	tonite 🔲	Other						
Grout Interva	ıls: From	3 ft. to4	. ft., From f	t. to	ft., From	ft. to	ft.				
Nearest sour	ce of possib	le contamination:									
☐ Septic T		Lateral Lines	_		Livestock Pens	☐ Insectic	ide Storage				
☐ Sewer L		☐ Cess Pool	☐ Sewage Lag		Fuel Storage		ned Water V	Well			
	ght Sewer Li		☐ Feedyard] Fertilizer Storag	ge 🔲 Oil Wel	ll/Gas Well				
Other (S	specify) .Co	ontaminated site		•••							
			Distance from we								
10 FROM	TO	LITHOLOG		FROM	TO LI	THO. LOG (cont.) or	PLUGGING	3 INTERVALS			
		Silt, sandy, sl. clayey,									
5	10	Sand, f-c w/f gravel, B	rown					*			
	A										
			_					100			
	Notes: KDHE Project #U2-087-12717										
				1							
11 CONTRACTOR'S OR LANDOWNER'S CERTIFICATION: This water well was constructed, reconstructed, or plugged											
under my ju	risdiction a	and was completed on (m	o-day-year) .4/27/20	21 and	this record is t	rue to the best of my	knowledg	ge and belief.			
Kansas Wat	er Well Co	ntractor's License No5	27 This Wat	er Well Re	cord was comp	eted on (mo-day-ye	ear) .1/20/2	2022			
under the bu	isiness nam	ie of GeoCore, LLC		S	ignature . A.C.	le Holl					
		ong with a fee of \$5.00 for each									
		St., Suite 420, Topeka, Kansas 6				for your records. Telepho					
Visit us at http:	://www.kdhek	s.gov/waterwell/index.html		KSA 82a-1:	212		Kevised	7/10/2015			

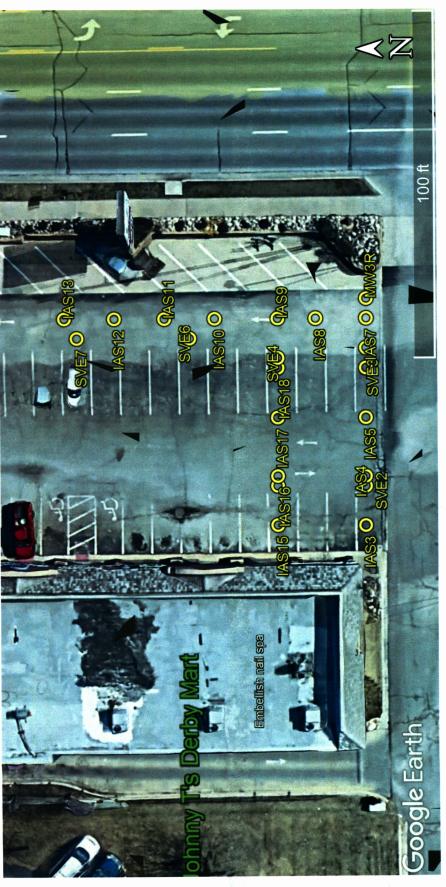

Project Site:

Johnny T's Derby Mart, 615 N. Rock Road, Derby

KDHE Project Code: U2-087-12717

GPS Coordinates:

AS11: 37.54906, -97.24451	37.54910, -97.24451	AS13: 37.54914, -97.24451	AS15: 37.54897, -97.24472	AS16: 37.54897, -97.24467	AS17: 37.54897, -97.24461	AS18: 37.54897, -97.24456
IAS11:	IAS12:	IAS13:	IAS15:	IAS16:	IAS17:	IAS18:
37.54890, -97.24472	37.54890, -97.24467	37.54890, -97.24461	37.54890, -97.24456	37.54890, -97.24451	37.54894, -97.24451	37.54897, -97.24451
IAS3:	IAS4:	IAS5:	IAS6:	IAS7:	IAS8:	IAS9:

MW3R: 37.54890, -97.24449

IAS10: 37.54902, -97.24451

37.54890, -97.24468 37.54890, -97.24454 37.54897, -97.24455 37.54897, -97.24468 37.54904, -97.24453 37.54913, -97.24453

SVE2: SVE3:

SVE4: SVE5:

SVE6: SVE7: