
WATER WELL R		WWC-5		sion of Water			SVE4			
Original Record 1 LOCATION OF W		ge in Well Use		urces App. No.	Township North	Well ID	Moush			
County: Sedgwick	Fraction SE 1/4 SE 1/4 SE 1/4				ge Number ■ E □ W					
2 WELL OWNER: L			Street or Rural Address where well is located (if unknown, distance and							
Business:			direction from nearest town or intersection): If at owner's address, check here:							
Address: 3008 Norr	mandy Drive	615 N. Rock Road, Derby								
City: McKinney	State: TX	ZIP: 75070		, 100.0, _ 0.1.	,					
3 LOCATE WELL		MPLETED WELL: .	10 в	5 I adda.da	37.5489	7	(1 : 11)			
WITH "X" IN	1	Encountered: 1)		5 Latitude	-97 244	 55	(decimal degrees)			
SECTION BOX:		3) ft., or 4)								
	1	ATER LEVEL:	ft. Source for Latitude/Longitude:							
		e, measured on (mo-day-		G S S (unit mane) model						
NW NE		e, measured on (mo-day- water was fi		(WAAS enabled? Yes No)						
w	after hour	rs pumping	gpm	■ Land Survey □ Topographic Map □ Online Mapper:						
SW SE		water was fi								
		rs pumping	gpm	6 Elevation: 1288.06ft. ■ Ground Level □ TOC						
S	Estimated Yield:gpm Bore Hole Diameter:11in. to10ft. and				Source: Land Survey GPS Topographic Map					
mile	1	in. to			Other					
7 WELL WATER TO										
1. Domestic:	5. ☐ Public W	ater Supply: well ID	•••••		eld Water Supply: le					
☐ Lawn & Garden	6. ☐ Dewatern 7. ☐ Aquifer R	ng: how many wells? Recharge: well ID	••••••							
Livestock	8. Monitorii	ng: well ID			al: how many bores					
2. Irrigation	Environment	tal Remediation: well ID	SVE4	a) Closed	a) Closed Loop					
3. ☐ Feedlot 4. ☐ Industrial	☐ Air Sparg		Extraction		Loop Surface Dis					
	Recovery				(specify):					
Was a chemical/bacter Water well disinfected?	riological sample subr	nitted to KDHE?	Yes No	If yes, date sa	nple was submitted	1:				
8 TYPE OF CASING	USED: Steel PV	IC Other	CASIN	G IOINTS: F	Chied Clamped	□ Welded	Threaded			
Casing diameter 4	in. to5 ft.	. Diameter	in. to	ft Diameter	in. to	weided	1 meaded			
Casing height above land s	surface8.40 in	n. Weight			or gauge No. Sch.					
TYPE OF SCREEN OR										
	nless Steel		sed (open hole)		Specify)	• • • • • • • • • • • • • • • • • • • •				
SCREEN OR PERFOR			sed (open note)							
☐ Continuous Slot	■ Mill Slot □ G	Sauze Wrapped To:	rch Cut 🔲 Di	illed Holes 🔲	Other (Specify)					
☐ Louvered Shutter	☐ Kev Punched ☐ V	Vire Wrapped	w Cut □ No	one (Open Hole)						
SCREEN-PERFORATE	ED INTERVALS: From	n .5 ft. to .10	ft., From	ft. to	ft., From	ft. to	ft.			
	CK INTERVALS: From									
9 GROUT MATERIA Grout Intervals: From	3 ft. to 4	ft From	ntonite 🔲 Oi	ner ft From	ft to	ff				
Nearest source of possible	e contamination:	, 1 10111		10, 1 10111		16.				
Septic Tank	☐ Lateral Line	_		Livestock Pens	☐ Insection					
☐ Sewer Lines ☐ Watertight Sewer Lin	☐ Cess Pool nes ☐ Seepage Pit	☐ Sewage Lag ☐ Feedyard		Fuel Storage Fertilizer Storage	☐ Abando: ☐ Oil Wel		Vell			
Other (Specify) .Co	ntaminated site		••••			Jas WEII				
Direction from well?		Distance from we	11?							
10 FROM TO	LITHOLO		FROM	TO LIT	HO. LOG (cont.) or	PLUGGING	3 INTERVALS			
	<u>Silt, sandy (vf-f), sl. cl</u> Sand, f-c w/f gravel, E		-							
5 10	Sand, i-c w/i gravei, i	Brown	 							
	Notes: KDHE Project #U2-087-12717									
11 CONTRACTORS	OD I ANDOUNEDA	C CEDTIEIO ATION	This	11		4				
11 CONTRACTOR'S OR LANDOWNER'S CERTIFICATION: This water well was constructed, reconstructed, or plugged under my jurisdiction and was completed on (mo_day-year) .4/28/2021 and this record is true to the best of my knowledge and belief.										
Kansas Water Well Contractor's License No. 527 This Water Well Record was completed on (mo-day-year) .1/20/2022										
under the business name of GeoCore, LLC Signature Mail 1 white copy along with a fee of \$5.00 for each constructed well to: Kansas Department of Health and Environment, Bureau of Water, GWTS Section,										
Mail I white copy alo	ong with a fee of \$5.00 for ea	ch constructed well to: Kan	sas Department (of Health and Envi	ronment, Bureau of Wa	ter, GWTS S	ection, 5524			
1000 SW Jackson St., Suite 420, Topeka, Kansas 66612-1367. Mail one to Water Well Owner and retain one for your records. Telephone 785-296-5524. Visit us at http://www.kdheks.gov/waterwell/index.html KSA 82a-1212 Revised 7/10/2							7/10/2015			

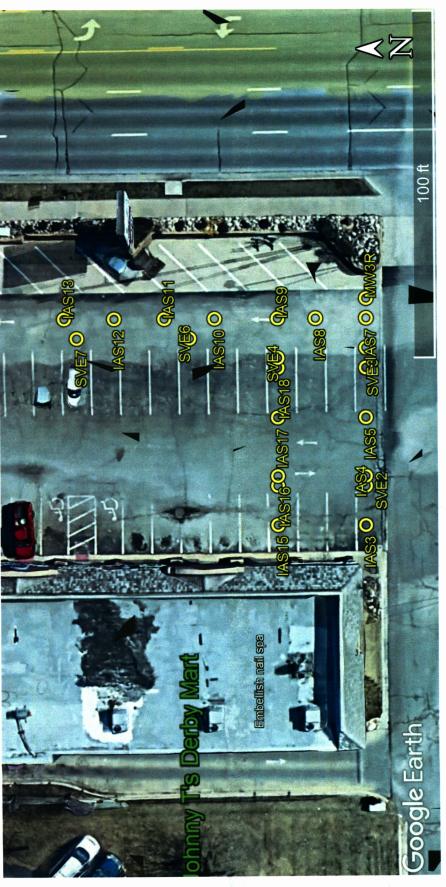

Project Site:

Johnny T's Derby Mart, 615 N. Rock Road, Derby

KDHE Project Code: U2-087-12717

GPS Coordinates:

AS11: 37.54906, -97.24451	37.54910, -97.24451	AS13: 37.54914, -97.24451	AS15: 37.54897, -97.24472	AS16: 37.54897, -97.24467	AS17: 37.54897, -97.24461	AS18: 37.54897, -97.24456
IAS11:	IAS12:	IAS13:	IAS15:	IAS16:	IAS17:	IAS18:
37.54890, -97.24472	37.54890, -97.24467	37.54890, -97.24461	37.54890, -97.24456	37.54890, -97.24451	37.54894, -97.24451	37.54897, -97.24451
IAS3:	IAS4:	IAS5:	IAS6:	IAS7:	IAS8:	IAS9:

MW3R: 37.54890, -97.24449

IAS10: 37.54902, -97.24451

37.54890, -97.24468 37.54890, -97.24454 37.54897, -97.24455 37.54897, -97.24468 37.54904, -97.24453 37.54913, -97.24453

SVE2: SVE3:

SVE4: SVE5:

SVE6: SVE7: