
WATER WELL R		Form '	WWC-5	Di	vision of Water		MW-2	
Original Record			e in Well Use		ources App. No		Well ID	
1 LOCATION OF W	ATER WEI	LL:	Fraction		ction Number	Township Numl		
County: Crawford			NW 1/4 NE 1		24	T 29 S	R 23 ■ E 🗆 V	
2 WELL OWNER: L			First:				(if unknown, distance and	
Business: Pete's Corporation direction from nearest town or intersection): If at owner's address, check here:								
Address: 1712 Broadway Former Pump N Pete's Gas Station								
City: Parsons State: KS ZIP: 67357 307 West St.					St. John Stree	et, Girard, KS 667	43	
3 LOCATE WELL	1							
	WITH "Y" IN 4 DEPTH OF COMPLETED WELL:42,9 II. 5 Latitude:							
SECTION BOX:	Depth(s) Groundwater Encountered: 1) 5.0 ft. Longitude: -94.84707 (decimal							
2) NA it. 3) NA ft., or 4) Dry Well Horizontal Datum: WGS 84 D								
	WELL'S STATIC WATER LEVEL: 5.69 ft. ■ below land surface, measured on (mo-day-yr).11/16/2023 □ above land surface, measured on (mo-day-yr)							
1 1 1								
NW NE								
W	Pump test data: Well water was							
	Well water wasN/A ft.							
SW SF	anci.::::::::::::::::::::::::::::::::::::							
	Estimated Yield:N/Agpm 6 Elevation: 307.03fi.							
S	Bore Hole	Diameter:	7.25 in to 7.5	ft. and			GPS Topographic M	
mile			6.0 in to 25.0	! ft.		Uther		
7 WELL WATER TO					🗆			
1. Domestic:			ater Supply: well ID				lease	
☐ Household ☐ Lawn & Garden			ig: how many wells?			ole: well ID		
Livestock	7. ☐ Aquifer Recharge: well ID							
2. Trrigation		9. Environmental Remediation: well ID					ntal	
3. Feedlot		Air Sparg			b) Ope	en Loon Surface D	ischarge Inj. of Water	
4. Industrial		Recovery	•					
Was a chemical/hacter	riological sa	mple subn	nitted to KDHE?	Ves No	If yes, dates	sample was submitt	ed.	
Was a chemical/bacteriological sample submitted to KDHE? ☐ Yes ■ No If yes, date sample was submitted:								
9 TYPE OF CASING USED. Seed DVC Other CASING JOINTS: Glood Glowned Wolded Throught								
Casing diameter 2 in to 5.0 ft Diameter N/A in to N/A ft Diameter N/A in to N/A ft								
Water well disinfected? ☐ Yes ■ No 8 TYPE OF CASING USED: ☐ Steel ■ PVC ☐ Other								
TYPE OF SCREEN OR PERFORATION MATERIAL:								
☐ Steel ☐ Stainless Steel ☐ Fiberglass ■ PVC ☐ Other (Specify)								
☐ Brass ☐ Galvanized Steel ☐ Concrete tile ☐ None used (open hole)								
SCREEN OR PERFORATION OPENINGS ARE:								
☐ Continuous Slot ☐ Mill Slot ☐ Gauze Wrapped ☐ Torch Cut ☐ Drilled Holes ☐ Other (Specify)								
□ Louvered Shutter □ Key Punched □ Wire Wrapped □ Saw Cut □ None (Open Hole)								
SCREEN-PERFORATED INTERVALS: From 5.0 ft. to 20.0 ft., From N/A ft. to N/A ft. to N/A ft. to N/A ft.								
GRAVEL PACK INTERVALS: From4.0 ft. to25.0 ft., FromN/Aft. toN/Aft., FromN/Aft. toN/Aft.								
9 GROUT MATERIAL: Neat cement Cement grout Bentonne Other Concrete 0 to 2 Grout Intervals: From 2 ft. to 4.0 ft., From N/A ft. from N/A ft. From N/A ft. o N/A ft.								
Grout Intervals: From		o .:::!!	ft., 1 rom!V/A	. It. toINU	A It., I rom	!\\\\\\\\\\\\\\\\\\\\\\\\\\\\\\\\\\	A II.	
Nearest source of possib	_	ion: Lateral Line	es	_	Livestock Pen	a Diaman	icide Storage	
Sewer Lines		Cess Pool	Sewage L		Fuel Storage		doned Water Well	
☐ Watertight Sewer Li		Seepage Pi			Fertilizer Stora		'ell'Gas Well	
Other (Specify)					, , , , , , , , , , , , , , , , , , , ,			
Direction from well?				vell?		f	ì	
10 FROM TO		LITHOLO		FROM	TO I	LITHO. LOG (cont.)	or PLUGGING INTERVA	
	Detailed bo	ring logs a	attached					
				Notes:				
11 CONTRACTOR'S OR LANDOWNER'S CERTIFICATION: This water well was constructed, or plugged under my jurisdiction and was completed on (mo-day-year) 11/8/2023 and this record is true to the best of my knowledge and belief.								
under my jurisdiction a	nd was comp	oleted on (r	no-day-year) .1.1/8/2 759 - Thi 19	19.49 and	this record is	true to the best of r	ny knowledge and belic	
Kansas Water Well Contractor's License No. 759 This Water Well Record was Completed or (no-day-year) 12/16/2023 under the business name of RAZEK Environmental LLC Signature								
Mail 1 white copy al	ong with a fee o	C\$5,00 for ea	ich constructed well to: K	ansas Denartme	nt of Health and F	invironment. Bureau of V	Water, GW La Section.	
Mail 1 white copy along with a fee of \$5.00 for each constructed well to: Kansas Department of Health and Environment, Bureau of Water, GW 13-Section, 1000 SW Jackson St., Suite 420, Topeka, Kansas 66612-1367. Mail one to Water Well Owner and retain one for your records. Telephone 785-296-5524.								
Visit us at http://www.kdhek				220			Revised 7/10/2015	

County Crawford



Crawford County

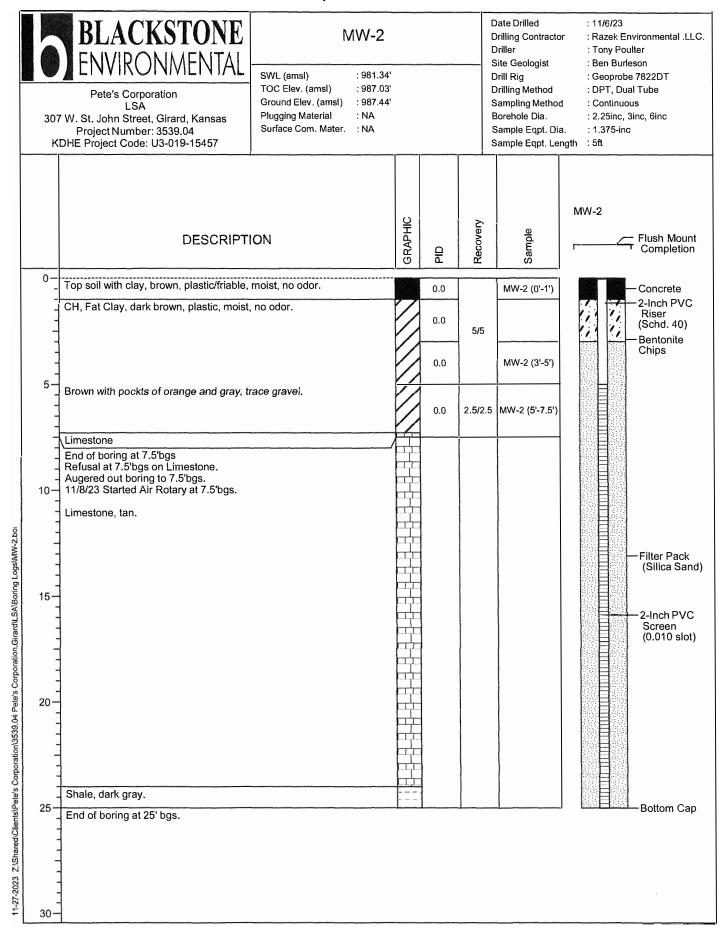