
KOLAR Document ID: 1497217

| | | | | | | Division of Water | | | | | | |
|--|--|------------------------------------|--|--|---|---|-------------------|--------------------------|------------|-------------|--|--|
| | | | | | | rces App. N | | T | Well ID | N 1 | | |
| 1 LOCATION OF WATER WELL: County: | | | Fraction 1/4 1/4 1/4 | Section | on Numbe | r | Township Number F | | nge Number | | | |
| 2 WELL O | | | | Street or Rural Address where well is lo | | | | | | □ E □ W | | |
| Business: | WINER: La | ist name: | | | | | | | | | | |
| Business: Address: direction from nearest town or intersection): If at owner's address, check here: | | | | | | | | | | | | |
| Address: | | | | | | | | | | | | |
| City: | | State: | ZIP: | | | T | | | | | | |
| 3 LOCATE | | IPLETED WELL: | D WELL: ft. | | | 5 Latitude:(decimal degrees) | | | | | | |
| WITH "A" IN Donth(a) Groundwater I | | | Encountered: 1) ft. | | | Longitude: | | | | | | |
| SECTION BOX: 2) ft. 3 | | | 3) ft., or 4) ☐ Dry Well | | | Datum: WGS 84 NAD 83 NAD 27 | | | | | | |
| | | | IC WATER LEVEL: ft. | | | Source for Latitude/Longitude: | | | | | | |
| | 1 | | below land surface, measured on (mo-day-yr) | | | | PS (ı | ınit make/model: | |) | | |
| NW | - NE | | above land surface, measured on (mo-day-yr) p test data: Well water was ft. | | | (| | | | | | |
| | | | | | | ☐ Land Survey ☐ Topographic Map | | | | | | |
| W | E | | afterhours pumpinggpm Well water wasft. | | | ☐ Online Mapper: | | | | | | |
| SW - | SE - 🗙 | after hours pumping gpm | | | | | | | | | | |
| | | Estimated Yield:gpm | | | | 6 Elevation :ft. ☐ Ground Level ☐ TOC | | | | | | |
| S | | Bore Hole Diameter: in. to ft. and | | | | Source: Land Survey GPS Topographic Map | | | | | | |
| 1 mi | | | in. to ft. | | | | ☐ Other | | | | | |
| 7 WELL WATER TO BE USED AS: | | | | | | | | | | | | |
| 1. Domestic: | | | ter Supply: well ID | | | | | ld Water Supply: le | | | | |
| | | | ng: how many wells? | | | 11. Test Hole: well ID | | | | | | |
| | | | echarge: well ID | | | ☐ Cased ☐ Uncased ☐ Geotechnical 12. Geothermal: how many bores? | | | | | | |
| | | | g: well IDal Remediation: well ID | | | | | | | | | |
| 2. ☐ Irrigation 9. Environmenta 3. ☐ Feedlot ☐ Air Sparge | | | | ••• | a) Closed Loop ☐ Horizontal ☐ Vertical b) Open Loop ☐ Surface Discharge ☐ Inj. of Water | | | | | | | |
| 4. ☐ Industrial ☐ Recovery | | | | | | 13. Other (specify): | | | | | | |
| * * * * | | | | | | | | | | | | |
| Was a chemical/bacteriological sample submitted to KDHE? ☐ Yes ☐ No If yes, date sample was submitted: | | | | | | | | | | | | |
| Water well disinfected? No CASING JOINTS: Chied Clamped Welded Threeded | | | | | | | | | | | | |
| 8 TYPE OF CASING USED: Steel PVC Other CASING JOINTS: Glued Clamped Welded Threaded | | | | | | | | | | | | |
| Casing diameter | | | | | | | | | | | | |
| TYPE OF SCREEN OR PERFORATION MATERIAL: | | | | | | | | | | | | |
| TYPE OF SCREEN OR PERFORATION MATERIAL: ☐ Steel ☐ Stainless Steel ☐ PVC ☐ Other (Specify) | | | | | | | | | | | | |
| ☐ Brass ☐ Galvanized Steel ☐ None used (open hole) | | | | | | | | | | | | |
| SCREEN OR PERFORATION OPENINGS ARE: | | | | | | | | | | | | |
| ☐ Continuous Slot ☐ Mill Slot ☐ Gauze Wrapped ☐ Torch Cut ☐ Drilled Holes ☐ Other (Specify) | | | | | | | | | | | | |
| □ Louvered Shutter □ Key Punched □ Wire Wrapped □ Saw Cut □ None (Open Hole) | | | | | | | | | | | | |
| SCREEN-PERFORATED INTERVALS: From | | | | | | | | | | | | |
| GRAVEL PACK INTERVALS: From ft. to ft. to | | | | | | | | | | | | |
| 9 GROUT MATERIAL: Neat cement Cement grout Bentonite Other | | | | | | | | | | | | |
| | | ft. to | | | | | | ft. to | ft. | | | |
| | | e contamination: No | | | | | | | | | | |
| ☐ Septic Ta | | Lateral Lines | | | | ivestock Per | | ☐ Insectic | | | | |
| ☐ Sewer Li | | | ☐ Sewage Lag | | | | | ☐ Abando | | | | |
| □ Watertight Sewer Lines □ Seepage Pit □ Feedyard □ Fertilizer Storage □ Oil Well/Gas Well □ Other (Specify) □ Oil Well/Gas Well | | | | | | | | | | | | |
| Direction from well? ft. | | | | | | | | | | | | |
| 10 FROM | TO | LITHOLOG | | FROM | | | | HO. LOG (cont.) or | | G INTERVALS | | |
| | | | | | | | | , , | | | | |
| | | | | | | | | | _ | | | |
| | | | | | | | | | | | | |
| | | | | | | | | | _ | | | |
| | | | | | | | | | _ | | | |
| | | | | | | | | | | | | |
| | | | | Notes: | | | | | | | | |
| | | | | | | | | | | | | |
| | | | | | | | | | | | | |
| 11 CONTRACTOR'S OR LANDOWNER'S CERTIFICATION: This water well was constructed, reconstructed, or plugged | | | | | | | | | | | | |
| under my jurisdiction and was completed on (mo-day-year) | | | | | | | | | | | | |
| Kansas Wate | er Well Con | tractor's License No | This Wa | ter Well l | Recor | rd was con | nple | ted on (mo-day-ye | ar) | | | |
| under the bus | siness name | e of | FII OWNER and ratain a | ne for your | record | s Fee of ¢5 | 00 £ | or each constructed well | [] | | | |
| Send one copy to WATER WELL OWNER and retain one for your records. Fee of \$5.00 for each constructed well. KS Department of Health and Environment, Bureau of Water, Geology Section, 1000 SW Jackson St., Suite 420, Topeka, Kansas 66612-1367. Telephone 785-296-3565. | | | | | | | | | | | | |
| | Visit us at http://www.kdheks.gov/waterwell/index.html KSA 82a-1212 | | | | | | | | | | | |

19860

FULL SITE SURVEY

Casey's 1184

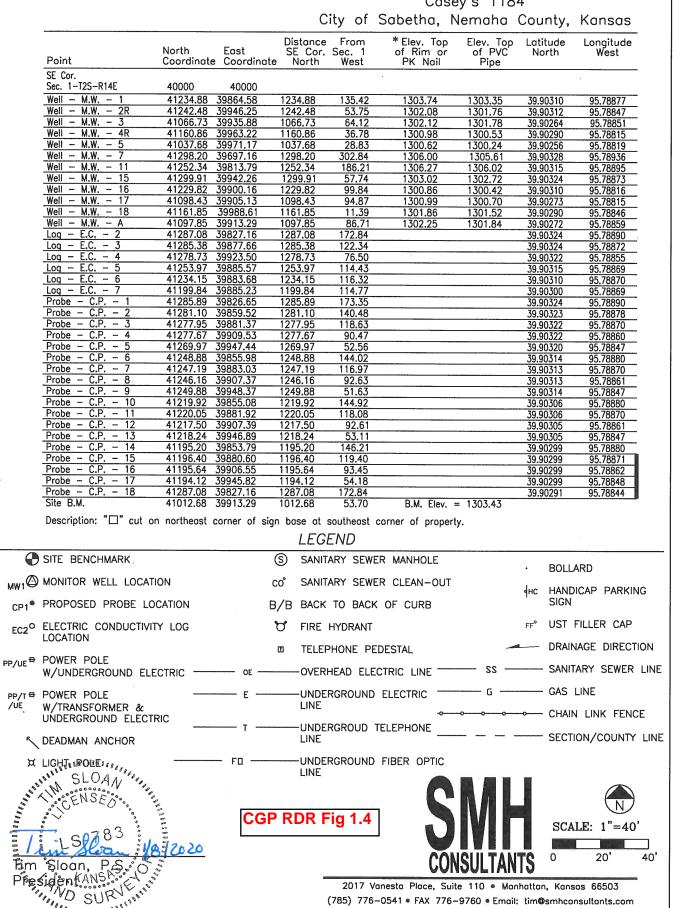

SURVEY SURVEY SEEDS

Ø MW7 MW15 EC3 e^{EC2} CP1 CP2 O_{EC4} CP3 CP4 GRASS CP5 COUNTY FINUSS Ø MW11 °EC5 eCP9 CP6 CP7 ∆ MW2R MW16 Ø_{MW1} °EC6 CP10 CP11 CP12 **CP13** OEC7 CP15 CP17 GRASS /CP18 CONC /MW18 CONC DRIVE Ø MW4R HEIGH. TELEPHONE VAULT VAULT 7.0' OE 20.3 /UE ri SHED ROCK **GRASS** TIME ACT CONC FF⁸ 1/2" REBAR W/ LS1314 CAP s' CONC WALL റാ നാ MW17 CONC WALK HEIGHT 55.0 13.7 SS CANOPY HEIGH1 GRASS 010 ASF 19.2 ONE STORY BRICK BUILDING ON CONC SLAB CONC METAL CANOPY GRASS -53' B/B-CONC MW5 5' CHAIN ' ON CONC CASEY'S PYLON SIGN ON CONC PAD CONC CONC WALK ¤.H GRASS **GRASS** CONC MPH ະVIRGINIA STREET Ē ASPHALT SURFACING B

> 2017 Vanesta Place, Suite 110 . Manhattan, Kansas 66503 (785) 776-0541 • FAX 776-9760 • Email: tim@smhconsultants.com Project #1912MN1374 DD #116