
WATER WELL R		Form W		_	ision of Wate	£	WV/9		
Original Record					ources App. N		Well ID er Range Number		
1 LOCATION OF W	ATER WEI		Fraction	1	tion Numbe	1 '-	R 7 ME W		
County, West of the County of									
2 WELL OWNER: I			First:	Street of Ru	ral Address	where well is located	(i) tinknown, distance and		
Business: City of Marysville Address: 209 N. 8th Street							s sources, check har.		
Address:	10	617 Broadway, Marysville							
City: Marysville		State: KS	ZIP: 66508						
3 LOCATE WELL	1	LOP COM	PLETED WELL:	28 A	E T adda.	39.8414	9(decimal degrees)		
WITH "X" IN			ncountered: 1)2		- 5 Laure	-98 649	(decimal degrees)		
SECTION BOX:	2)	100000WBIEFE		Dry Well	y Well Horizontal Datum: ☐ WGS 84 ■ NAD 83 ☐ NAD 27				
N	WELL'S STATIC WATER LEVEL:15					87 ft Source for Latitude/Longitude			
X	below land surface, measured on (mo-day					GPS (unit make/model: Spectro Precision Epo.)			
NW NE	above land surface, measured on (mo-day-				.	(WAAS enabled? ☐ Yes ■ No)			
	Pump test data: Well water was				☐ Land Survey ☐ Topographic Map				
W	after	after hours pumping gpm				Online Mapper:			
SWSE		Well water was ft. after hours pumping gpm							
				gpm	6 Eleva	tion: 1155.16 դ	Ground Level TOC		
S	Pore Hole	Yield: Diometer:	8 in. to 28	ft and	Source	: Land Survey	GPS Topographic Map		
mile	Dole Hose		in. to			☐ Other			
7 WELL WATER TO BE USED AS:									
1. Domestic:			r Supply: well ID	***************	10. 🔲 Oil	Field Water Supply: k	ease ,		
☐ Household	ehold 6. Dewatering: how many wells?					11. Test Hole: well ID			
Lawn & Garden						☐ Cased ☐ Uncased ☐ Geotechnical			
Livestock						12. Geothermal: how many bores?			
2. 1rrigation	Remediation: well II		a) Closed Loop Horizontal Vertical b) Open Loop Surface Discharge Inj. of Water						
3. ☐ Feedlot 4. ☐ Industrial			Soil Vapor I	xtraction					
Was a chemical/bacteriological sample submitted to KDHE? Yes No If yes, date sample was submitted:									
Water well disinfected? ☐ Yes ■ No									
8 TYPE OF CASING USED: Steel PVC Other									
Casing diameter in. to ft., Diameter ft.,									
Casing height above land surface									
TYPE OF SCREEN OR PERFORATION MATERIAL: Steel Stainless Steel Fiberglass PVC Other (Specify)									
Brass Galvanized Steel Concrete tile None used (open hole)									
SCREEN OR PERFORATION OPENINGS ARE:									
Continuous Slot Mill Slot Gauze Wrapped Torch Cut Drilled Holes Other (Specify)									
□ Louvered Shutter □ Key Punched □ Wire Wrapped □ Saw Cut □ None (Open Hole)									
SCREEN-PERFORATED INTERVALS: From18									
GRAVEL PACK INTERVALS: From									
9 GROUT MATERIAL: Neat cement Cement grout Bentonite Other Concrete									
Grout Intervals: From									
Nearest source of possible contamination:									
☐ Septic Tank ☐ Lateral Lines ☐ Pit Privy ☐ Livestock Pens ☐ Insecticide Storage									
☐ Sewer Lines ☐ Cess Pool ☐ Sewage Lagoon ☐ Fuel Storage ☐ Abandoned Water Well ☐ Watertight Sewer Lines ☐ Seepage Pit ☐ Feedvard ☐ Fertilizer Storage ☐ Oil Well/Gas Well									
□ Watertight Sewer Lines □ Seepage Pit □ Feedyard □ Fertilizer Storage □ Oil Well/Gas Well ■ Other (Specify) .Contaminated site									
Direction from well?									
10 FROM TO	1	ITHOLOGI	CLOG	FROM	TO	LITHO. LOG (cont.) or	PLUGGING INTERVALS		
	Asphalt								
0.5	Clay, silty, D	ark Grav							
3 9	Clay, silty, C		to Brown						
9 21	lay, sl. silty, Brown								
21 23		and, vf-m, silty, Brown							
	Sand, vi-c, l								
		Notes:							
11 CONTRACTOR'S OR LANDOWNER'S CERTIFICATION: This water well was constructed, reconstructed, or plugged									
under my invisidiction and was completed on (mo-day-year) 1/25/2019 and this record is true to the best of my knowledge and belief.									
Kansas Water Well Contractor's License No. 527 This Water Well Record was completed on (mo-day fear) 2/15/2019 under the business name of GeoCote Inc									
under the business nam	e of GeoCo	re inc		Si	gnature .X	Environment Russes of III	ater GWTS Section		
Mail 1 white copy along with a fee of \$5.00 for each constructed well to: Kansas Department of Health and Environment, Bureau of Water, GWTS Section, 1000 SW Jackson St., Suite 420, Topeka, Kansas 66612-1367. Mail one to Water Well Owner and retain one for your records. Telephone 785-296-5524.									
Visit us at http://www.kdheks			3012-130/. MAN ONE 10 \	KSA 82a-12	212	in to: Lom tocolds. Telebi	Revised 7/10/2015		
I TIDE US ALTRUP, // WWW, KUTIEK!	S. EUY! WALL WELL	HIMPA.HHIII							

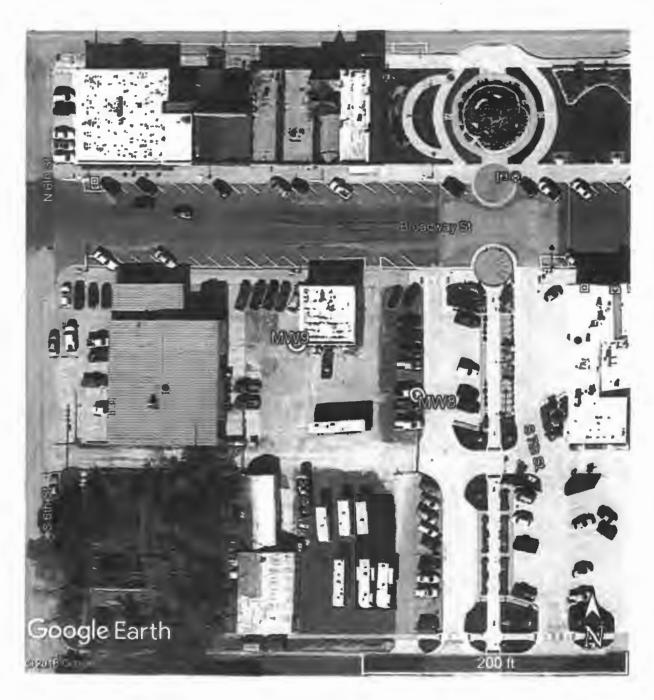

Marysville, City of 209 N. 8th Street Marysville, KS 66508

Site Address: 617 Broadway, Marysville KDHE Project Code: U4 058 00732

GPS Coordinates:

MW9: 39.84149, -96.64984

MAR 0 8 2019 BUREAU OF WATER

(MW8 was previously installed)