

WATER WELL RECORD Form WWC-5

Original Record Correction Change in Well Use

Division of Water Resources App. No.

Well ID MW-13

1 LOCATION OF WATER WELL: Fraction Section Number Township Number Range Number

2 WELL OWNER: Last Name: First: Street or Rural Address where well is located

3 LOCATE WELL WITH "X" IN SECTION BOX: 4 DEPTH OF COMPLETED WELL: 5 Latitude: Longitude: Elevation:

7 WELL WATER TO BE USED AS: 1. Domestic: 2. Irrigation: 3. Feedlot: 4. Industrial: 5. Public Water Supply: well ID: 6. Dewatering: how many wells?: 7. Aquifer Recharge: well ID: 8. Monitoring: well ID: MW-13: 9. Environmental Remediation: well ID: 10. Oil Field Water Supply: lease: 11. Test Hole: well ID: 12. Geothermal: how many bores?: 13. Other (specify):

Was a chemical/bacteriological sample submitted to KDHE? Water well disinfected?

8 TYPE OF CASING USED: CASING JOINTS: Casing diameter: Casing height above land surface: TYPE OF SCREEN OR PERFORATION MATERIAL:

SCREEN OR PERFORATION OPENINGS ARE: SCREEN-PERFORATED INTERVALS: GRAVEL PACK INTERVALS:


9 GROUT MATERIAL: Grout Intervals: Nearest source of possible contamination:

Direction from well? Distance from well?

Table with columns FROM, TO, LITHOLOGIC LOG, FROM, TO, LITHO. LOG (cont.) or PLUGGING INTERVALS

Notes:

11 CONTRACTOR'S OR LANDOWNER'S CERTIFICATION: This water well was constructed, reconstructed, or plugged under my jurisdiction and was completed on (mo-day-year) 5/10/2021...

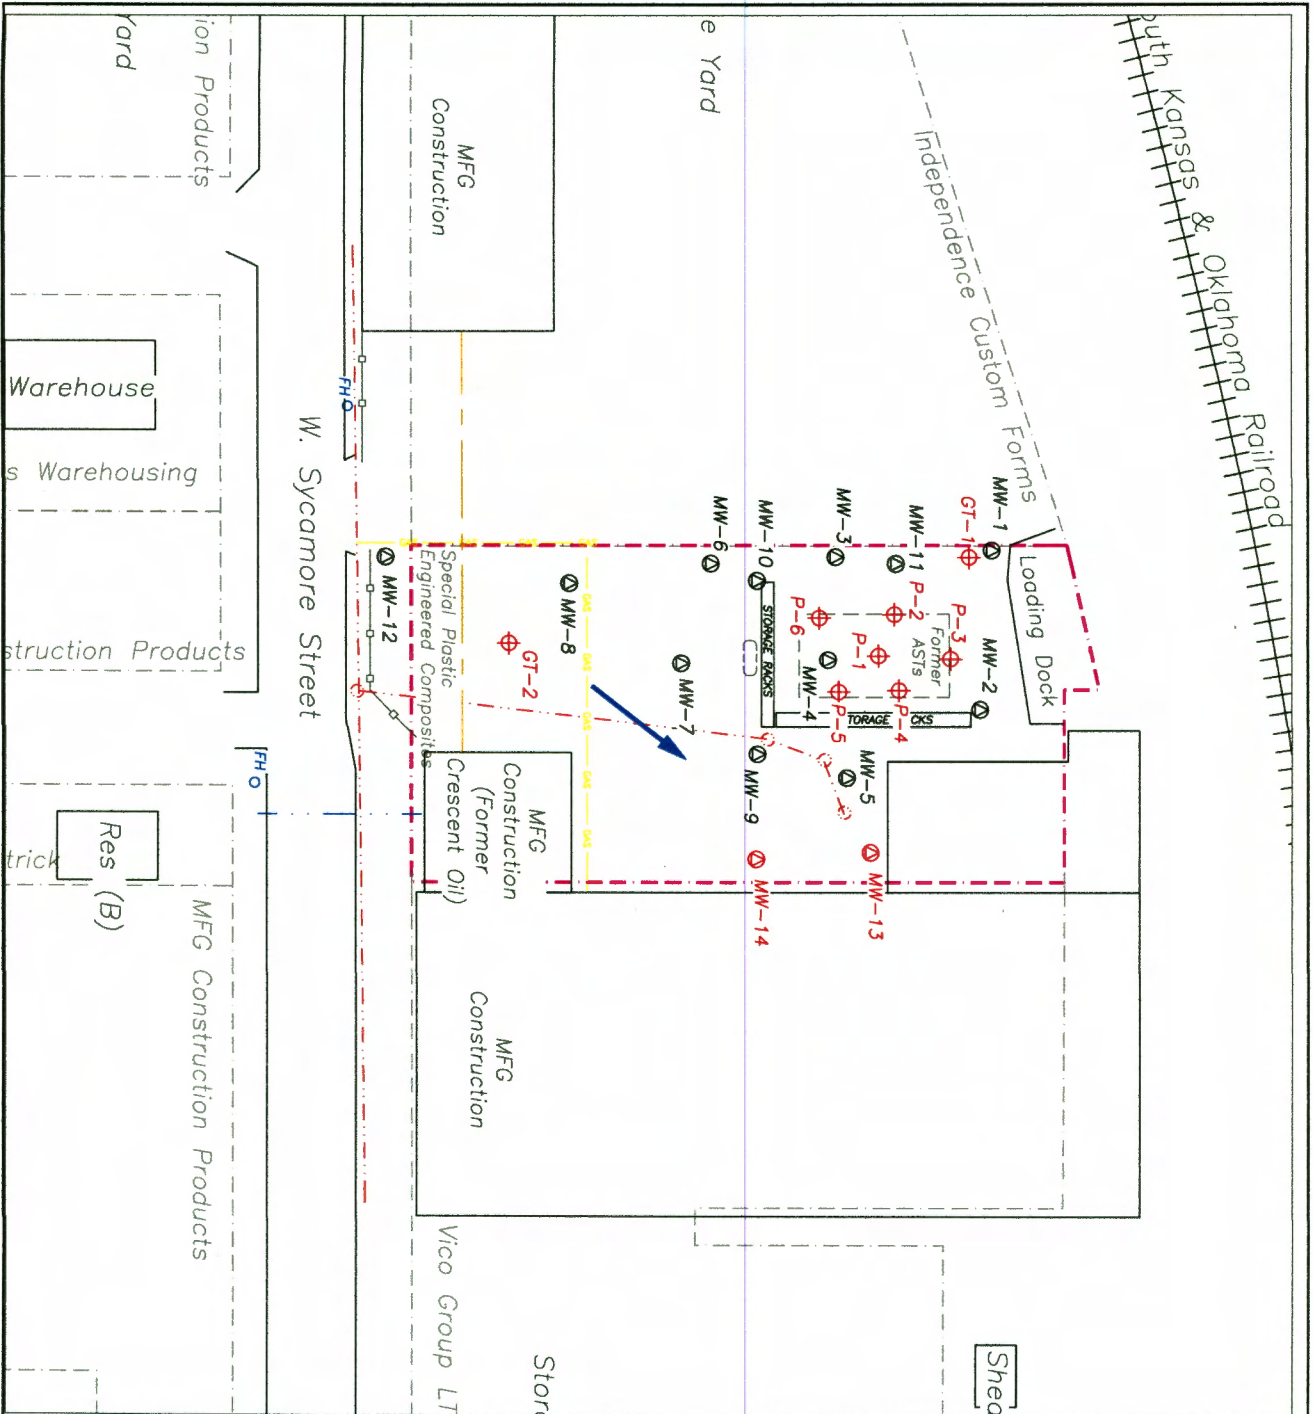

- LEGEND:**
- ◆ PROPOSED SOIL BORING
 - PROPOSED MONITORING WELL
 - EXISTING MONITORING WELL
 - FORMER ASTs AND PUMP ISLAND
 - APPROXIMATE PROJECT SITE BOUNDARY
 - PROPERTY LINE/OWNERS
 - FENCE LINE
 - OVERHEAD ELECTRIC LINE
 - GAS LINE (APPROX. 1.5-3')
 - TELEPHONE LINE (APPROX. 1.5 TO 3')
 - WATER LINE (APPROX. 2-4')
 - GROUNDWATER FLOW DIRECTION
 - Res (B) RESIDENCE WITH BASEMENT
- NOTES:**
- UTILITY LOCATIONS/DEPT'S, FORMER USES/PRODUCT LINES, AND MONITORING WELL LOCATIONS/DEPT'S WERE PROVIDED BY OWNER. FIELD VERIFICATION AND PHOTO WERE PROVIDED BY OWNER.

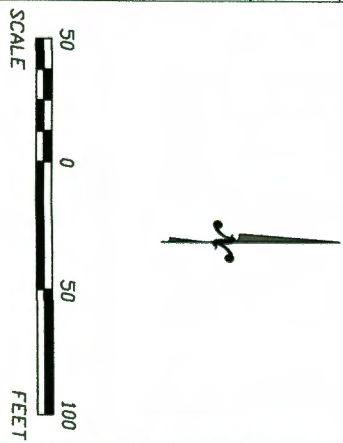


FIGURE 1 - SITE MAP

CRESCENT OIL CO., INC. (A3-063-40215) 1020 W. SYCAMORE STREET INDEPENDENCE, KANSAS		SCS ENGINEERS 8575 West 110th Street, Suite 100 Overland Park, Kansas 66210	
DRAWING NO. 1 PROJECT NUMBER 87221130.00	SHEET NO. 1 DATE 3/24/2021	REV. 01 DATE BY DESCRIPTION	R5 58Y R4 48Y R3 38Y R2 28Y R1 18Y R0 08Y