

WATER WELL RECORD

Form WWC-5

Division of Water Resources App. No.

Well ID

MW3R

Original Record Correction Change in Well Ust

1 LOCATION OF WATER WELL: County Montgomery Fraction SE 1/4 NE 1/4 SE 1/4 SE 1/4 Section Number 8 Township Number T 32 S Range Number R 17 E W

2 WELL OWNER: Last Name: Panesar First: Gurpreet Street or Rural Address where well is located (if unknown, distance and direction from nearest town or intersection): 110 N. Liberty St.

3 LOCATE WELL WITH "X" IN SECTION BOX: [Diagram] 4 DEPTH OF COMPLETED WELL: 10 ft 5 Latitude: 37.26934 Longitude: 95.55602

7 WELL WATER TO BE USED AS: 1 Domestic 2 Irrigation 3 Feedlot 4 Industrial 5 Public Water Supply 6 Dewatering 7 Aquifer Recharge 8 Monitoring

Was a chemical/bacteriological sample submitted to KDHE? Yes No Water well disinfected? Yes No

8 TYPE OF CASING USED: Steel PVC Other CASING JOINTS: Glued Clamped Welded Threaded Casing diameter 2 in. to 3 ft. Diameter in. to ft. Casing height above land surface -0.48 in. Weight lbs./ft. Well thickness or gauge No

9 GROUT MATERIAL: Neat cement Cement grout Bentonite Other Concrete: 0-0.7' Grout intervals: From 0.7 ft. to 2 ft. From ft. to ft. From ft. to ft.

Nearest source of possible contamination: Septic Tank Lateral Lines Pit Privy Livestock Pens Insecticide Storage Sewer Lines Cess Pool Sewage Lagoon Fuel Storage Abandoned Water Well

10 FROM TO LITHOLOGIC LOG FROM TO LITHO. LOG (cont.) or PLUGGING INTERVALS

Notes: KDHE ID: JP Food & Fuel ; U3-063-14354 Target of monitoring well is shallow groundwater, <20' of grout was installed at the direction of KDHE.

11 CONTRACTOR'S OR LANDOWNER'S CERTIFICATION: This water well was constructed, reconstructed, or plugged under my jurisdiction and was completed on (mo-day-year) 3/28/19 and this record is true to the best of my knowledge and belief.

# DENNIS L HANDKE

1820 NW 59th Terrace  
TOPEKA, KANSAS 66618  
785-286-4047 Home

Jess Chapman  
Larsen & Associates  
1311 E. 25<sup>th</sup> Street, Suite B  
Lawrence, Kansas, 66046

April 12, 2019  
Revised 5-14-2019

RE: Monitor Well Elevation Survey  
100 N. Liberty, Cherryvale, Kansas

Proj. 19-00N  
JP Food & Fuel  
U3-063-14354

Bench Mark: Square cut on SE corner of concrete sign at SE Corner of building.  
Elev: 823.09      North 664.86      West 82.89      (from SE Cor. Sec. 8-32-17E)


MW-2R	rim	822.46	North	651.63	NE1/4,SE1/4,SE1/4,SE1/4
	top pipe	822.03	West	116.74	Lat= 37.26906 Long = 95.55620
MW-3R	rim	823.15	North	744.74	SE1/4,NE1/4,SE1/4,SE1/4
	top pipe	822.67	West	53.12	Lat= 37.26934 Long = 95.55602

Lat & Long derived from Cherryvale 7.5' quad map. WGS84

Elevation established from existing project. NAVD 88.

If you have any questions, please feel free to call me. Thank you for the opportunity to be of service to you.

Mark 14, 2019  
Dennis L Handke RL

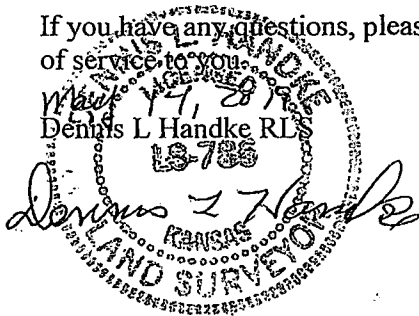

NOTE: Figures exhibited within this report are only to be used within the context of this report. Placement of property lines, wells, structures, and roads is based on the available information from county appraiser maps, surveys, site visits, and/or previous vendor reports and should be considered approximate.

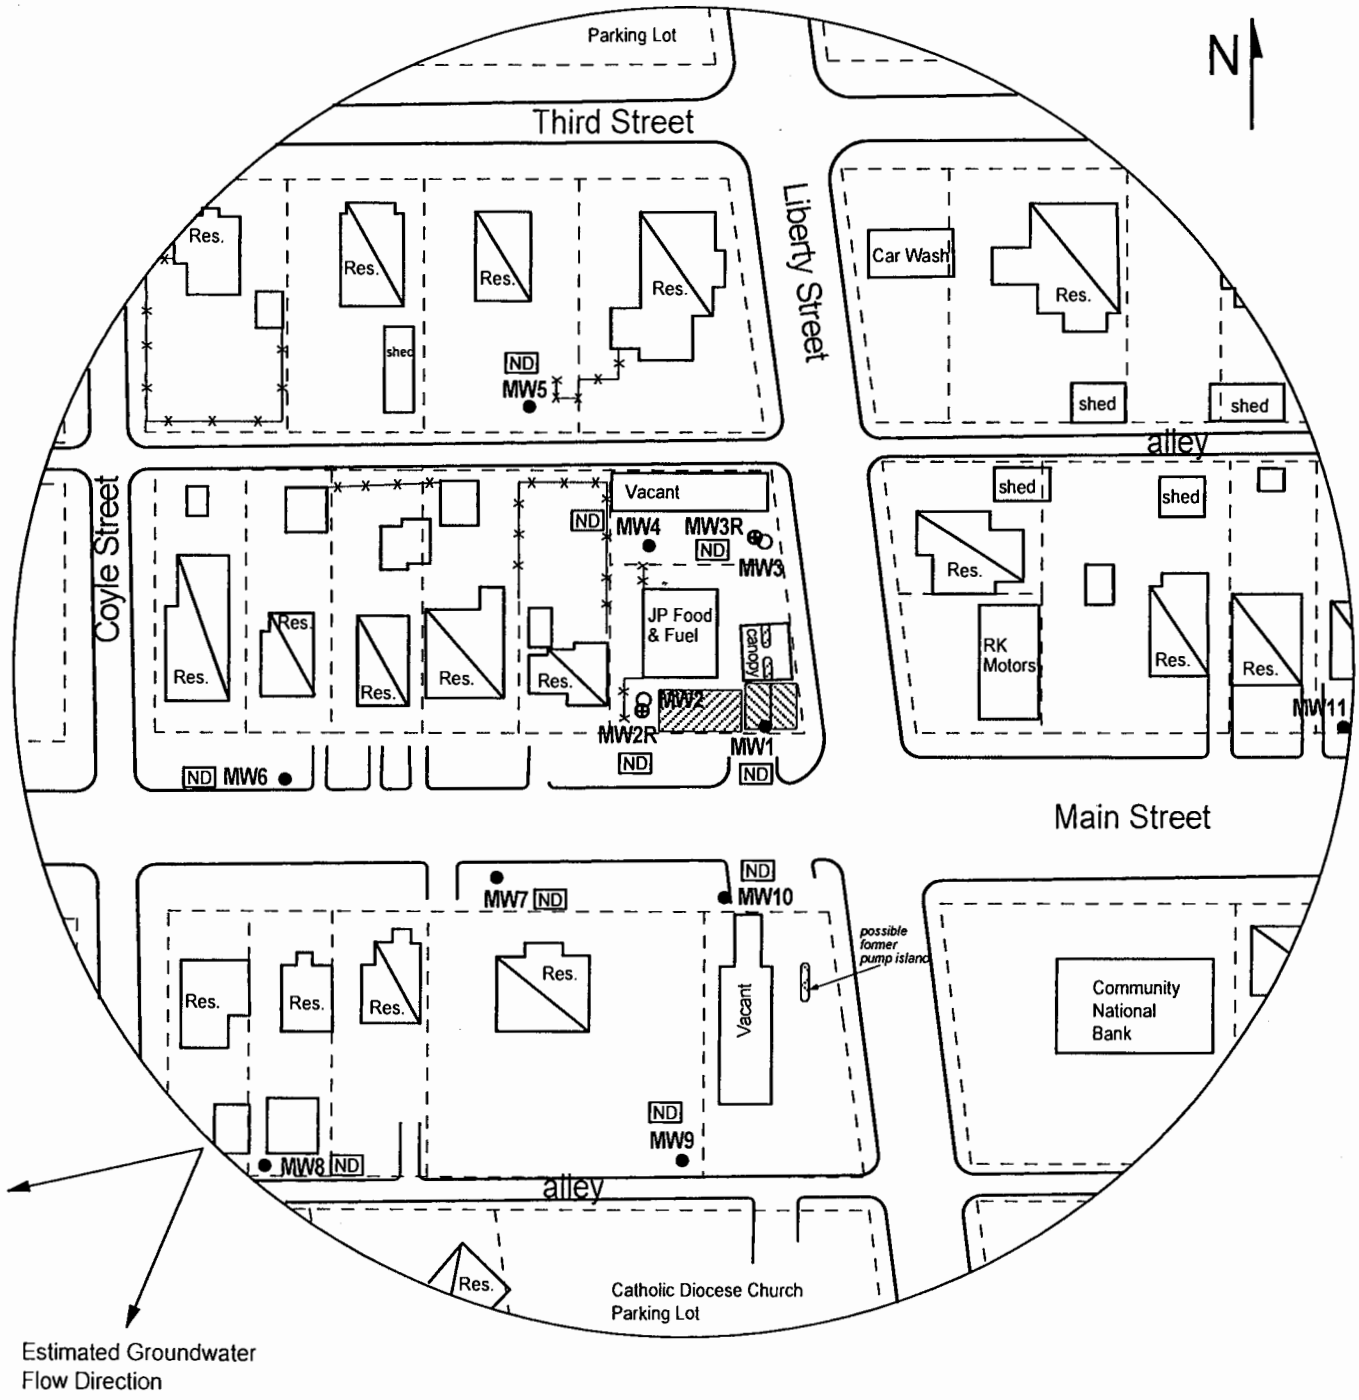



FIGURE 5.3 - GROUNDWATER ISOCONCENTRATION MAP:  
1,2 DICHLOROETHANE IN WELLS

- LEGEND:**
- Approximate Location of Active UST Basin and Pump Islands
  - Approximate Location of Former UST Basin
  - Building with Basement
  - Approximate Location of Property Lines
  - Monitoring Well
  - Monitoring Well (Installed 3/28/19)
  - Plugged Monitoring Well
  - 1,2 Dichloroethane Concentration (ppb)
  - Not Detected at Laboratory Detection Limits

NOTE: MW11 is not within KDHE scope of work.  
NOTE: Location of the product lines is unknown.



**PROJECT:**  
J P Food & Fuel  
100 N. Liberty  
Cherryvale, KS  
KDHE ID: U3-063-14354  
Date: 3/29/19

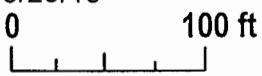

1311 E 25th St., Suite B (785) 841-8707 office  
Lawrence, KS 66046 (785) 865-4282 fax