

KOLAR Document ID: 1386103

	WELL R			WWC-5			ision of Wat					
		Correction		e in Well Use			ources App.			Well ID		
1 LOCATION OF WATER WELL: Fraction							tion Numb	er	Township Numb		ige Number	
County: 1/4 1/4 1/4							$\begin{array}{c c c c c c c c c c c c c c c c c c c $					
							treet or Rural Address where well is located (if unknown, distance and irection from nearest town or intersection): If at owner's address, check here:					
Address:							rection nonin nearest town of intersection). If at owner's address, check here.					
Address:												
City:		1	State:	ZIP:			-					
3 LOCAT		4 DEPTH	OF CON	IPLETED WELI	ft	5 Latif	nde			(decimal degrees)		
WITH "X" IN SECTION BOX:												
	SECTION BOX. 2) ft. 3) ft., or 4) \Box I						ry Well Datum: WGS 84 NAD 83 NAD 27					
	WELL'S STATIC WATER LEVEL:							Source for Latitude/Longitude:				
	below land surface, measured on (mo-day-yr above land surface, measured on (mo-day-yr								unit make/model:			
NW	Pump test data: Well water was ft.							(WAAS enabled? ☐ Yes ☐ No) ☐ Land Survey ☐ Topographic Map				
w	after							Online Mapper:				
	Wall water was											
^{SW}	SWSE after						6 Flow	ation	. £			
Estimated Tield.							6 Elevation:ft. □ Ground Level □ TOC Source: □ Land Survey □ GPS □ Topographic Map					
S Bore Hole Diameter:i												
1 mile												
7 WELL WATER TO BE USED AS: 1. Domestic: 5. Public Water Supply: well ID 10. Oil Field Water Supply: lease 												
□ Household												
Lawn	Lawn & Garden 7. Aquifer Recharge: well ID											
	Livestock 8. Monitoring: well ID								nal: how many bores			
2. 🗌 Irrigation 9. Environmental Remediation: well ID .									Loop Horizont			
3. Feedlot Soil Vapor Ext							b) Open Loop \Box Surface Discharge \Box Inj. of Water					
4. Industrial Recovery Injection 13. Other (specify):												
Was a chemical/bacteriological sample submitted to KDHE? Yes No If yes, date sample was submitted:												
8 TYPE OF CASING USED: Steel PVC Other CASING JOINTS: Glued Clamped Welded Threaded												
Casing diameter in. to ft., Diameter in. to ft., Diameter in. to ft. Casing height above land surface in. Weight lbs./ft. Wall thickness or gauge No												
TYPE OF SCREEN OR PERFORATION MATERIAL:												
$\Box \text{ Steel} \qquad \Box \text{ Stainless Steel} \qquad \Box \text{ Fiberglass} \qquad \Box \text{ PVC} \qquad \Box \text{ Other (Specify)} \dots \dots$												
Brass Galvanized Steel Concrete tile None used (open hole)												
SCREEN OR PERFORATION OPENINGS ARE:												
Continuous Slot Mill Slot Gauze Wrapped Torch Cut Drilled Holes Other (Specify)												
□ Louvered Shutter □ Key Punched □ Wire Wrapped □ Saw Cut □ None (Open Hole) SCREEN-PERFORATED INTERVALS: From												
GRAVEL PACK INTERVALS: From ft. to ft., From ft., From ft., From ft. to ft. o ft. o ft. o ft. to ft. ft. to ft. ft. to ft. ft. to ft. ft. ft. ft. ft. ft. ft. ft. ft.												
									ft. to			
	rce of possible			,			,					
□ Septic			Lateral Line				Livestock P			ide Storage		
Sewer			Cess Pool				Fuel Storage			oned Water		
	ight Sewer Lin		Seepage Pit				Fertilizer St	orage	e ∐Oil We	ll/Gas Well		
☐ Other (Specify) Direction from well? ft.												
10 FROM	TO		ITHOLOG		1	FROM	ТО		THO. LOG (cont.) or		GINTERVALS	
		1							(ionit) of			
						Notes:						
	11 CONTRACTOR'S OR LANDOWNER'S CERTIFICATION: This water well was constructed, reconstructed, or plugged under my jurisdiction and was completed on (mo-day-year) and this record is true to the best of my knowledge and belief.											
Kansas Water Well Contractor's License No												
under the business name of												
Send one copy to WATER WELL OWNER and retain one for your records. Fee of \$5.00 for each <u>constructed</u> well.												
KS Department of Health and Environment, Bureau of Water, Geology Section, 1000 SW Jackson St., Suite 420, Topeka, Kansas 66612-1367. Telephone 785-296-3565. Visit us at http://www.kdheks.gov/waterwell/index.html KSA 82a-1212												

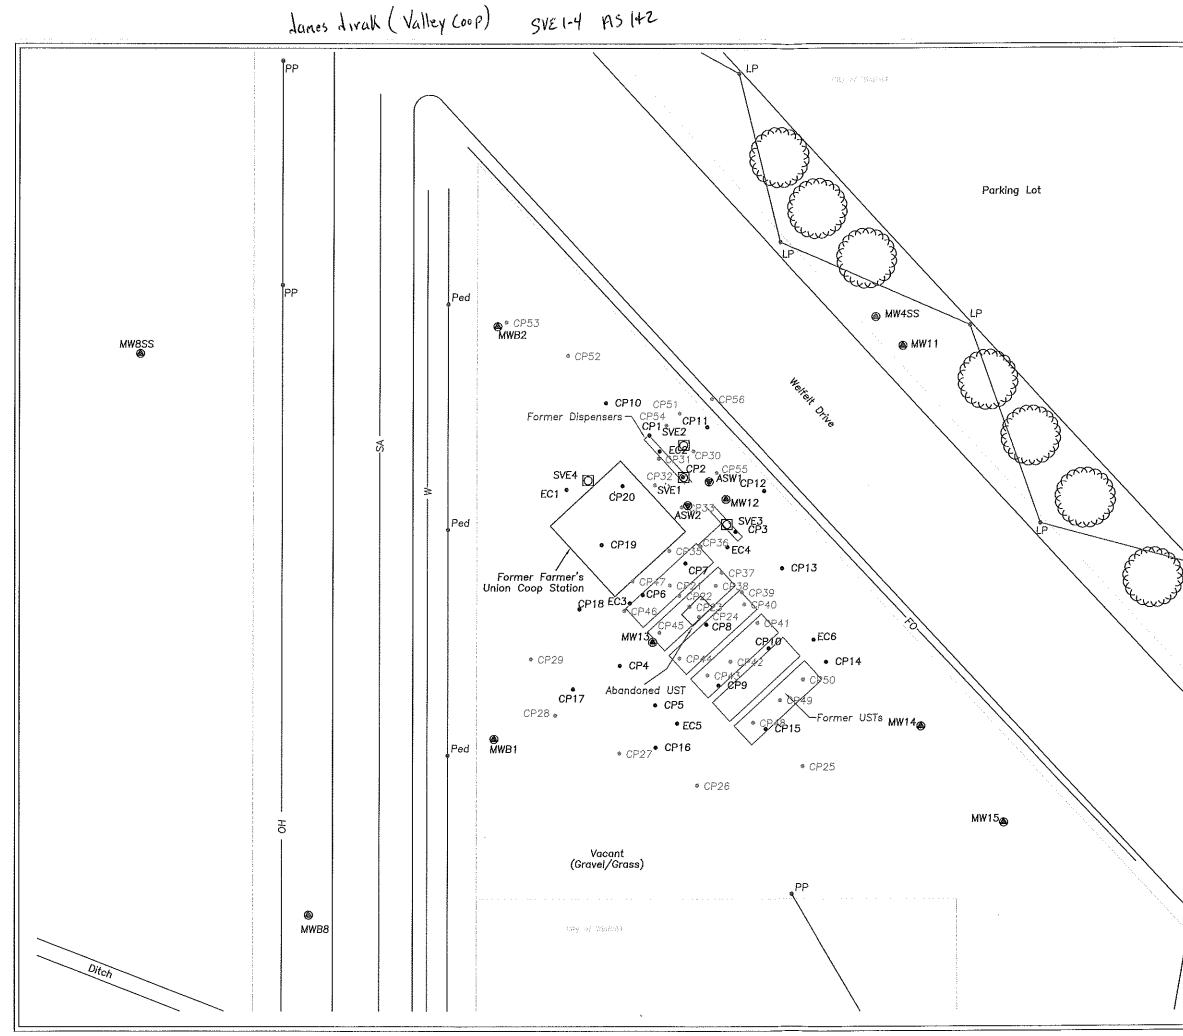

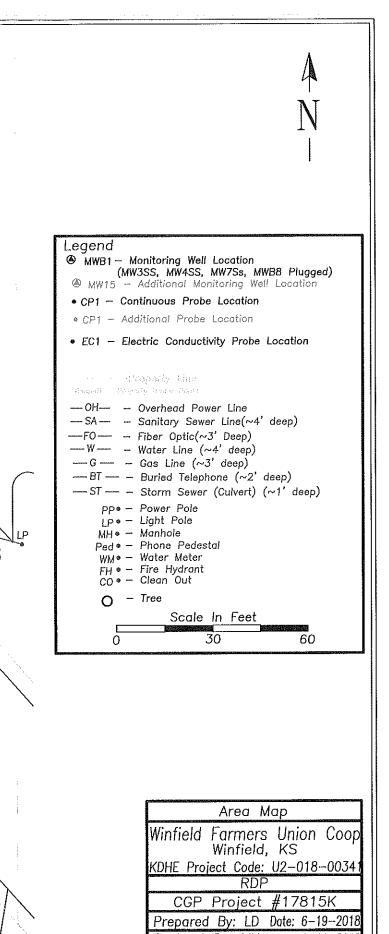

Conc.

Reviewd By: MK Date: 6–19–2018 Drawing 1.7.1a CGP, Inc. PO Box 23, Wahoo, NE 68066