

WATER WELL RECORD Form WWC-5

Original Record Correction Change in Well Use

Division of Water Resources App. No.

Blank box for Division of Water Resources App. No.

Well ID

MW18

1 LOCATION OF WATER WELL: County: Cowley Fraction NW 1/4 NW 1/4 SE 1/4 NW 1/4 Section Number 28 Township Number T 32 S Range Number R 4 E W

2 WELL OWNER: Last Name: First: Business: Caseys #1822 Address: 219 W. 9th St. City: Winfield State: KS ZIP: 67156 Street or Rural Address where well is located: 300 W. 9th St. Winfield, KS 67156

3 LOCATE WELL WITH "X" IN SECTION BOX: N W E S 1 mile

4 DEPTH OF COMPLETED WELL: 20 ft. Depth(s) Groundwater Encountered: 1) 14 ft. 2) 14.25 ft. 3) Dry Well Well's STATIC WATER LEVEL: 14.25 ft. below land surface, measured on (mo-day-yr) 8/25/20

5 Latitude: 37.24034 Longitude: 96.00016 Horizontal Datum: WGS 84 NAD 83 NAD 27 Source for Latitude/Longitude: GPS (unit make/model): Land Survey Topographic Map Online Mapper

6 Elevation: 1125.50 ft. Ground Level TOC Source: Land Survey GPS Topographic Map Other

7 WELL WATER TO BE USED AS: 1. Domestic: Household, Lawn & Garden, Livestock, Irrigation, Feedlot, Industrial. 5. Public Water Supply: well ID. 6. Dewatering: how many wells? 7. Aquifer Recharge: well ID. 8. Monitoring: well ID MW18. 9. Environmental Remediation: well ID. 10. Oil Field Water Supply: lease. 11. Test Hole: well ID. 12. Geothermal: how many bores? 13. Other (specify):

Was a chemical/bacteriological sample submitted to KDHE? Yes No If yes, date sample was submitted: Water well disinfected? Yes No

8 TYPE OF CASING USED: Steel PVC Other CASING JOINTS: Glued Clamped Welded Threaded Casing diameter 2 in. to 20 ft. Diameter in. to ft. Casing height above land surface lbs./ft. Wall thickness or gauge No. Schedule 40

TYPE OF SCREEN OR PERFORATION MATERIAL: Steel Stainless Steel Fiberglass PVC Brass Galvanized Steel Concrete tile None used (open hole) Other (Specify)

SCREEN OR PERFORATION OPENINGS ARE: Continuous Slot Mill Slot Gauze Wrapped Torch Cut Drilled Holes Other (Specify) Louvered Shutter Key Punched Wire Wrapped Saw Cut None (Open Hole)


SCREEN-PERFORATED INTERVALS: From 10 ft. to 20 ft. GRAVEL PACK INTERVALS: From 8 ft. to 20 ft.

9 GROUT MATERIAL: Neat cement Cement grout Bentonite Other Grout Intervals: From 1 ft. to 6 ft. From 6 ft. to 8 ft.

Nearest source of possible contamination: Septic Tank Lateral Lines Pit Privy Livestock Pens Insecticide Storage Sewer Lines Cess Pool Sewage Lagoon Fuel Storage Abandoned Water Well Watertight Sewer Lines Seepage Pit Feedyard Fertilizer Storage Oil Well/Gas Well Other (Specify) Direction from well? Distance from well? ft.

Table with columns: 10 FROM, TO, LITHOLOGIC LOG, FROM, TO, LITHO. LOG (cont.) or PLUGGING INTERVALS. Row 1: 0 to 1, Topsoil, grey. Row 2: 1 to 20, Silty Clay (CL). Notes section.

11 CONTRACTOR'S OR LANDOWNER'S CERTIFICATION: This water well was constructed, reconstructed, or plugged under my jurisdiction and was completed on (mo-day-year) 8/24/20 and this record is true to the best of my knowledge and belief. Kansas Water Well Contractor's License No. 585 This Water Well Record was completed on (mo-day-year) 9/20/20 under the business name of Associated Environmental, Inc. Signature

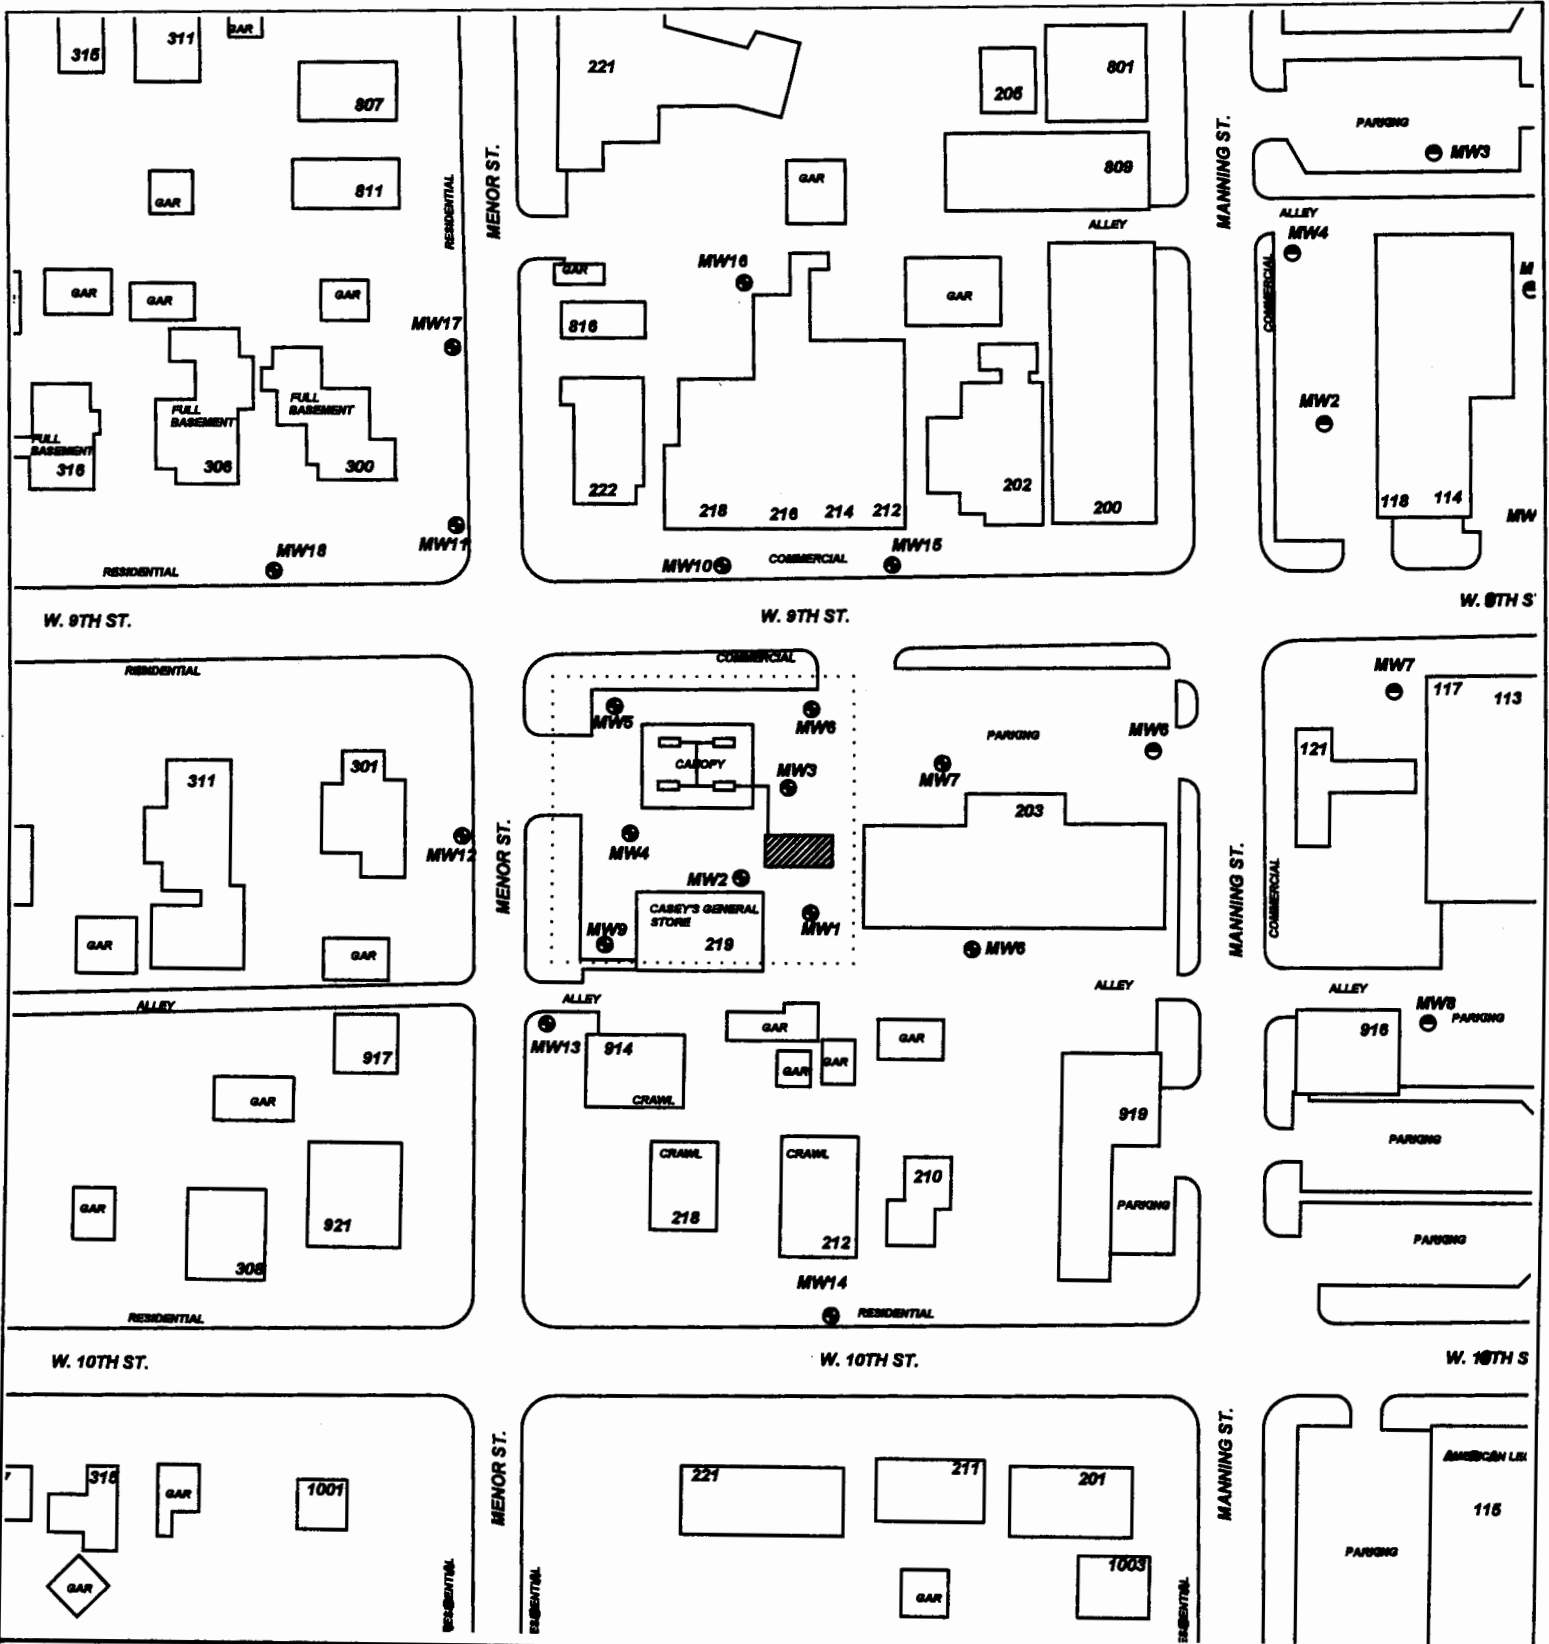

PROJECT: CASEY'S #1822

ADDRESS: 219 W. 9TH

LOCATION: WINFIELD, KS

DRAWN BY: B. STALNAKER **DATE:** 5/3/18

REVISED BY: B. STALNAKER **DATE:** 9/25/20


AE JOB # TF514 **KDHE JOB #** U2-018-15063

TITLE:

ASSOCIATED ENVIRONMENTAL INC.

LEGEND:

- = CURRENT BASINS AND PRODUCT LINES
- = MONITORING WELL
- = MONITORING WELL (REEVES & SONS)
- = PROPOSED MONITORING WELL
- = SUBJECT PROPERTY

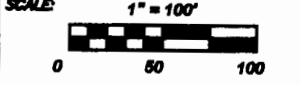

NOTES: