

WATER WELL RECORD Form WWC-5

Division of Water Resources App. No.


Well ID MW5

Original Record Correction Change in Well Use

1 LOCATION OF WATER WELL: County: LABETTE	Fraction SW ¼ SW ¼ SE ¼ SW ¼	Section Number 2	Township Number T 33 S	Range Number R 19 <input checked="" type="checkbox"/> E <input type="checkbox"/> W
---	---------------------------------	---------------------	---------------------------	---

2 WELL OWNER: Last Name: HARAUGHTY First: VICKY Business Address: 115 E. 4TH ST. Address: ALTAMONT State: KS ZIP: 67330	Street or Rural Address where well is located (if unknown, distance and direction from nearest town or intersection): If at owner's address, check here: <input checked="" type="checkbox"/>
--	--

3 LOCATE WELL WITH "X" IN SECTION BOX:

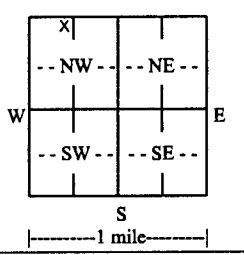

4 DEPTH OF COMPLETED WELL: 15 ft.
 Depth(s) Groundwater Encountered: 1) 8 ft.
 2) _____ ft. 3) _____ ft. or 4) Dry Well
WELL'S STATIC WATER LEVEL: 2.77 ft.
 below land surface, measured on (mo-day-yr) 11/15/17.
 above land surface, measured on (mo-day-yr) _____
 Pump test data: Well water was _____ ft. after _____ hours pumping _____ gpm
 Well water was _____ ft. after _____ hours pumping _____ gpm
 Estimated Yield: _____ gpm
 Bore Hole Diameter: _____ in. to _____ ft. and _____ in. to _____ ft.

5 Latitude: 37.19292 (decimal degrees)
Longitude: 95.29970 (decimal degrees)
 Horizontal Datum: WGS 84 NAD 83 NAD 27
Source for Latitude/Longitude:
 GPS (unit make/model: _____) (WAAS enabled? Yes No)
 Land Survey Topographic Map
 Online Mapper: _____

6 Elevation: 903.76 ft. Ground Level TOC
 Source: Land Survey GPS Topographic Map
 Other _____

7 WELL WATER TO BE USED AS:

1. Domestic: <input type="checkbox"/> Household <input type="checkbox"/> Lawn & Garden <input type="checkbox"/> Livestock 2. <input type="checkbox"/> Irrigation 3. <input type="checkbox"/> Feedlot 4. <input type="checkbox"/> Industrial	5. <input type="checkbox"/> Public Water Supply: well ID _____ 6. <input type="checkbox"/> Dewatering: how many wells? _____ 7. <input type="checkbox"/> Aquifer Recharge: well ID _____ 8. <input type="checkbox"/> Monitoring: well ID MW5 9. Environmental Remediation: well ID _____ <input type="checkbox"/> Air Sparge <input type="checkbox"/> Soil Vapor Extraction <input type="checkbox"/> Recovery <input type="checkbox"/> Injection	10. <input type="checkbox"/> Oil Field Water Supply: lease _____ 11. Test Hole: well ID _____ <input type="checkbox"/> Cased <input type="checkbox"/> Uncased <input type="checkbox"/> Geotechnical 12. Geothermal: how many bores? _____ a) Closed Loop <input type="checkbox"/> Horizontal <input type="checkbox"/> Vertical b) Open Loop <input type="checkbox"/> Surface Discharge <input type="checkbox"/> Inj. of Water 13. <input type="checkbox"/> Other (specify): _____
---	--	---

Was a chemical/bacteriological sample submitted to KDHE? Yes No If yes, date sample was submitted: _____
 Water well disinfected? Yes No


8 TYPE OF CASING USED: Steel PVC Other _____ CASING JOINTS: Glued Clamped Welded Threaded
 Casing diameter 2 in. to 15 ft., Diameter _____ in. to _____ ft., Diameter _____ in. to _____ ft.
 Casing height above land surface _____ in. Weight _____ lbs./ft. Wall thickness or gauge No. _____
TYPE OF SCREEN OR PERFORATION MATERIAL:
 Steel Stainless Steel Fiberglass PVC Other (Specify) _____
 Brass Galvanized Steel Concrete tile None used (open hole)
SCREEN OR PERFORATION OPENINGS ARE:
 Continuous Slot Mill Slot Gauze Wrapped Torch Cut Drilled Holes Other (Specify) _____
 Louvered Shutter Key Punched Wire Wrapped Saw Cut None (Open Hole)
SCREEN-PERFORATED INTERVALS: From 5 ft. to 15 ft., From _____ ft. to _____ ft., From _____ ft. to _____ ft.
GRAVEL PACK INTERVALS: From 4 ft. to 15 ft., From _____ ft. to _____ ft., From _____ ft. to _____ ft.

9 GROUT MATERIAL: Neat cement Cement grout Bentonite Other CONCRETE
 Grout Intervals: From 0 ft. to 1 ft., From 1 ft. to 3 ft., From _____ ft. to _____ ft.
Nearest source of possible contamination:
 Septic Tank Lateral Lines Pit Privy Livestock Pens Insecticide Storage
 Sewer Lines Cess Pool Sewage Lagoon Fuel Storage Abandoned Water Well
 Watertight Sewer Lines Seepage Pit Feedyard Fertilizer Storage Oil Well/Gas Well
 Other (Specify) _____
 Direction from well? _____ Distance from well? _____ ft.


10 FROM	TO	LITHOLOGIC LOG	FROM	TO	LITHO. LOG (cont.) or PLUGGING INTERVALS
0	1	TOPSOIL			
1	8	SILTY CLAY			
8	15	MUDSTONE			

Notes:

11 CONTRACTOR'S OR LANDOWNER'S CERTIFICATION: This water well was constructed, reconstructed, or plugged under my jurisdiction and was completed on (mo-day-year) 11/2/17 and this record is true to the best of my knowledge and belief. Kansas Water Well Contractor's License No. 585 This Water Well Record was completed on (mo-day-year) 11/2/17 under the business name of ASSOCIATED ENVIRONMENTAL INC. Signature _____

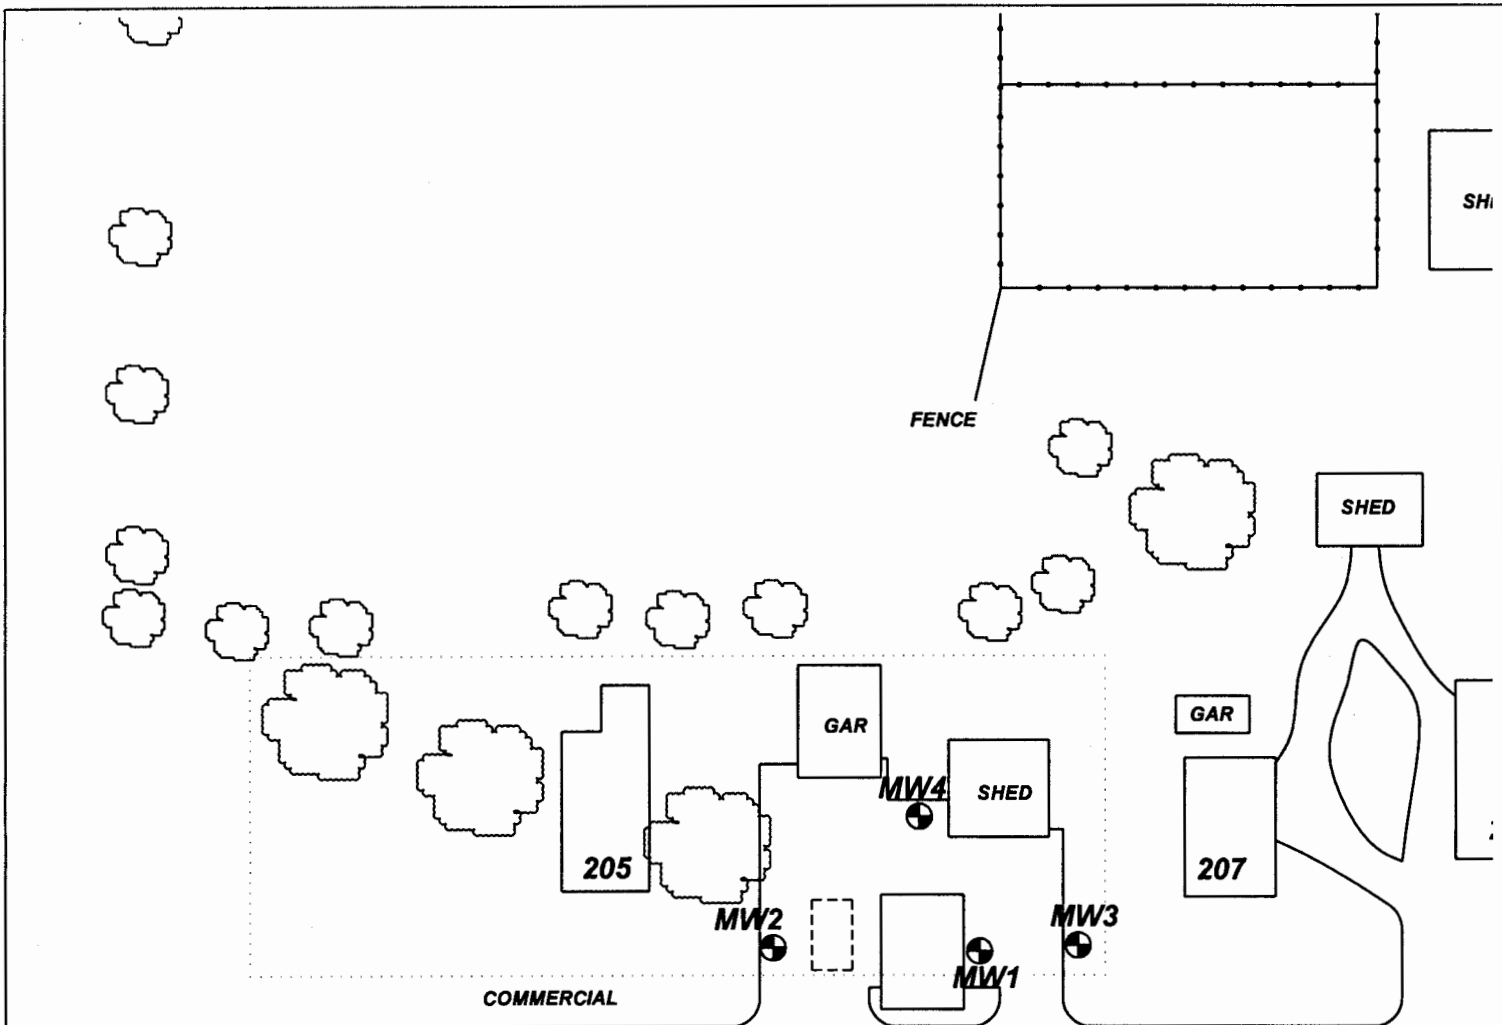

' 160) E 4TH ST (HWY 160)

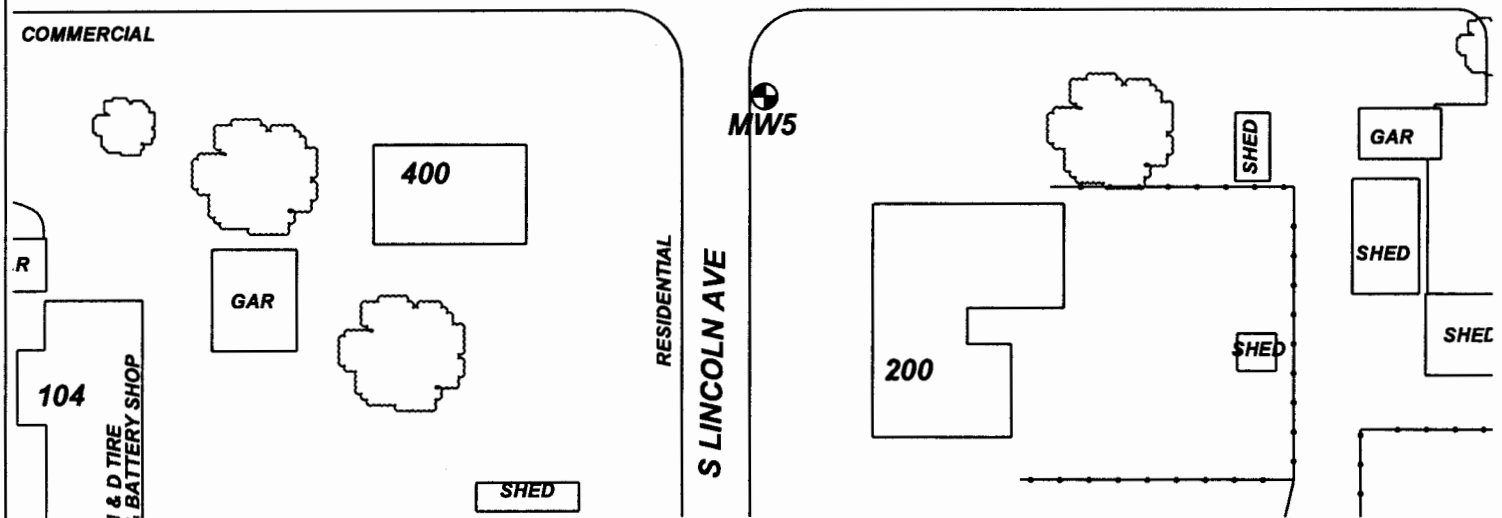

PROJECT: TOMMY BAKER	TITLE:	LEGEND: = FORMER UST BASIN/EXCAVATION = MONITOR WELL = SUBJECT PROPERTY
ADDRESS: 115 E. 4TH STREET		
LOCATION: ALTAMONT, KS		
SCALE: 1" = 50'		
DRAWN BY: B. STALNAKER <small>DATE:</small> 7/12/17	ASSOCIATED ENVIRONMENTAL INC.	
REVISED BY: B. STALNAKER <small>DATE:</small> 12/4/17		
AEI JOB #: TF506 <small>KDHE JOB #:</small> U3-050-14870		
	NOTES: No basements observed within 500'.	