

WATER WELL RECORD

Form WWC-5

Division of Water Resources App. No.

Well ID

MWIR

Original Record Correction Change in Well Ust

1 LOCATION OF WATER WELL: County Montgomery Fraction NW 1/4 SW 1/4 SE 1/4 SW 1/4 Section Number 36 Township Number T 34 S Range Number R 16 E W

2 WELL OWNER: Last Name: Business: KDHE Address: 1000 SW Jackson City Topeka State: KS ZIP: 66612 Street or Rural Address where well is located (if unknown, distance and direction from nearest town or intersection): 619 S Walnut St, Coffeyville, KS

3 LOCATE WELL WITH "X" IN SECTION BOX: N NW NE SW SE S W E

4 DEPTH OF COMPLETED WELL: 25 ft Depth(s) Groundwater Encountered: 1) 2) 3) 4) Dry Well WELL'S STATIC WATER LEVEL: below land surface, measured on (mo-day-yr) Pump test data: Well water was after hours pumping Water well was after hours pumping Estimated Yield: gpm Bore Hole Diameter: 7.25 in to ft, and in to ft

5 Latitude: 37.03735 (decimal degrees) Longitude: 95.61531 (decimal degrees) Horizontal Datum: X WGS 84 NAD 83 NAD 27 Source for Latitude/Longitude: GPS (unit make/model) (WAAS enabled? Yes No) Land Survey Topographic Map Online Mapper

6 Elevation: 733.45 ft Ground Level TOC Source: X Land Survey GPS Topographic Map Other

7 WELL WATER TO BE USED AS: 1 Domestic: Household Lawn & Garden Livestock Irrigation Feedlot Industrial 2 Public Water Supply: well ID 3 Dewatering: how many wells? 4 Aquifer Recharge: well ID 5 Monitoring: well ID MWIR 6 Environmental Remediation: well ID 7 Air Sparge 8 Soil Vapor Extractor 9 Recovery 10 Injection 10 Oil Field Water Supply: lease 11 Test Hole: well ID Cased Uncased Geotechnical 12 Geothermal: How many bores? a) Closed Loop Horizontal Vertical b) Open Loop Surface Discharge Inj. of Water Other (specify):

Was a chemical/bacteriological sample submitted to KDHE? Yes No If yes, date sample was submitted: Water well disinfected? Yes No

8 TYPE OF CASING USED: Steel PVC Other CASING JOINTS: Glued Clamped Welded Threaded Casing diameter 2 in. to 10 ft, Diameter in. to ft, Diameter in. to ft, Casing height above land surface -0.44 in. Weight lbs./ft. Well thickness or gauge No TYPE OF SCREEN OR PERFORATION MATERIAL: Steel Stainless Steel Fiberglass PVC Other (Specify) SCREEN OR PERFORATION OPENINGS ARE: Continuous Slot Mill Slot Gauze Wrapped Torch Cut Drilled Holes Other (Specify) Louvered Shutter Key Punched Wire Wrapped Saw Cut None (Open Hole) SCREEN-PERFORATED INTERVALS: From 10 ft. to 25 ft. From ft. to ft. From ft. to ft. GRAVEL PACK INTERVALS: From 8 ft. to 25 ft. From ft. to ft. From ft. to ft.

9 GROUT MATERIAL: Neat cement Cement grout Bentonite Other Concrete: 0-0.5' Grout intervals: From 0.5 ft. to 8 ft. From ft. to ft. From ft. to ft.

Nearest source of possible contamination: Septic Tank Lateral Lines Pit Privy Livestock Pens Insecticide Storage Sewer Lines Cess Pool Sewage Lagoon Fuel Storage Abandoned Water Well Watertight Sewer Lines Sepage Pit Feedyard Fertilizer Storage Oil Well / Gas Well Other (Specify) Direction from well? W Distance from well? ~5 ft

Table with 6 columns: FROM, TO, LITHOLOGIC LOG, FROM, TO, LITHO. LOG (cont.) or PLUGGING INTERVALS. Rows: 0-0.5 Gravel/topsoil, 0.5-15 Clay, 15-25 Silty clay

Notes: KDHE ID: Commercial Property; U3-063-14707 Target of monitoring well is shallow groundwater, <20' of grout was installed at the direction of KDHE.

11 CONTRACTOR'S OR LANDOWNER'S CERTIFICATION: This water well was constructed, reconstructed, or plugged under my jurisdiction and was completed on (mo-day-year) 1/31/22 and this record is true to the best of my knowledge and belief. Kansas Water Well Contractor's License No 757 This Water Well Record was completed on (mo-day-year) 4/11/22 under the business name of Larsen & Associates, Inc. Signature

Montgomery

36-34-16E

DENNIS L HANDKE

1820 NW 59th Terrace
TOPEKA, KANSAS 66618
785-286-4047 Home
785-286-1990 Fax

Jess Chapman
Larson & Assoc.
1311 E. 25th St., Suite B
Lawrence, Kansas, 66046

March 7, 2022

RE: Monitor Well Elevation Survey
619 S. Walnut St., Coffeyville, Kansas

Proj. 22-00M
Commercial Property
U3-063-014707

Bench Mark: Chisled Square on South edge of concrete sign base near the SW corner of property.

Elev: 733.20 North 406.56 West 3955.56 (from SE Cor. Sec. 36-34-16E)

MW-1R rim 733.89 North 456.81 NW1/4,SW1/4,SE1/4SW1/4
 top pipe 733.45 West 3882.45 Lat= 37.03735 Long = 95.61531


MW-4R rim 734.20 North 541.08 NW1/4,SW1/4,SE1/4,SW1/4
 top pipe 733.62 West 3938.77 Lat= 37.03758 Long = 95.61550

MW-5R rim 734.31 North 493.51 NW1/4,SW1/4,SE1/4,SW1/4
 top pipe 733.88 West 3857.46 Lat= 37.03745 Long = 95.61522

Lat & Long derived from Coffeyville East 7.5' quad map. WGS 84.

Elevation established from NGS Bench Mark: B 17, NAVD 88.

If you have any questions, please feel free to call me. Thank you for the opportunity to be

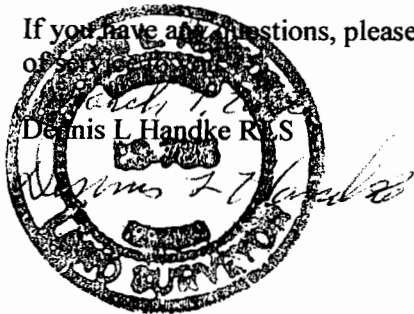


RECEIVED

JUN 28 2022

BUREAU OF WATER

NOTE: Figures exhibited within this report are only to be used within the context of this report. Placement of property lines, wells, structures, and roads is based on the available information from county appraiser maps, surveys, site visits, and/or previous vendor reports and should be considered approximate.

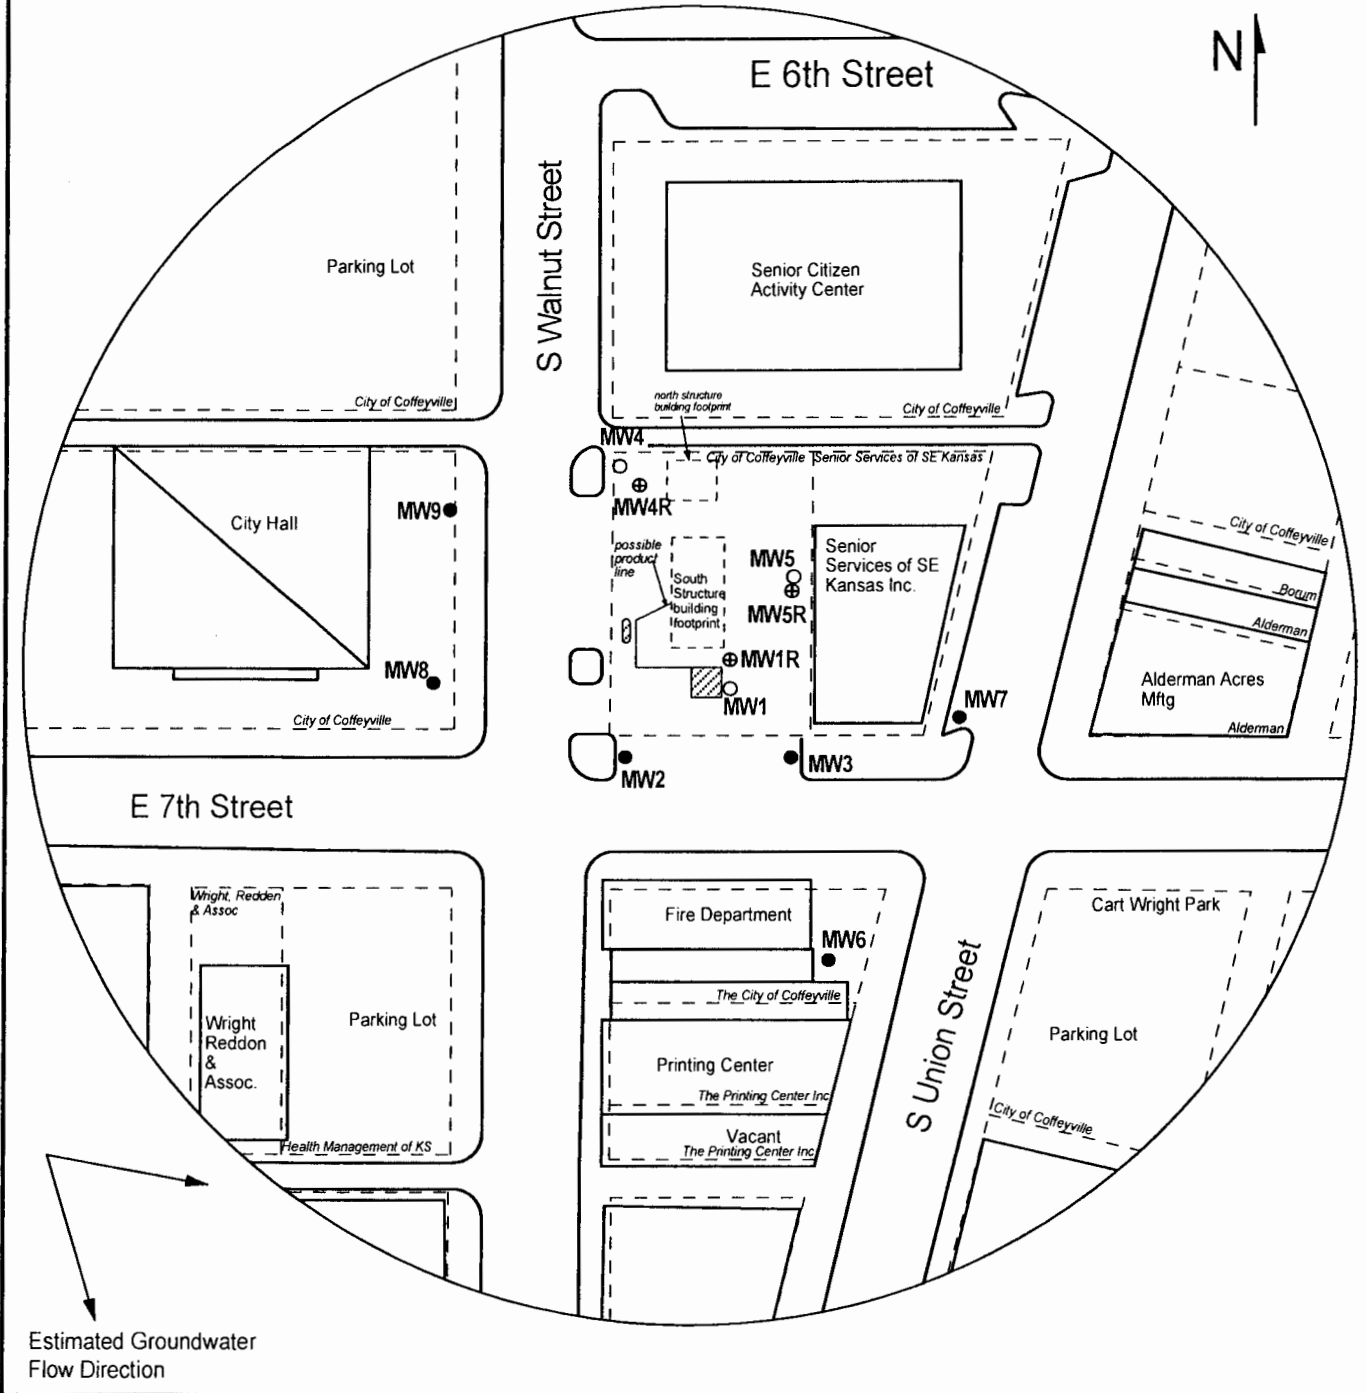

Estimated Groundwater Flow Direction

FIGURE 1 - DETAILED SITE BASE MAP



PROJECT:

Commercial Property
 619 S. Walnut Street
 Coffeyville, KS
 KDHE ID: U3-063-14707
 Date: 1/31/22



LEGEND:

- Approximate Location of Former UST Basin, Possible Product Line & Pump Island
- Building with Basement
- Approximate Location of Property Line
- Monitoring Well
- Plugged Monitoring Well
- New Monitoring Well (Installed 1/31/22)

1311 E 25th St., Suite B (785) 841-8707 office
 Lawrence, KS 66046 (785) 865-4282 fax