

WATER WELL RECORD

Form WWC-5

Division of Water Resources App. No.


Well ID

MW5R

[X] Original Record [] Correction [] Change in Well Use

1 LOCATION OF WATER WELL: County Montgomery Fraction NW 1/4 SW 1/4 SE 1/4 SW 1/4 Section Number 36 Township Number T 34 S Range Number R 16 E

2 WELL OWNER: Last Name: Business: KDHE; Address: 1000 SW Jackson; City: Topeka; State: KS; ZIP: 66612; Street or Rural Address where well is located: 619 S Walnut St, Coffeyville, KS

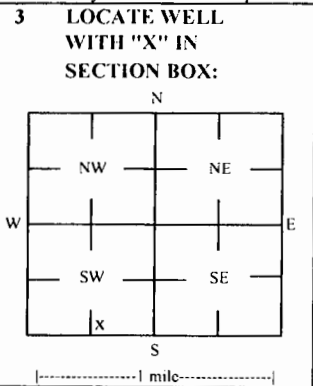

3 LOCATE WELL WITH 'X' IN SECTION BOX; 4 DEPTH OF COMPLETED WELL: 25 ft; WELL'S STATIC WATER LEVEL: below land surface, measured on (mo-day-yr)

5 Latitude: 37.03745; Longitude: 95.61522; Horizontal Datum: WGS 84; 6 Elevation: 733.88 ft; Source: Land Survey

7 WELL WATER TO BE USED AS: 1 Domestic: [] Household, [] Lawn & Garden, [] Livestock, [] Irrigation, [] Feedlot, [] Industrial; 2 Public Water Supply: well ID; 3 Dewatering: how many wells?; 4 Aquifer Recharge: well ID; 5 Monitoring: well ID MW5R; 6 Environmental Remediation: well ID; 7 Air Sparge; 8 Soil Vapor Extractor; 9 Recovery; 10 Injection; 11 Oil Field Water Supply: lease; 12 Test Hole: well ID; 13 Cased; 14 Uncased; 15 Geotechnical; 16 Geothermal: How many bores?; 17 a) Closed Loop; 18 Horizontal; 19 Vertical; 20 b) Open Loop; 21 Surface Discharge; 22 Inj. of Water; 23 Other (specify):

Was a chemical/bacteriological sample submitted to KDHE? [] Yes [X] No; Water well disinfected? [] Yes [X] No

8 TYPE OF CASING USED: [] Steel [X] PVC [] Other; CASING JOINTS: [] Glued [] Clamped [] Welded [X] Threaded; TYPE OF SCREEN OR PERFORMANCE MATERIAL: [] Steel [] Stainless Steel [] Fiberglass [X] PVC [] Brass [] Galvanized Steel [] Concrete tile [] None used (open hole); SCREEN OR PERFORMANCE OPENINGS ARE: [] Continuous Slot [X] Mill Slot [] Gauze Wrapped [] Torch Cut [] Drilled Holes [] Other (Specify); SCREEN-PERFORATED INTERVALS: From 10 ft. to 25 ft.; GRAVEL PACK INTERVALS: From 8 ft. to 25 ft.

9 GROUT MATERIAL: [] Neat cement [] Cement grout [X] Bentonite [X] Other Concrete: 0-0.5'; Grout intervals: From 0.5 ft. to 8 ft.

Nearest source of possible contamination: [] Septic Tank [] Lateral Lines [] Pit Privy [] Livestock Pens [] Insecticide Storage; [] Sewer Lines [] Cess Pool [] Sewage Lagoon [X] Fuel Storage [] Abandoned Water Well; [] Watertight Sewer Lines [] Seepage Pit [] Feedyard [] Fertilizer Storage [] Oil Well / Gas Well; Direction from well? SW Distance from well? ~55 ft

Table with columns: FROM, TO, LITHOLOGIC LOG, FROM, TO, LITHO. LOG (cont.) or PLUGGING INTERVALS. Rows: 0-1 Topsoil, 0.5-13 Clay, 13-25 Silty clay

Notes: KDHE ID: Commercial Property; U3-063-14707; Target of monitoring well is shallow groundwater. <20' of grout was installed at the direction of KDHE.

11 CONTRACTOR'S OR LANDOWNER'S CERTIFICATION: This water well was [X] constructed, [] reconstructed, or [] plugged under my jurisdiction and was completed on (mo-day-year) 1/31/22 and this record is true to the best of my knowledge and belief. Kansas Water Well Contractor's License No 757 This Water Well Record was completed on (mo-day-year) 4/11/22 under the business name of Larsen & Associates, Inc. Signature

Montgomery

36-34-16E

DENNIS L HANDKE

1820 NW 59th Terrace
TOPEKA, KANSAS 66618
785-286-4047 Home
785-286-1990 Fax

Jess Chapman
Larson & Assoc.
1311 E. 25th St., Suite B
Lawrence, Kansas, 66046

March 7, 2022

RE: Monitor Well Elevation Survey
619 S. Walnut St., Coffeyville, Kansas

Proj. 22-00M
Commercial Property
U3-063-014707

Bench Mark: Chisled Square on South edge of concrete sign base near the SW corner of property.


Elev: 733.20 North 406.56 West 3955.56 (from SE Cor. Sec. 36-34-16E)

MW-1R	rim	733.89	North	456.81	NW1/4,SW1/4,SE1/4SW1/4
	top pipe	733.45	West	3882.45	Lat= 37.03735 Long = 95.61531
MW-4R	rim	734.20	North	541.08	NW1/4,SW1/4,SE1/4,SW1/4
	top pipe	733.62	West	3938.77	Lat= 37.03758 Long = 95.61550
MW-5R	rim	734.31	North	493.51	NW1/4,SW1/4,SE1/4,SW1/4
	top pipe	733.88	West	3857.46	Lat= 37.03745 Long = 95.61522

Lat & Long derived from Coffeyville East 7.5' quad map. WGS 84.

Elevation established from NGS Bench Mark: B 17, NAVD 88.

If you have any questions, please feel free to call me. Thank you for the opportunity to be

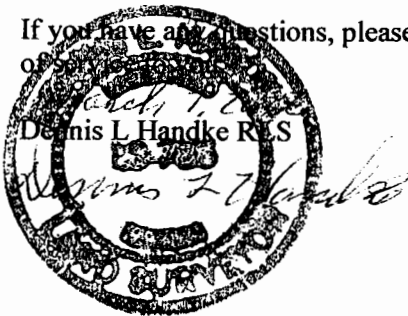

RECEIVED
JUN 28 2022
BUREAU OF WATER

NOTE: Figures exhibited within this report are only to be used within the context of this report. Placement of property lines, wells, structures, and roads is based on the available information from county appraiser maps, surveys, site visits, and/or previous vendor reports and should be considered approximate.

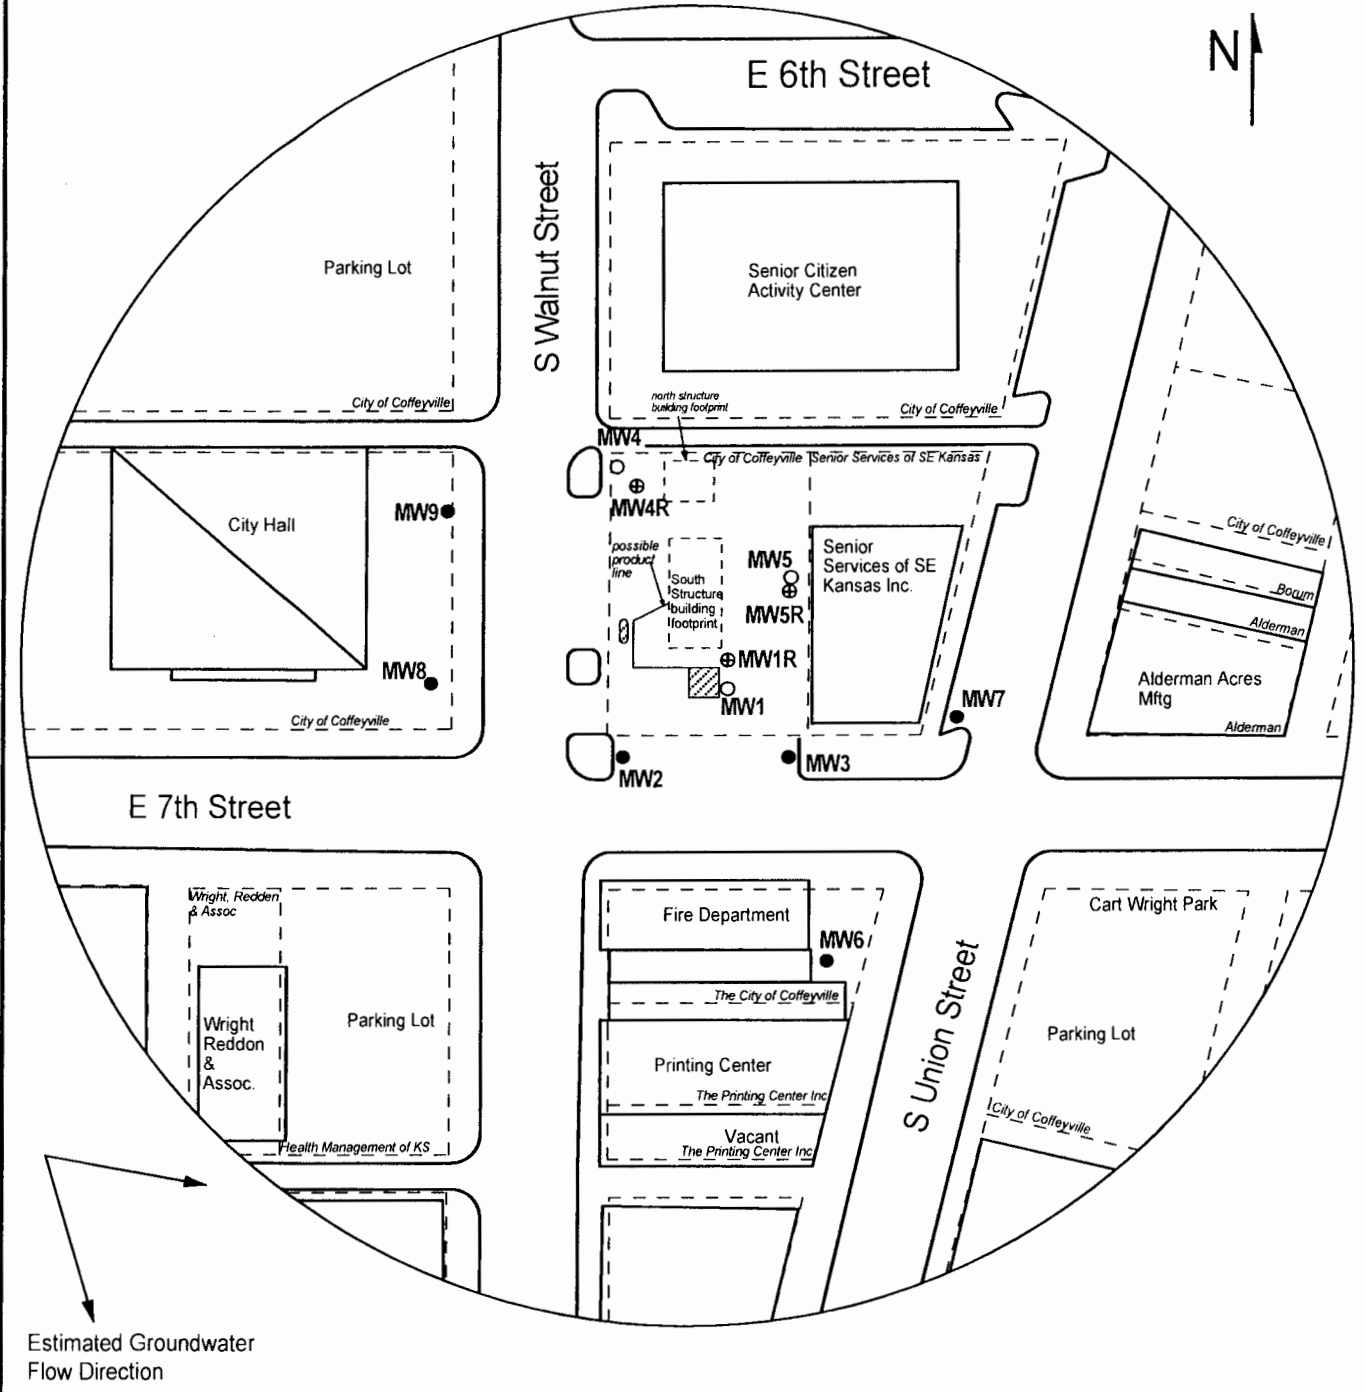


FIGURE 1 - DETAILED SITE BASE MAP



PROJECT:

Commercial Property
619 S. Walnut Street
Coffeyville, KS
KDHE ID: U3-063-14707
Date: 1/31/22



LEGEND:

- Approximate Location of Former UST Basin, Possible Product Line & Pump Island
- Building with Basement
- Approximate Location of Property Line
- Monitoring Well
- Plugged Monitoring Well
- New Monitoring Well (Installed 1/31/22)

1311 E 25th St., Suite B (785) 841-8707 office
Lawrence, KS 66046 (785) 865-4282 fax