

WATER WELL RECORD Form WWC-5

Division of Water Resources App. No.

[Empty Box]

Well ID MW4

Original Record Correction Change in Well Use

1 LOCATION OF WATER WELL: County: COWLEY Fraction NW 1/4 NW 1/4 NW 1/4 NW 1/4 Section Number 18 Township Number T 34 S Range Number R 4 E W

2 WELL OWNER: Last Name: Business: CASEY'S GENERAL STORE #3435 Address: 3413 N. SUMMIT City: ARKANSAS CITY State: KS ZIP: 67005 Street or Rural Address where well is located

3 LOCATE WELL WITH "X" IN SECTION BOX: [Diagram showing a 2x2 grid with NW, NE, SW, SE quadrants and an 'X' in the NW quadrant]

4 DEPTH OF COMPLETED WELL: 12.63 ft. Depth(s) Groundwater Encountered: 1) ... ft. 2) ... ft. 3) ... ft., or 4) Dry Well WELL'S STATIC WATER LEVEL: 8.77 ft. below land surface, measured on (mo-day-yr) 9/6/18

5 Latitude: 37.09970 (decimal degrees) Longitude: 97.04016 (decimal degrees) Horizontal Datum: WGS 84 NAD 83 NAD 27 Source for Latitude/Longitude: GPS (unit make/model) Land Survey Topographic Map Online Mapper

6 Elevation: 1171.44 ft. Ground Level TOC Source: Land Survey GPS Topographic Map Other

7 WELL WATER TO BE USED AS: 1. Domestic: Household Lawn & Garden Livestock Irrigation Feedlot Industrial 5. Public Water Supply: well ID 6. Dewatering: how many wells? 7. Aquifer Recharge: well ID 8. Monitoring: well ID MW4 9. Environmental Remediation: well ID Air Sparge Soil Vapor Extraction Recovery Injection 10. Oil Field Water Supply: lease 11. Test Hole: well ID Cased Uncased Geotechnical 12. Geothermal: how many bores? a) Closed Loop Horizontal Vertical b) Open Loop Surface Discharge Inj. of Water 13. Other (specify):

Was a chemical/bacteriological sample submitted to KDHE? Yes No If yes, date sample was submitted: Water well disinfected? Yes No

8 TYPE OF CASING USED: Steel PVC Other CASING JOINTS: Glued Clamped Welded Threaded Casing diameter 2 in. to 12.63 ft., Diameter in. to ft., Diameter in. to ft. Casing height above land surface in. Weight lbs./ft. Wall thickness or gauge No.

TYPE OF SCREEN OR PERFORATION MATERIAL: Steel Stainless Steel Fiberglass PVC Other (Specify) Brass Galvanized Steel Concrete tile None used (open hole)

SCREEN OR PERFORATION OPENINGS ARE: Continuous Slot Mill Slot Gauze Wrapped Torch Cut Drilled Holes Other (Specify) Louvered Shutter Key Punched Wire Wrapped Saw Cut None (Open Hole)

SCREEN-PERFORATED INTERVALS: From 2.63 ft. to 12.63 ft., From ft. to ft., From ft. to ft. GRAVEL PACK INTERVALS: From 2.63 ft. to 12.63 ft., From ft. to ft., From ft. to ft.

9 GROUT MATERIAL: Neat cement Cement grout Bentonite Other Concrete Surface Completion 0 - 63 Grout Intervals: From 63 ft. to 2.63 ft., From ft. to ft., From ft. to ft.

Nearest source of possible contamination: Septic Tank Lateral Lines Pit Privy Livestock Pens Insecticide Storage Sewer Lines Cess Pool Sewage Lagoon Fuel Storage Abandoned Water Well Watertight Sewer Lines Seepage Pit Feedyard Fertilizer Storage Oil Well/Gas Well Other (Specify) Direction from well? Distance from well? ft.

Table with columns: FROM, TO, LITHOLOGIC LOG, FROM, TO, LITHO. LOG (cont.) or PLUGGING INTERVALS. Row 1: 0, 12, SILTY CLAY


Notes:

11 CONTRACTOR'S OR LANDOWNER'S CERTIFICATION: This water well was constructed, reconstructed, or plugged under my jurisdiction and was completed on (mo-day-year) 2/20/18 and this record is true to the best of my knowledge and belief. Kansas Water Well Contractor's License No. 585 This Water Well Record was completed on (mo-day-year) 2/26/18 under the business name of ASSOCIATED ENVIRONMENTAL INC. Signature

Cowley

NE NE NE NE
SE SE SE SE
SW SW SW SW
NW NW NW NW

13-34-3E
2-34-3E
7-34-4E
18-34-4E

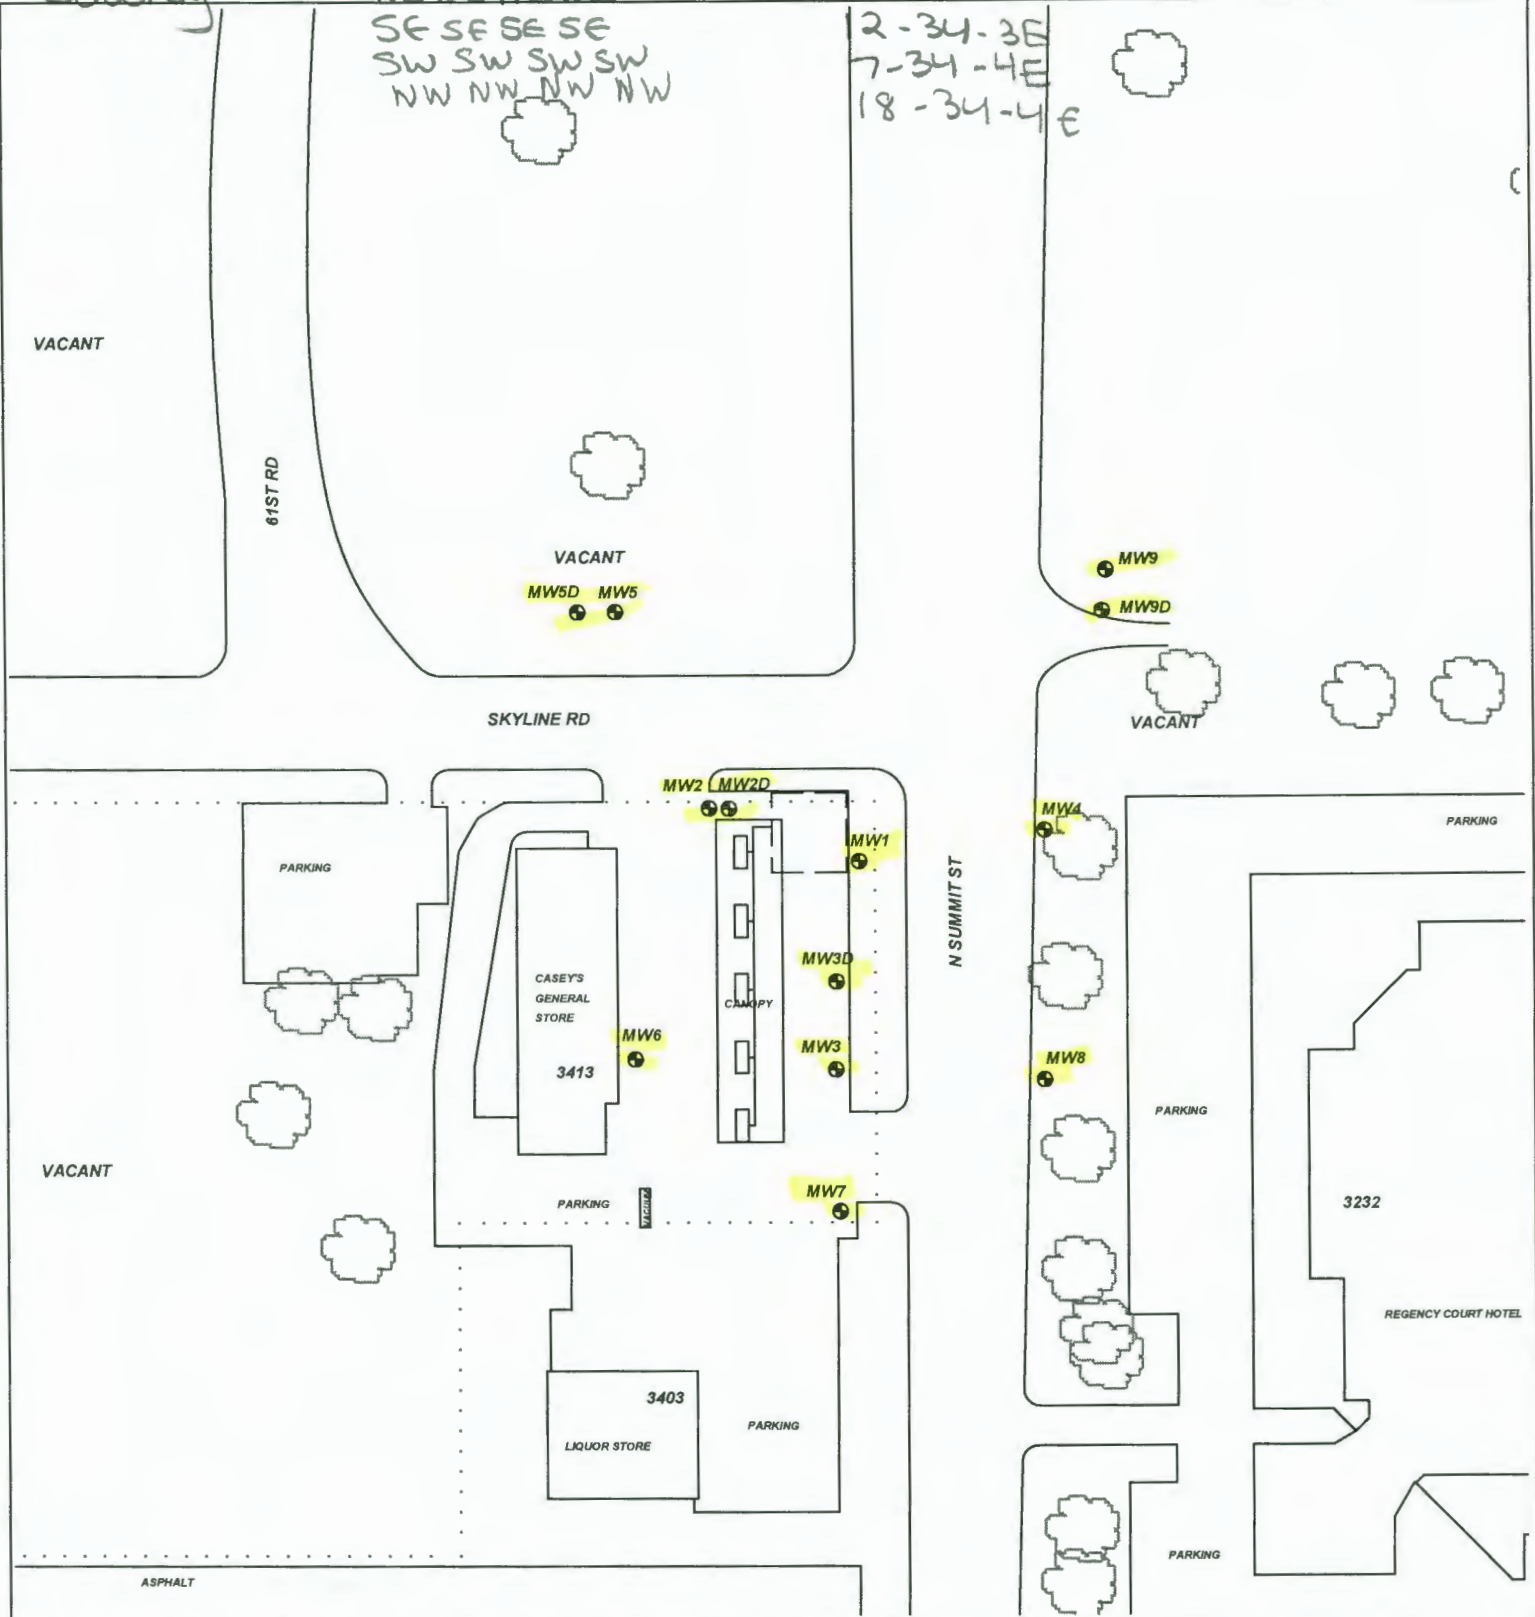

PROJECT: CASEY'S GENERAL STORE #3435
ADDRESS: 3413 N. SUMMIT
LOCATION: ARKANSAS CITY, KS
DRAWN BY: B. STALNAKER **DATE:** 4/26/17
REVISED BY: B. STALNAKER **DATE:** 9/27/18
AEI JOB #: TF501 **KDHE JOB #:** U2-018-14122

TITLE:

ASSOCIATED ENVIRONMENTAL INC.

LEGEND:

- = CURRENT UST's (1)8,000 & (1)12,000 GAL. GASOLINE, (1)10,000 GAL. DIESEL
- = MONITOR WELL
- = CURRENT PUMPS AND PRODUCT LINES
- = SUBJECT PROPERTY

SCALE: 1" = 100'

NOTES:
 No basements observed within 500'.