
				WWC-5) a u	160	1				1			
	WELL REC	CORD X Co		WWC-5 ge in Well Ust	Lev	136		sion of Water urces App. No.			Well ID	MW4		
1	ATION OF V		R WELL:	Fraction	CW 1/	0337 1	/ NOV/ 1			Township Nun		ge Number 14 X E W		
County 2 WEL	Montgome		 me:	First:	First: SW 1/4 SW Stre			1/4 NW 1/4 7 T 35 S R et or Rural Address where well is located (if unknown, dista						
Busine Addres Addres	ess: Casey's Ress: PO Box 30	etail Con 004	mpany			from		n or intersection		If at owner's ac	•			
3 LOCA	Anl	keny	State: IA 4 DEPTH OF	ZIP: 500 COMPLETED		20.5	A T	5 Latitude		37.016	85 (6	decimal degrees)		
WITH	I "X" IN ION BOX:	_	Depth(s) Groundwa 2) ft WELL'S STATIC V X below land s	ter Encountered 3)ft, VATER LEVEL surface, measure	Encountered: 1) ft, or 4) Dry W			Longitude 95.92824 (decimal degrees) Horizontal Datum: WGS 84 NAD 83 NAD 27 Source for Latitude/Longitude: GPS (unit make/model:) (WAAS enabled? Yes No)						
NW V	NE I		Pump test data: \	Well water was	***************************************	ft		X Land		ey Topog		10)		
w x		E		hours pumping Water well wa hours pumping	IS	ft	-	ld		• •	Ground	Level X TOC		
sw I	SE		Estimated Yield:	gpı	m		İ		Lan	nd Survey	GPS	Topographic Map		
	S 1 mile		Bore Hole Diame		in to	ft		L			7			
7 WELL 1 Domestic:	WATER TO	BE US		Supply: well II)		1	0 Oil Field	l Water	r Supply: lease	•			
House			6 Dewatering:	how many well				1 Test Hole: w	ell ID					
	Lawn & Garden 7 Aquifer Recharge: w Livestock 8 X Monitoring: well ID									Cased Uncased Geotechnical				
2 Irrigati		9 Environmental Re		l ID	12 Geothermal: How many bores? a) Closed Loop Horizontal Vertical						ical			
3 Feedlo								b) Open Loop Surface Discharge Inj. of Water						
4 Industr	rial		Recovery	Injecti	on			Other (sp	pecify)):				
Was a chemical/bacteriological sample submitted to KDHE? Yes X No If yes, date sample was submitted: Water well disinfected? Yes X No														
8 TYPE OF CASING USED: Steel X PVC Other CASING JOINTS: Glued Clampled Welded X Threaded Casing diameter 2 in. to 10.5 ft, Diameter in. to ft, Diameter in. to ft, Diameter in. to ft, Type OF SCREEN OR PERFORATION MATERIAL:														
Steel Stainless Steel Fiberglass X PVC Other (Specify) Brass Galvanized Steel Concrete tile None used (open hole) SCREEN OR PERFORATION OPENINGS ARE:														
		X Mil		auze Wrapped	Пто	orch Cut	Drille	ed Holes		Other (Specify	·)			
Louvered Shutter Key Punched Wire Wrapped Saw Cut None (Open Hole)										A				
	VEL PACK IN				20.5 ft, 20.5 ft,			. to	11, ft,	From		tt,		
	MATERIAL:		Neat cement	Cement grout		ntonite	X Other	Concrete: 0-1		***************************************				
Grout interva	ıls: From		ft. to 8.5 ft,		ft. to			nft		ft,	•••••••••••			
	rce of possible	e conta							_		_			
Septic			Lateral Lines Cess Pool		t Privy wage Lago	on		stock Pens	F	Insecticide	e Storage d Water Wel	1		
	Sewer Lines Cess Pool Sewage Li Watertight Sewer Lines Seepage Pit Feedyard					·	Fuel Storage Abandoned Water Well Fertilizer Storage Oil Well / Gas Well							
	(Specity)							·	_					
Direction from			T TOTAL OF		stance from	well?		T #0		ft				
10 FROM 0	TO	Topsoil	LITHOI l, gravel	LOGIC LOG			FROM	TO	+	LITHO. LOG (co	ont.) or PLUGO	GING INTERVALS		
1	8.5	Silty clay												
8.5	20.5	Limestone, clay						-	-					
							Notes VDHE ID: Coords Commission #2025 1/2 0/2 15244							
						т	Notes: KDHE ID: Casey's General Store #3925; U3-063-15344 Target of monitoring well is shallow groundwater, <20' of grout was installed at							
11 CONT	PACTODIS C	D I AN	NDOWNER'S CERT	TIEICATION	This water		he direction	of KDHE.	7 +00	onstructed, or	nlugged	l under my		
1			n (mo-day-year)	1/16/23 and	d this record	d is true to	the best of	my knowledge						
License No 757 This Water Well Record was completed on (mo-day-year) 2/20/23														
under the business name of Larsen & Associates, Inc. Mail 1 white copy along with a fee of \$5.00 for each constructed well to: Kansas Department of Health and Environment, Bureau of Water, 12 Section,														
Vicit ve	1000 SW J	ackson S	St., Suite 420, Topeka, K		7. Mail one	to Water W					785-296-552			



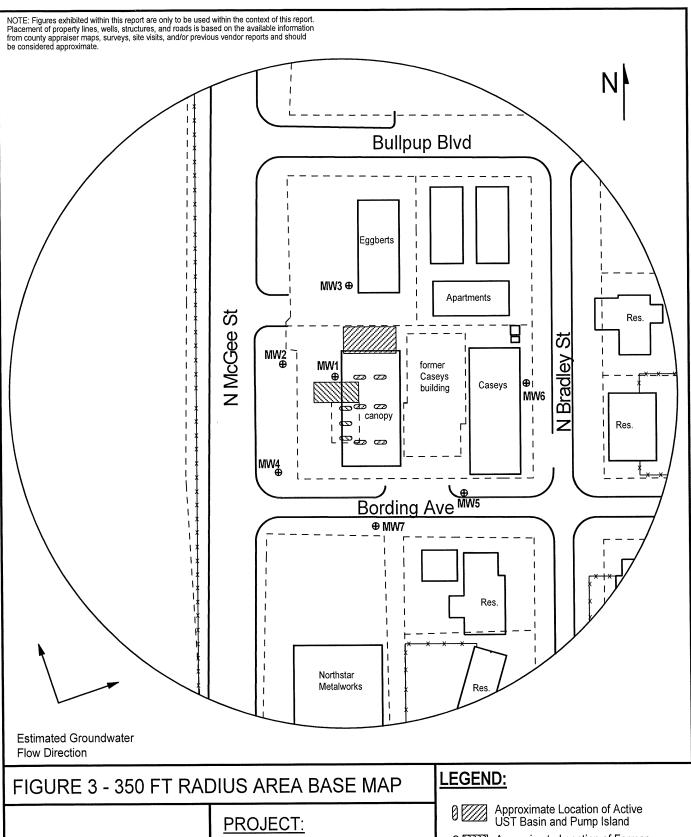

1311 E 25th St., Suite B Lawrence, KS 66046 (785) 841-8707 office (785) 865-4282 fax Casey's General Store #3925 606 N McGee St Caney, KS

KDHE ID: U3-063-15344

Date: 1/18-19/23

0 100 ft

Approximate Location of Former UST Basin and Pump Island

New Monitoring Well (Installed 1/16-19/23)

Overhead Lines (25-40 ft high)
Sanitary Sewer (2 - 6 ft BGS)

— Water (2 - 6 ft BGS)

NOTE: Utility depths and locations are approximate.