

☒ Original Record ☐ Correction ☐ Change in Well Use


Division of Water
Resources App. No.

Well ID

MW7

1 LOCATION OF WATER WELL: County Montgomery		Fraction NW ¼ NW ¼ NW ¼ SW ¼	Section Number 7	Township Number T 35 S R 14 E W	
2 WELL OWNER: Last Name: Business:: Casey's Retail Company Address: PO Box 3004 City Ankeny State: IA ZIP: 50021		Street or Rural Address where well is located (if unknown, distance and direction from nearest town or intersection): If at owner's address, check here: ~50' south of 606 N McGee St, Caney, KS			
3 LOCATE WELL WITH "X" IN SECTION BOX:	4 DEPTH OF COMPLETED WELL: 20 ft Depth(s) Groundwater Encountered: 1) _____ ft 2) _____ ft 3) _____ ft, or 4) <input type="checkbox"/> Dry Well WELL'S STATIC WATER LEVEL: 8.21 ft. <input checked="" type="checkbox"/> below land surface, measured on (mo-day-yr) 1/18-19/23 <input type="checkbox"/> above land surface, measured on (mo-day-yr) Pump test data: Well water was _____ ft after _____ hours pumping gpm Water well was _____ ft after _____ hours pumping gpm Estimated Yield: _____ gpm Bore Hole Diameter: 7.25 in to _____ ft, and _____ in to _____ ft		5 Latitude: 37.01666 (decimal degrees) Longitude: 95.92804 (decimal degrees) Horizontal Datum: <input checked="" type="checkbox"/> WGS 84 <input type="checkbox"/> NAD 83 <input type="checkbox"/> NAD 27 Source for Latitude/Longitude: <input type="checkbox"/> GPS (unit make/model:) (WAAS enabled? <input type="checkbox"/> Yes <input type="checkbox"/> No) <input checked="" type="checkbox"/> Land Survey <input type="checkbox"/> Topographic Map <input type="checkbox"/> Online Mapper		
			6 Elevation: 777.72 ft <input type="checkbox"/> Ground Level <input checked="" type="checkbox"/> TOC Source: <input checked="" type="checkbox"/> Land Survey <input type="checkbox"/> GPS <input type="checkbox"/> Topographic Map <input type="checkbox"/> Other		
7 WELL WATER TO BE USED AS:					
1 Domestic: <input type="checkbox"/> Household <input type="checkbox"/> Lawn & Garden <input type="checkbox"/> Livestock 2 <input type="checkbox"/> Irrigation 3 <input type="checkbox"/> Feedlot 4 <input type="checkbox"/> Industrial		5 <input type="checkbox"/> Public Water Supply: well ID 6 <input type="checkbox"/> Dewatering: how many wells? 7 <input type="checkbox"/> Aquifer Recharge: well ID 8 <input checked="" type="checkbox"/> Monitoring: well ID MW7 9 Environmental Remediation: well ID <input type="checkbox"/> Air Sparge <input type="checkbox"/> Soil Vapor Extractor <input type="checkbox"/> Recovery <input type="checkbox"/> Injection		10 <input type="checkbox"/> Oil Field Water Supply: lease 11 Test Hole: well ID <input type="checkbox"/> Cased <input type="checkbox"/> Uncased <input type="checkbox"/> Geotechnical 12 Geothermal: How many bores? a) Closed Loop <input type="checkbox"/> Horizontal <input type="checkbox"/> Vertical b) Open Loop <input type="checkbox"/> Surface Discharge <input type="checkbox"/> Inj. of Water <input type="checkbox"/> Other (specify):	
Was a chemical/bacteriological sample submitted to KDHE? <input type="checkbox"/> Yes <input checked="" type="checkbox"/> No If yes, date sample was submitted:					
Water well disinfected? <input type="checkbox"/> Yes <input checked="" type="checkbox"/> No					
8 TYPE OF CASING USED: <input type="checkbox"/> Steel <input checked="" type="checkbox"/> PVC <input type="checkbox"/> Other CASING JOINTS: <input type="checkbox"/> Glued <input type="checkbox"/> Clamped <input type="checkbox"/> Welded <input checked="" type="checkbox"/> Threaded Casing diameter 2 in. to 10 ft, Diameter _____ in. to _____ ft, Diameter _____ in. to _____ ft, Casing height above land surface -0.32 in. Weight _____ lbs./ft. Well thickness or gauge No _____					
TYPE OF SCREEN OR PERFORATION MATERIAL: <input type="checkbox"/> Steel <input type="checkbox"/> Stainless Steel <input type="checkbox"/> Fiberglass <input checked="" type="checkbox"/> PVC <input type="checkbox"/> Other (Specify) <input type="checkbox"/> Brass <input type="checkbox"/> Galvanized Steel <input type="checkbox"/> Concrete tile <input type="checkbox"/> None used (open hole)					
SCREEN OR PERFORATION OPENINGS ARE: <input type="checkbox"/> Continuous Slot <input checked="" type="checkbox"/> Mill Slot <input type="checkbox"/> Gauze Wrapped <input type="checkbox"/> Torch Cut <input type="checkbox"/> Drilled Holes <input type="checkbox"/> Other (Specify) <input type="checkbox"/> Louvered Shutter <input type="checkbox"/> Key Punched <input type="checkbox"/> Wire Wrapped <input type="checkbox"/> Saw Cut <input type="checkbox"/> None (Open Hole)					
SCREEN-PERFORATED INTERVALS: From 10 ft. to 20 ft., From _____ ft. to _____ ft., From _____ ft. to _____ ft., GRAVEL PACK INTERVALS: From 8 ft. to 20 ft., From _____ ft. to _____ ft., From _____ ft. to _____ ft.					
9 GROUT MATERIAL: <input type="checkbox"/> Neat cement <input type="checkbox"/> Cement grout <input checked="" type="checkbox"/> Bentonite <input checked="" type="checkbox"/> Other Concrete: 0-1' Grout intervals: From 1 ft. to 8 ft., From _____ ft. to _____ ft., From _____ ft. to _____ ft.					
Nearest source of possible contamination: <input type="checkbox"/> Septic Tank <input type="checkbox"/> Lateral Lines <input type="checkbox"/> Pit Privy <input type="checkbox"/> Livestock Pens <input type="checkbox"/> Insecticide Storage <input type="checkbox"/> Sewer Lines <input type="checkbox"/> Cess Pool <input type="checkbox"/> Sewage Lagoon <input type="checkbox"/> Fuel Storage <input type="checkbox"/> Abandoned Water Well <input type="checkbox"/> Watertight Sewer Lines <input type="checkbox"/> Seepage Pit <input type="checkbox"/> Feedyard <input type="checkbox"/> Fertilizer Storage <input type="checkbox"/> Oil Well / Gas Well <input type="checkbox"/> Other (Specity)					
Direction from well? N Distance from well? ~85 ft					
10 FROM	TO	LITHOLOGIC LOG	FROM	TO	LITHO. LOG (cont.) or PLUGGING INTERVALS
0	1	Topsoil, some gravel			
1	8	Clay			
8	20	Weathered limestone			
			Notes: KDHE ID: Casey's General Store #3925; U3-063-15344 Target of monitoring well is shallow groundwater, <20' of grout was installed at the direction of KDHE.		
11 CONTRACTOR'S OR LANDOWNER'S CERTIFICATION: This water well was <input checked="" type="checkbox"/> constructed, <input type="checkbox"/> reconstructed, or <input type="checkbox"/> plugged under my jurisdiction and was completed on (mo-day-year) 1/18/23 and this record is true to the best of my knowledge and belief. Kansas Water Well Contractor's License No 757 This Water Well Record was completed on (mo-day-year) 2/20/23 under the business name of Larsen & Associates, Inc. Signature [Signature]					
Mail 1 white copy along with a fee of \$5.00 for each constructed well to: Kansas Department of Health and Environment, Bureau of Water, GWTS Section, 1000 SW Jackson St., Suite 420, Topeka, Kansas 66612-1367. Mail one to Water Well Owner and retain one for your records. Telephone 785-296-5524.					
Visit us at http://www.kdheks.gov/waterwell/index.html			KSA 82a-1212		Revised 7/10/2015

NOTE: Figures exhibited within this report are only to be used within the context of this report. Placement of property lines, wells, structures, and roads is based on the available information from county appraiser maps, surveys, site visits, and/or previous vendor reports and should be considered approximate.

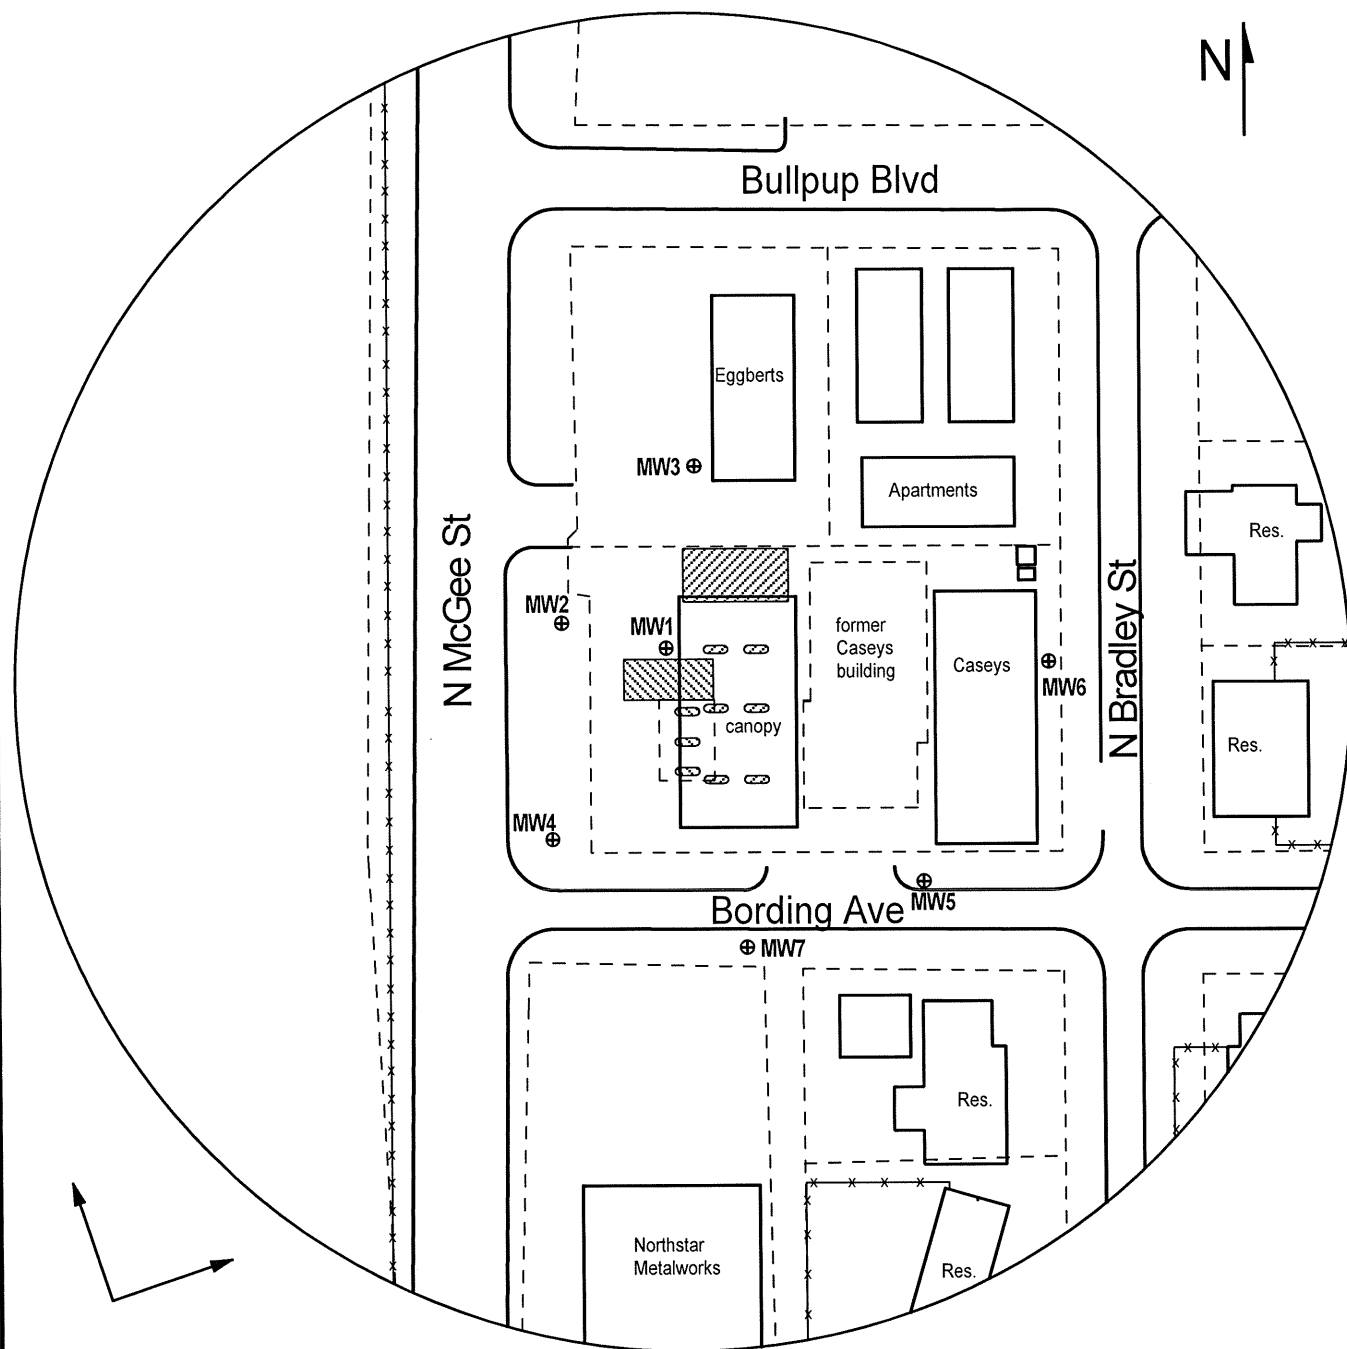

Estimated Groundwater
Flow Direction

FIGURE 3 - 350 FT RADIUS AREA BASE MAP



1311 E 25th St., Suite B (785) 841-8707 office
Lawrence, KS 66046 (785) 865-4282 fax

PROJECT:

Casey's General Store #3925
606 N McGee St
Caney, KS
KDHE ID: U3-063-15344
Date: 1/18-19/23



LEGEND:

- Approximate Location of Active UST Basin and Pump Island
- Approximate Location of Former UST Basin and Pump Island
- New Monitoring Well (Installed 1/16-19/23)
- Overhead Lines (25-40 ft high)
- Sanitary Sewer (2 - 6 ft BGS)
- Gas (2 - 6 ft BGS)
- Water (2 - 6 ft BGS)

NOTE: Utility depths and locations are approximate.