

WATER WELL RECORD

Form WWC-5

Division of Water Resources App. No.

SMW-21A

1 LOCATION OF WATER WELL: County: Doniphan, Fraction SW 1/4 SW 1/4 NE 1/4 1/4, Section Number 36, Township No. T 3 S, Range Number R 22 E W, Street/Rural Address of Well Location: 2009 Roseport Road, Elwood,KS, Global Positioning System (GPS) information: Latitude: 39.7472, Longitude: 94.8966, Elevation: , Datum: WGS 84, NAD 83, NAD 27, Collection Method: GPS unit, Digital Map/Photo, Topographic Map, Land Survey, Est. Accuracy: <3 m, 3-5 m, 5-15 m, >15 m

2 WATER WELL OWNER: Snorkel International, RR#, Street Address, Box #: 2009 Roseport Road, City, State, ZIP Code : Elwood, KS 66090, 3 LOCATE WELL WITH AN "X" IN SECTION BOX: [Diagram showing a 36-section grid with an 'X' in the SW section], 4 DEPTH OF COMPLETED WELL 50.0' ft., Depth(s) Groundwater Encountered (1) 1 ft., (2) 8.52 ft., (3) , WELL'S STATIC WATER LEVEL 8.52' ft. below land surface measured on mo/day/yr. 10/2011, Pump test data: Well water was . ft. after . hours pumping, EST. YIELD . gpm, Well water was . ft. after . hours pumping, Bore Hole Diameter 3.25" in. to . ft., and . in. to . ft., WELL WATER TO BE USED AS: Public water supply, Geothermal, Injection well, Domestic, Feedlot, Oil field water supply, Dewatering, Other (Specify below), Irrigation, Industrial, Domestic-lawn & garden, Monitoring well, Was a chemical/bacteriological sample submitted to Department? Yes No, If yes, mo/day/yr sample was submitted. , Water well disinfected? Yes No


5 TYPE OF CASING USED: Steel PVC Other, CASING JOINTS: Glued Clamped Welded Threaded, Casing diameter 1.0" in. to 40.0' ft., Diameter in. to . ft., Diameter in. to . ft., Casing height above land surface. Flush in., Weight lbs./ft., Wall thickness or gauge No. Sch. 40, TYPE OF SCREEN OR PERFORATION MATERIAL: Steel Stainless Steel PVC Other (Specify), Brass Galvanized Steel None used (open hole), SCREEN OR PERFORATION OPENINGS ARE: Continuous slot Mill slot Gauze wrapped Torch cut Drilled holes None (open hole), Louvered shutter Key punched Wire wrapped Saw cut Other (specify), SCREEN-PERFORATED INTERVALS: From 40.0' ft. to 50.0' ft., From . ft. to . ft., From . ft. to . ft., GRAVEL PACK INTERVALS: From 38.0' ft. to 50.0' ft., From . ft. to . ft., From . ft. to . ft.


6 GROUT MATERIAL: Neat cement Cement grout Bentonite Other, Grout Intervals: From 1.0' ft. to 38.0' ft., From . ft. to . ft., From . ft. to . ft., What is the nearest source of possible contamination: Septic tank Lateral lines Pit privy Livestock pens Insecticide storage Other (specify below), Sewer lines Cesspool Sewage lagoon Fuel storage Abandoned water well, Watertight sewer lines Seepage pit Feedyard Fertilizer storage Oil well/gas well, Direction from well . Distance from well .

Table with columns: FROM, TO, LITHOLOGIC LOG, FROM, TO, LITHO. LOG (cont.) or PLUGGING INTERVALS. Rows include: 0-15.0' Silty Fine Sand, Clayey Silt, Clay; 15.0'-30.0' Fine to Medium Sand; 30.0'-35.0' Silt; 35.0'-50.0' Medium Sand; 50.0' Bottom of Well.

7 CONTRACTOR'S OR LANDOWNER'S CERTIFICATION: This water well was constructed, reconstructed, or plugged under my jurisdiction and was completed on (mo/day/year) 10/25/11 and this record is true to the best of my knowledge and belief. Kansas Water Well Contractor's License No. 606. This Water Well Record was completed on (mo/day/year) 01/31/12 under the business name of PSA Environmental by (signature)

INSTRUCTIONS: Use typewriter or ball point pen. PLEASE PRESS FIRMLY and PRINT clearly. Please fill in blanks and check the correct answers. Send three copies (white, blue, pink) to Kansas Department of Health and Environment, Bureau of Water, Geology Section, 1000 SW Jackson St., Suite 420, Topeka, Kansas 66612-1367. Telephone 785-296-5522. Send one copy to WATER WELL OWNER and retain one for your records. Include fee of \$5.00 for each constructed well. Visit us at http://www.kdheks.gov/waterwell/index.html.

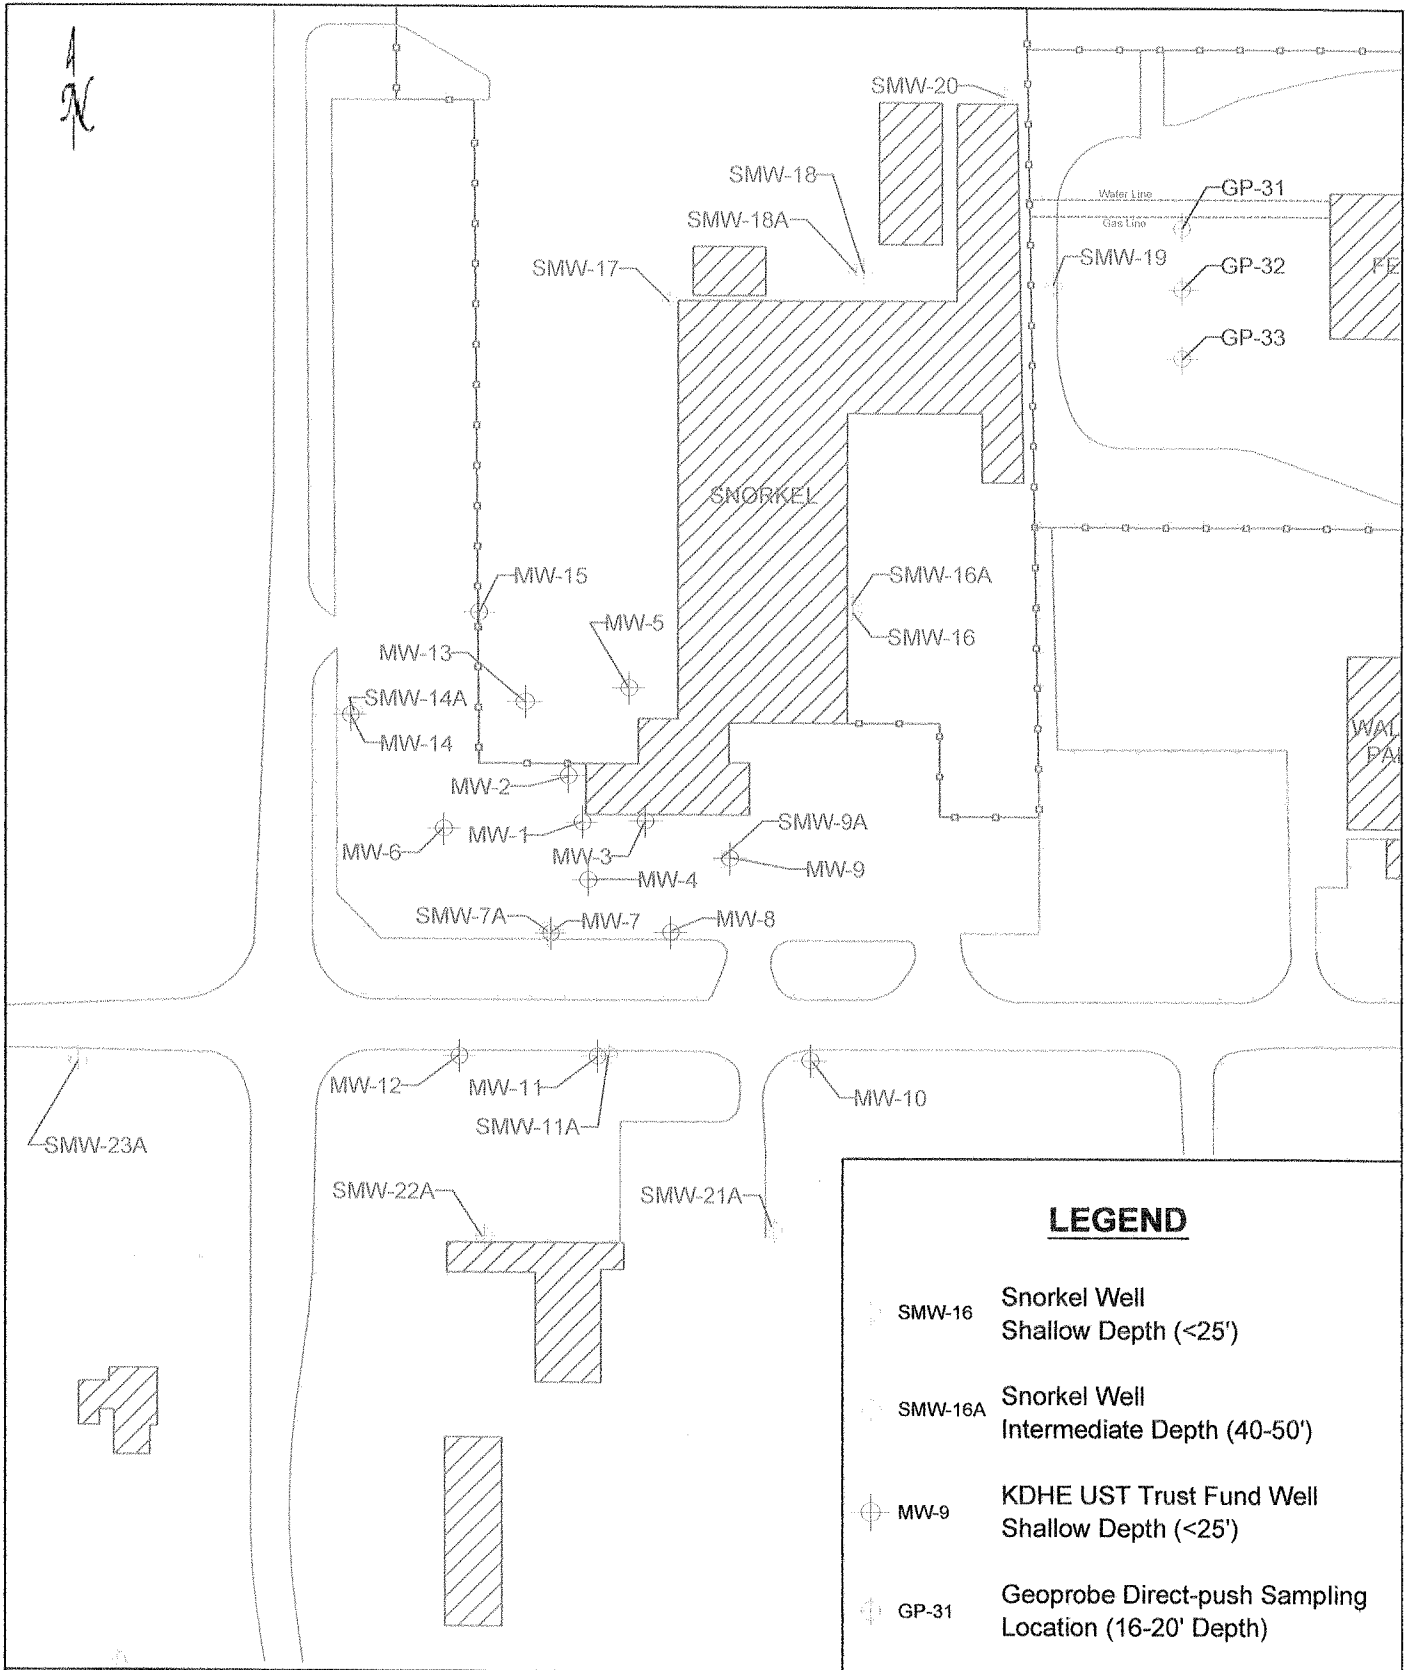

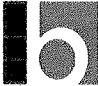 BLACKSTONE ENVIRONMENTAL	Site Map		Figure 2
	Snorkel International Elwood, Kansas	DATE: 12/27/2012 DRAWN: CJB CHECKED: FDA	