

WATER WELL RECORD Form WWC-5

Original Record Correction Change in Well Use

Division of Water Resources App. No.

Well ID

1 LOCATION OF WATER WELL: County: Doniphan	Fraction ¼ NW ¼ SW ¼ NE ¼	Section Number 28	Township Number T 3 S	Range Number R 22 E W
--	------------------------------	----------------------	--------------------------	--------------------------

2 WELL OWNER: Last Name: First: Business: <u>Riverside School District 114</u> Address: <u>P.O. Box 49</u> City: <u>Elwood</u> State: <u>KS</u> ZIP: <u>66024</u>	Street or Rural Address where well is located (if unknown, distance and direction from nearest town or intersection): If at owner's address, check here: <input type="checkbox"/>
---	---

3 LOCATE WELL WITH "X" IN SECTION BOX:

N

NW	NE
SW	SE

S

-----1 mile-----

4 DEPTH OF COMPLETED WELL: 73 ft.

Depth(s) Groundwater Encountered: 1) 58 ft.
2) _____ ft. 3) _____ ft. or 4) Dry Well

WELL'S STATIC WATER LEVEL: 17 ft.
 below land surface, measured on (mo-day-yr) 7-11-1985
 above land surface, measured on (mo-day-yr) _____

Pump test data: Well water was _____ ft.
after _____ hours pumping _____ gpm
Well water was _____ ft.
after _____ hours pumping _____ gpm

Estimated Yield: 30 gpm
Bore Hole Diameter: 12 in. to _____ ft. and _____ in. to _____ ft.

5 Latitude: 39.765703 (decimal degrees)
Longitude: 94.953931 (decimal degrees)
Horizontal Datum: WGS 84 NAD 83 NAD 27
Source for Latitude/Longitude:
 GPS (unit make/model: _____) (WAAS enabled? Yes No)
 Land Survey Topographic Map
 Online Mapper: Google Earth

6 Elevation: 842 ft. Ground Level TOC
Source: Land Survey GPS Topographic Map
 Other Google Earth

7 WELL WATER TO BE USED AS:

1. Domestic: <input type="checkbox"/> Household <input checked="" type="checkbox"/> Lawn & Garden <input type="checkbox"/> Livestock	5. <input type="checkbox"/> Public Water Supply: well ID _____ 6. <input type="checkbox"/> Dewatering: how many wells? _____ 7. <input type="checkbox"/> Aquifer Recharge: well ID _____ 8. <input type="checkbox"/> Monitoring: well ID _____	10. <input type="checkbox"/> Oil Field Water Supply: lease _____ 11. Test Hole: well ID _____ <input type="checkbox"/> Cased <input type="checkbox"/> Uncased <input type="checkbox"/> Geotechnical
2. <input type="checkbox"/> Irrigation	9. Environmental Remediation: well ID _____ <input type="checkbox"/> Air Sparge <input type="checkbox"/> Soil Vapor Extraction <input type="checkbox"/> Recovery <input type="checkbox"/> Injection	12. Geothermal: how many bores? _____ a) Closed Loop <input type="checkbox"/> Horizontal <input type="checkbox"/> Vertical b) Open Loop <input type="checkbox"/> Surface Discharge <input type="checkbox"/> Inj. of Water
3. <input type="checkbox"/> Feedlot	4. <input type="checkbox"/> Industrial	13. <input type="checkbox"/> Other (specify): _____

Was a chemical/bacteriological sample submitted to KDHE? Yes No If yes, date sample was submitted: _____
Water well disinfected? Yes No

8 TYPE OF CASING USED: Steel PVC Other _____ CASING JOINTS: Glued Clamped Welded Threaded
Casing diameter 5 in. to 0-58 ft., Diameter 5 in. to 68-73 ft., Diameter _____ in. to _____ ft.
Casing height above land surface -12 in. Weight 2.82 lbs./ft. Wall thickness or gauge No. 0.258

TYPE OF SCREEN OR PERFORATION MATERIAL: Note: Pitless unit (steel) installed from -1 to -4 with threaded connection.
 Steel Stainless Steel Fiberglass PVC Other (Specify) _____
 Brass Galvanized Steel Concrete tile None used (open hole)

SCREEN OR PERFORATION OPENINGS ARE:
 Continuous Slot Mill Slot Gauze Wrapped Torch Cut Drilled Holes Other (Specify) _____
 Louvered Shutter Key Punched Wire Wrapped Saw Cut None (Open Hole)

SCREEN-PERFORATED INTERVALS: From 58 ft. to 68 ft., From _____ ft. to _____ ft., From _____ ft. to _____ ft.
GRAVEL PACK INTERVALS: From 10 ft. to 73 ft., From _____ ft. to _____ ft., From _____ ft. to _____ ft.

9 GROUT MATERIAL: Neat cement Cement grout Bentonite Other _____
Grout Intervals: From 4 ft. to 24 ft., From _____ ft. to _____ ft., From _____ ft. to _____ ft.

Nearest source of possible contamination:
 Septic Tank Lateral Lines Pit Privy Livestock Pens Insecticide Storage
 Sewer Lines Cess Pool Sewage Lagoon Fuel Storage Abandoned Water Well
 Watertight Sewer Lines Seepage Pit Feedyard Fertilizer Storage Oil Well/Gas Well
 Other (Specify) _____


Direction from well? N Distance from well? 100 ft.

10 FROM	TO	LITHOLOGIC LOG	FROM	TO	LITHO. LOG (cont.) or PLUGGING INTERVALS
0	6	Top Soil			
6	30	Clay Brown			
30	58	Clay Blue			
58	65	Chert 8x1/2x1/2x1 - Blue			
65	73	Limestone Gray			
Notes: <u>old USD 406</u>					

11 CONTRACTOR'S OR LANDOWNER'S CERTIFICATION: This water well was constructed, reconstructed, or plugged under my jurisdiction and was completed on (mo-day-year) 9-4-2015 and this record is true to the best of my knowledge and belief. Kansas Water Well Contractor's License No. 308. This Water Well Record was completed on (mo-day-year) 9-25-2015 under the business name of Rieschick Drilling Co. Signature [Signature]

R

Rieschick Engineering & Consulting, LLC

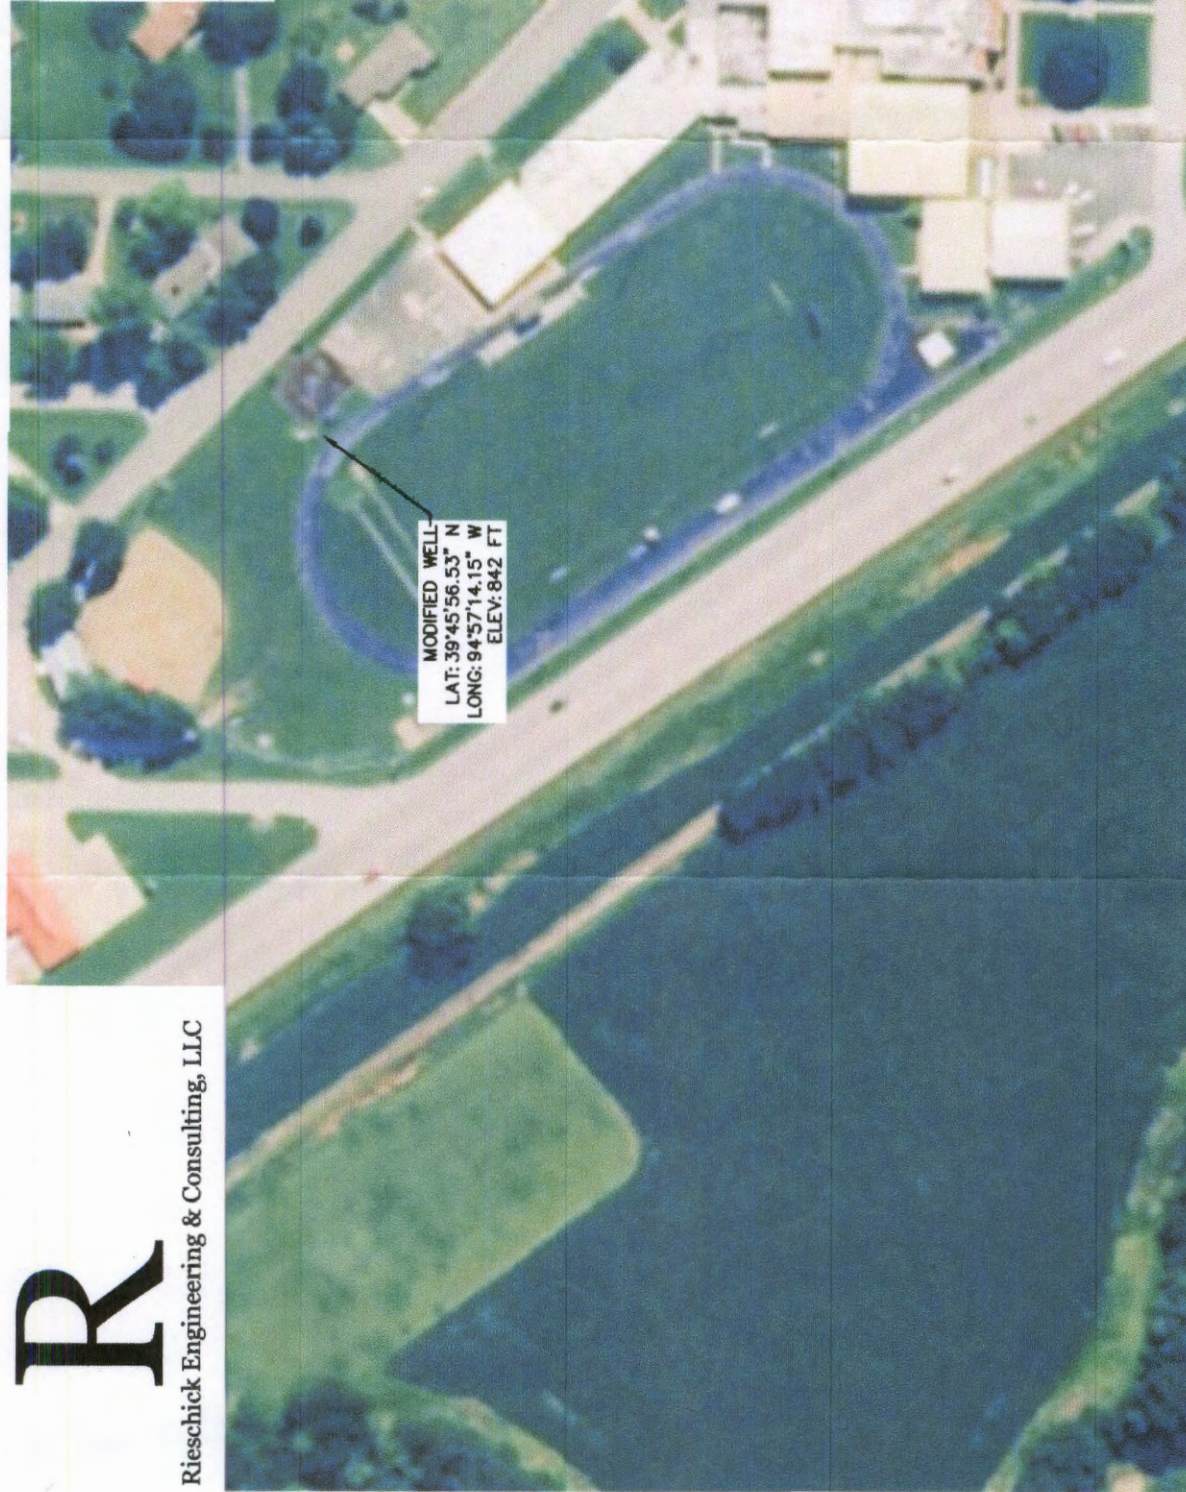

UTILITIES NOTE: BEFORE THE START OF CONSTRUCTION, THE OWNER OF ANY UTILITIES INVOLVED MUST BE NOTIFIED. THE EXCAVATOR/CONTRACTOR IS RESPONSIBLE FOR GIVING THIS NOTICE BY CALLING "DIGGER'S HOTLINE" AT 1-800-331-5666 AT LEAST 48 HOURS PRIOR TO ANY EXCAVATION.

RIESCHICK ENGINEERING & CONSULTING, LLC
ANDREW RIESCHICK, P.E.
7055 649TH AVE.
FAIRFAX, VA 22035
(422) 801-1422

R
Rieschick Engineering & Consulting, LLC

DATE	PROJECT	DRAWN BY:	DESIGNED BY:	SHEET 1 OF 1
09/25/2015	RIVERSIDE SCHOOL	AQR	AQR	