
		RECORD		WWC-5			sion of Water			MW-3	
		Correction		ge in Well Use			irces App. No		Well ID		
1 LOCATION OF WATER WELL:			Fraction	Secti	ion Number	Township Numb		nge Number			
County: Doniphan				NW 4 NW 4 NE 4					2 🔳 E 🗌 W		
2 WELL	OWNER:	ast Name:		First:				here well is located			
	Wilbur-El					ion from nearest town or intersection): If at owner's address, check here:					
Address:	2273 Hw	y 36			Approximately 1/4 mile SE of St. Joseph St. on west side of Hwy						
City:	Wathena		State: KS	ZIP:	36						
3 LOCAT					20.754722						
WITH "				MPLETED WELL:							
SECTION ROY: Depth(s) Groundwater 1							Longitude:94.940277(decimal degrees) Horizontal Datum: ■ WGS 84 □ NAD 83 □ NAD 27				
1	V	2) ft. 3) ft., or 4) 🗆 l								83 LI NAD 2/	
K							Source for Latitude/Longitude:  GPS (unit make/model:)				
	NE		☐ below land surface, measured on (mo-day-yr)☐ above land surface, measured on (mo-day-yr)					(WAAS enabled?			
	1		Pump test data: Well water was					☐ Land Survey ☐ Topographic Map			
1 1 )       -				hours pumping gpm			■ Online Mapper: Google Earth				
SW/	SE				ter was ft.						
SW	SE			pumping gpm			6 Elevation: NAft. ☐ Ground Level ☐ TOC				
LL		Estimated Y	'ield:	gpm 3.75 in. to 17.0 ft. and			Source: Land Survey GPS Topographic Map				
	S nile	Bore Hole I	Jiameter:	9.4.9 in. to!	n. to						
· · · · · · · · · · · · · · · · · · ·		O BE USED A		in. to	11.						
1. Domestic				ater Supply: well ID			10 🗆 Oil	Field Water Supply: 1	eace		
House		5. L	] Dewaterir	ng: how many wells?		• • • • • • • • • • • • • • • • • • • •	10.  Oil Field Water Supply: lease				
. —	& Garden	7.	] Aguifer R	echarge: well ID			☐ Cased ☐ Uncased ☐ Geotechnical				
Livesto		8.	Monitorin	echarge: well ID g: well ID	W-3			rmal: how many bore			
2. 🗌 Irrigati	ion			al Remediation: well I				sed Loop 🔲 Horizon			
3. Teedlo			] Air Sparg		Soil Vapor Extraction b) Open Loop  Surface Discharge  Inj. o						
4. Industrial Recovery Injection 13. Other (specify):											
Was a chemical/bacteriological sample submitted to KDHE?   Yes  No If yes, date sample was submitted:											
Water well	disinfected	? 🗌 Yes 🔳	No					•			
8 TYPE C	F CASINO	GUSED: S	teel 🔳 PV	C Other	C	ASIN	G JOINTS:	☐ Glued ☐ Clampe	d 🔲 Welde	d Threaded	
Casing diam	neter2	in. to	.7.0 ft.,	, Diameter	in. to		ft., Diame	ter in. to	ft.		
Casing heigh	ht above land	surface	0 ir	n. Weight	lbs	s./ft.	Wall thickn	ess or gauge No. SCh	40		
		R PERFORA									
☐ Steel ☐ Stainless Steel ☐ Fiberglass ☐ PVC ☐ Other (Specify)											
☐ Brass ☐ Galvanized Steel ☐ Concrete tile ☐ None used (open hole)											
SCREEN OR PERFORATION OPENINGS ARE:  Continuous Slot  Mill Slot  Gauze Wrapped  Torch Cut  Drilled Holes  Other (Specify)											
	ered Shutter	<ul><li>■ Mill Slot</li><li>□ Key Puncl</li></ul>					inea Hoies one (Open Ho		• • • • • • • • • • • • • • • • • • • •		
									ft to	. Α	
SCREEN-PERFORATED INTERVALS: From .7.0 ft. to .17.0 ft., From ft. to ft., From ft. to ft. GRAVEL PACK INTERVALS: From 5.0 ft. to 17.0 ft., From ft. to ft. ft. ft. ft. ft. ft. ft. ft. ft.											
				Cement grout B							
Grout Interv	als: From	1 ft to	5.0	ft., From 0	ft to	1	ft From	ft to	ft	,	
Nearest sou	rce of possib	le contaminati	on:	, 1 10			,				
☐ Septic			Lateral Line			□ L	ivestock Pen	insecti ☐ Insecti	icide Storage	;	
☐ Sewer			Cess Pool	☐ Sewage L	agoon		uel Storage		loned Water		
	ight Sewer L		Seepage Pit			☐ F	ertilizer Stora	ige 🔲 Oil Wo	ell/Gas Well		
Other (	(Specify) .cc	intaminated s	site								
10 FROM	TO TO		JTHOLO	Distance from v						C INTERVALE	
0	2	Gravel fil, as		GIC LUG	FRO	(VI	10 1	ITHO. LOG (cont.) o	PLUGGIN	GINTERVALS	
2	6	Clay, brown,		rm moiet	1						
6	7	Silt, brown, v		in, moisi							
7	14			ine to medium,						····	
			V DIOWII, 1	ine to medium,		_				·····	
14	17	moist	, brown 6	ing to madium wa							
14	'	Sanu, yenow	v DIOWII, I	ine to medium, we	Notes						
					Notes	٠.					
					$\dashv$						
11 CONTRACTOR'S OR LANDOWNER'S CERTIFICATION: This water well was constructed, reconstructed, or plugged											
under my jurisdiction and was completed on (mo-day-year) .4/28/2021 and this record is true to the best of my knowledge and belief.  Kansas Water Well Contractor's License No. 604 This Water Well Record was completed on (mo-day-year)5											
Kansas Wa	iter Well Co	ntractor's Lic	ense No.	604 This W	ater Well	Reco	ord was com	pleted on (mo-day-y	/ear) <b>5</b> .	29/21	
under the b	ousiness nan	ne of Environ	rmental P	riority Service, Inc.		Sigi	nature	u mc			
				ch constructed well to: Ka							
				66612-1367. Mail one to				e tor your records. Telep			
Visit us at hit	p: www.kdhel	s.gov waterwell/i	index.html		KSA 82	<u>a-121</u>	4		<u> </u>	17/10/2015	

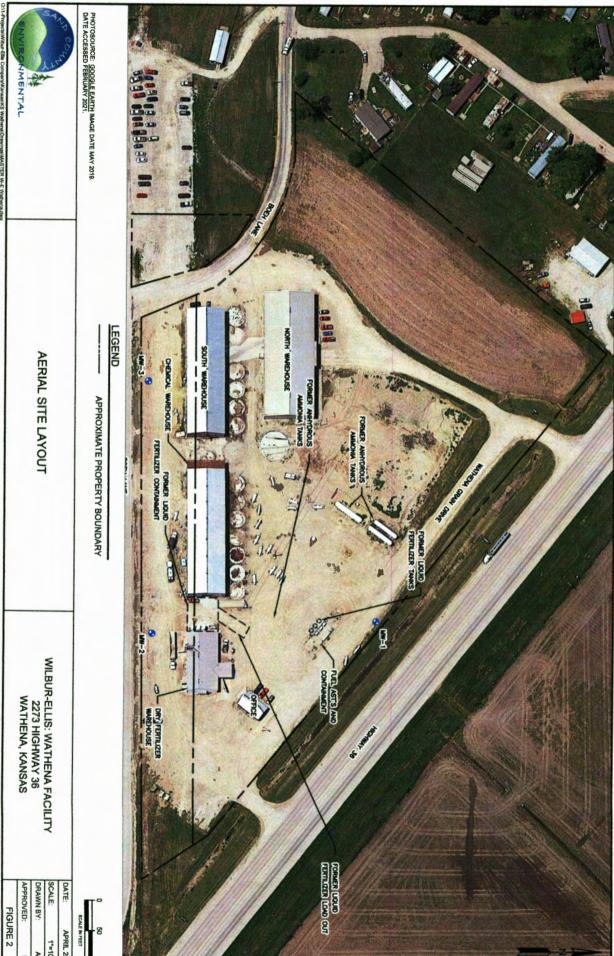

ST. NOVELO.	ABBBOVED.	DRAWN BY:	SCALE:	DATE:
100	200	ASR	1*=100	APRIL 2021