

REVISED

WATER WELL RECORD Form WWC-5


Division of Water Resources App. No.

Well ID MW5D

Original Record Correction Change in Well Use

1 LOCATION OF WATER WELL: County: POTTAWATOMIE Fraction SW 1/4 NW 1/4 SE 1/4 NE 1/4 Section Number 29 Township Number T 6 S Range Number R 10 E W

2 WELL OWNER: Last Name: Business: KDHE-BER Address: 1000 SW JACKSON City: TOPEKA State: KS ZIP: 66612 Street or Rural Address where well is located: CENTER AND MAIN, WHEATON KS

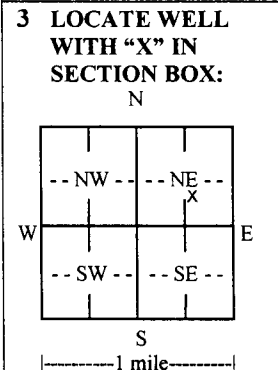

3 LOCATE WELL WITH 'X' IN SECTION BOX: 4 DEPTH OF COMPLETED WELL: 75 ft. Depth(s) Groundwater Encountered: 1) 60 ft. 2) ft. 3) ft. or 4) Dry Well WELL'S STATIC WATER LEVEL: 57.34 ft. below land surface, measured on (mo-day-yr) 11/21/18

5 Latitude: 39.50247 (decimal degrees) Longitude: 96.31815 (decimal degrees) Horizontal Datum: WGS 84 NAD 83 NAD 27 Source for Latitude/Longitude: GPS (unit make/model) (WAAS enabled? Yes No) Land Survey Topographic Map Online Mapper: 6 Elevation: 1508.03 ft. Ground Level TOC Source: Land Survey GPS Topographic Map Other

7 WELL WATER TO BE USED AS: 1. Domestic: Household Lawn & Garden Livestock Irrigation Feedlot Industrial 5. Public Water Supply: well ID 6. Dewatering: how many wells? 7. Aquifer Recharge: well ID 8. Monitoring: well ID MW5D 9. Environmental Remediation: well ID Air Sparge Soil Vapor Extraction Recovery Injection 10. Oil Field Water Supply: lease 11. Test Hole: well ID Cased Uncased Geotechnical 12. Geothermal: how many bores? a) Closed Loop Horizontal Vertical b) Open Loop Surface Discharge Inj. of Water 13. Other (specify):

Was a chemical/bacteriological sample submitted to KDHE? Yes No If yes, date sample was submitted: Water well disinfected? Yes No

8 TYPE OF CASING USED: Steel PVC Other CASING JOINTS: Glued Clamped Welded Threaded Casing diameter 2 in. to 75 ft., Diameter in. to ft., Diameter in. to ft. Casing height above land surface in. Weight lbs./ft. Wall thickness or gauge No. TYPE OF SCREEN OR PERFORATION MATERIAL: Steel Stainless Steel Fiberglass PVC Other (Specify) SCREEN OR PERFORATION OPENINGS ARE: Continuous Slot Mill Slot Gauze Wrapped Torch Cut Drilled Holes Other (Specify) Louvered Shutter Key Punched Wire Wrapped Saw Cut None (Open Hole) SCREEN-PERFORATED INTERVALS: From 55 ft. to 75 ft., From ft. to ft., From ft. to ft. GRAVEL PACK INTERVALS: From 53 ft. to 75 ft., From ft. to ft., From ft. to ft.

9 GROUT MATERIAL: Neat cement Cement grout Bentonite Other Concrete Surface Completion 0 - 1 Grout Intervals: From 0 ft. to 1 ft., From 1 ft. to 53 ft., From ft. to ft. Nearest source of possible contamination: Septic Tank Lateral Lines Pit Privy Livestock Pens Insecticide Storage Sewer Lines Cess Pool Sewage Lagoon Fuel Storage Abandoned Water Well Watertight Sewer Lines Seepage Pit Feedyard Fertilizer Storage Oil Well/Gas Well Other (Specify) Direction from well? Distance from well? ft.

Table with columns: FROM, TO, LITHOLOGIC LOG, FROM, TO, LITHO. LOG (cont.) or PLUGGING INTERVALS. Rows: 0-1 TOPSOIL, 1-40 Silty Clay (CL), brown, 40-62 LIMESTONE, 62-75 REDDISH SHALE

Notes: KDHE # 44-075-14975

11 CONTRACTOR'S OR LANDOWNER'S CERTIFICATION: This water well was constructed, reconstructed, or plugged under my jurisdiction and was completed on (mo-day-year) 11/20/18 and this record is true to the best of my knowledge and belief. Kansas Water Well Contractor's License No. 585 This Water Well Record was completed on (mo-day-year) 12/14/18 under the business name of ASSOCIATED ENVIRONMENTAL INC. Signature




SE NW SE NE
NW NW SE NE

RESIDENTIAL

NORTH ST

RESIDENTIAL

RESIDENTIAL

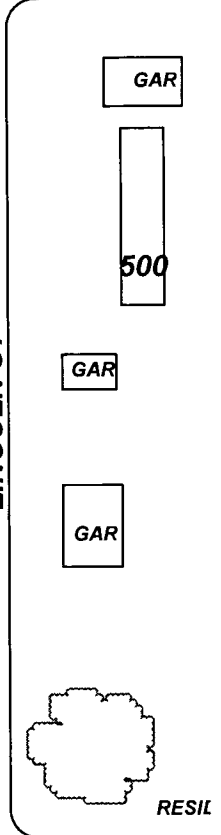
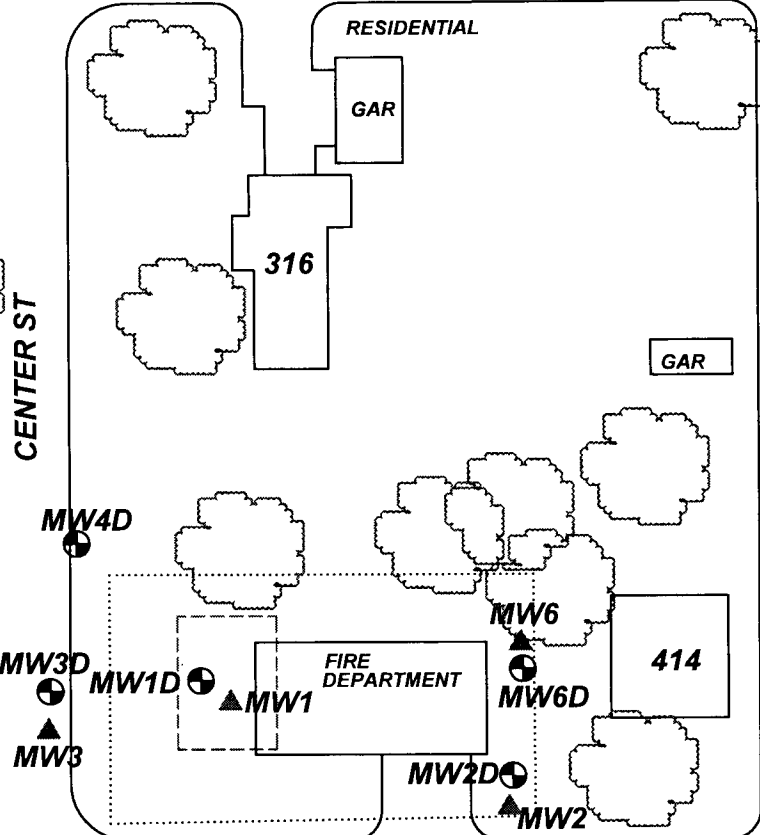
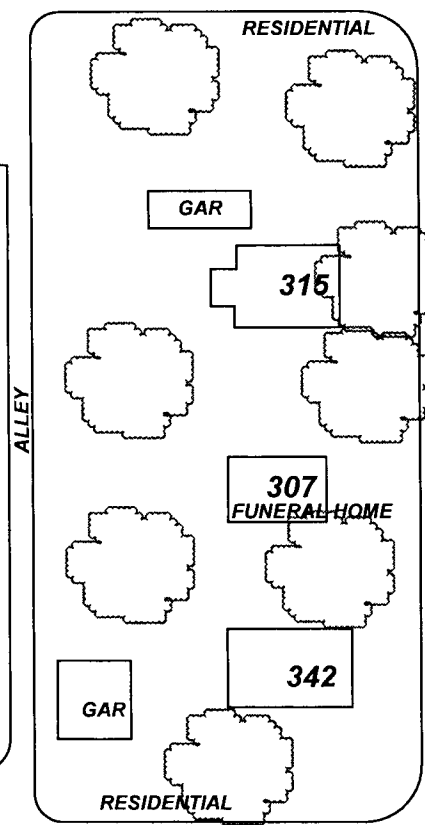


MAIN ST

COMMERCIAL

MA

RESIDEN

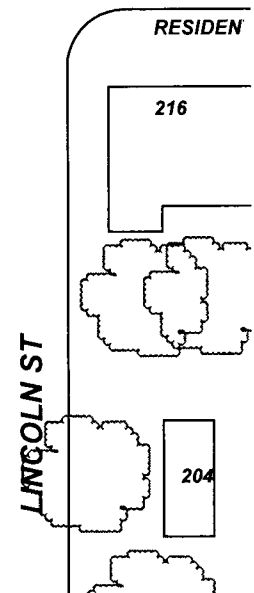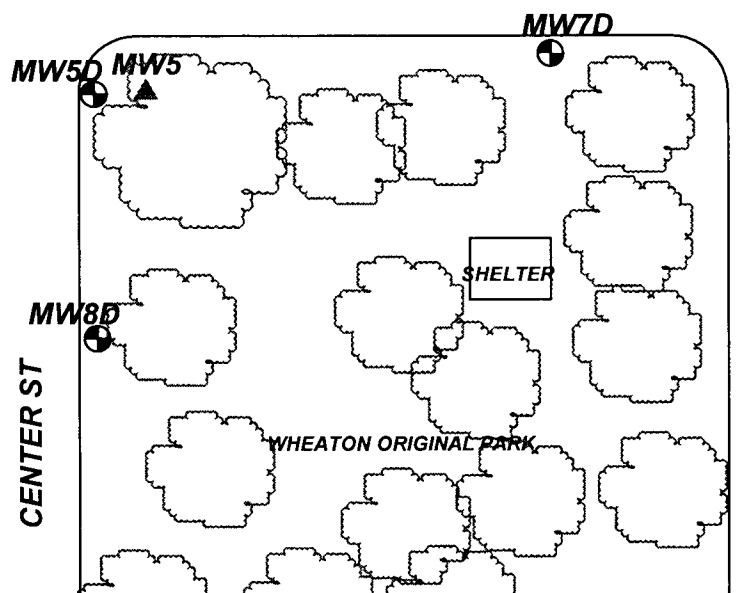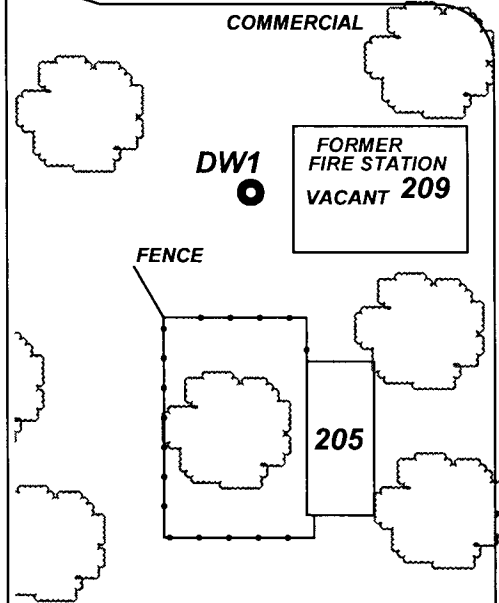

PROJECT: **NEW WHEATON FIRE STATION**

TITLE:


ADDRESS: **MAIN ST & CENTER ST**

LOCATION: **WHEATON, KS**

DRAWN BY: **B. STALNAKER** DATE: **2/6/18**

REVISED BY: **B. STALNAKER** DATE: **1/8/19**


AET JOB # **TM226** KDHE JOB # **U4-075-14975**

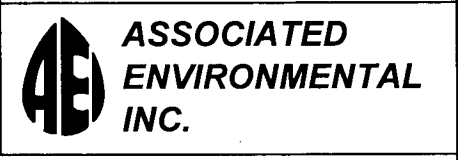

LEGEND:

- = FORMER UST BASIN/EXCAVATION
- = MONITORING WELL
- = PRIVATE WELL
- = PLUGGED/DESTROYED WELL

..... = SUBJECT PROPERTY

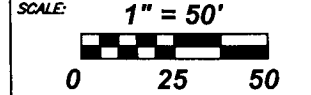

NOTES:
No basements observed within 500'.