

WATER WELL RECORD Form WWC-5

Original Record Correction Change in Well Use

Division of Water Resources App. No.

[Blank Box]

Well ID

revised

MW7D

1 LOCATION OF WATER WELL: County: POTTAWATOMIE Fraction SE 1/4 NW 1/4 SE 1/4 NE 1/4 Section Number 29 Township Number T 6 S Range Number R 10 E W

2 WELL OWNER: Last Name: KDHE-BER Business: KDHE-BER Address: 1000 SW JACKSON City: TOPEKA State: KS ZIP: 66612 Street or Rural Address where well is located: CENTER AND MAIN, WHEATON KS

3 LOCATE WELL WITH "X" IN SECTION BOX: [Diagram showing a 36-acre section with an 'X' in the NE corner]

4 DEPTH OF COMPLETED WELL: 75 ft. Depth(s) Groundwater Encountered: 1) 60 ft. 2) ... 3) ... 4) Dry Well WELL'S STATIC WATER LEVEL: 55.93 ft. below land surface, measured on (mo-day-yr) 11/21/18

5 Latitude: 39.50253 Longitude: 96.31747 Horizontal Datum: WGS 84 Source for Latitude/Longitude: Land Survey Topographic Map

6 Elevation: 1512.82 ft. Ground Level TOC Source: Land Survey GPS Topographic Map Other

7 WELL WATER TO BE USED AS: 1. Domestic: Household, Lawn & Garden, Livestock, Irrigation, Feedlot, Industrial 2. Public Water Supply: well ID 3. Dewatering: how many wells? 4. Aquifer Recharge: well ID 5. Monitoring: well ID MW7D 6. Environmental Remediation: well ID Air Sparge, Soil Vapor Extraction, Recovery, Injection 7. Oil Field Water Supply: lease 8. Test Hole: well ID Cased, Uncased, Geotechnical 9. Geothermal: how many bores? a) Closed Loop Horizontal Vertical b) Open Loop Surface Discharge Inj. of Water 10. Other (specify):

Was a chemical/bacteriological sample submitted to KDHE? No If yes, date sample was submitted: Water well disinfected? No

8 TYPE OF CASING USED: Steel PVC Other CASING JOINTS: Glued Clamped Welded Threaded Casing diameter 2 in. to 75 ft. Diameter in. to ft. Casing height above land surface in. Weight lbs./ft. Wall thickness or gauge No. TYPE OF SCREEN OR PERFORATION MATERIAL: Steel Stainless Steel Fiberglass PVC Other (Specify) SCREEN OR PERFORATION OPENINGS ARE: Continuous Slot Mill Slot Gauze Wrapped Torch Cut Drilled Holes Other (Specify) Louvered Shutter Key Punched Wire Wrapped Saw Cut None (Open Hole) SCREEN-PERFORATED INTERVALS: From 55 ft. to 75 ft. GRAVEL PACK INTERVALS: From 53 ft. to 75 ft.

9 GROUT MATERIAL: Neat cement Cement grout Bentonite Other Concrete Surface Completion 0 - 1 Grout Intervals: From 0 ft. to 1 ft. From 1 ft. to 53 ft. From 53 ft. to ft. Nearest source of possible contamination: Septic Tank Lateral Lines Pit Privy Livestock Pens Insecticide Storage Sewer Lines Cess Pool Sewage Lagoon Fuel Storage Abandoned Water Well Watertight Sewer Lines Seepage Pit Feedyard Fertilizer Storage Oil Well/Gas Well Other (Specify) Direction from well? Distance from well? ft.

Table with 6 columns: 10 FROM, TO, LITHOLOGIC LOG, FROM, TO, LITHO. LOG (cont.) or PLUGGING INTERVALS. Rows: 0-1 TOPSOIL, 1-40 Silty Clay (CL), brown, 40-62 LIMESTONE, 62-75 REDDISH SHALE. Notes: KDHE # U4-075-149-15

11 CONTRACTOR'S OR LANDOWNER'S CERTIFICATION: This water well was constructed, reconstructed, or plugged under my jurisdiction and was completed on (mo-day-year) 11/20/18 and this record is true to the best of my knowledge and belief. Kansas Water Well Contractor's License No. 585 This Water Well Record was completed on (mo-day-year) 12/14/18 under the business name of ASSOCIATED ENVIRONMENTAL INC. Signature


SE NW SE NE
NW NW SE NE

RESIDENTIAL


NORTH ST

RESIDENTIAL


RESIDENTIAL

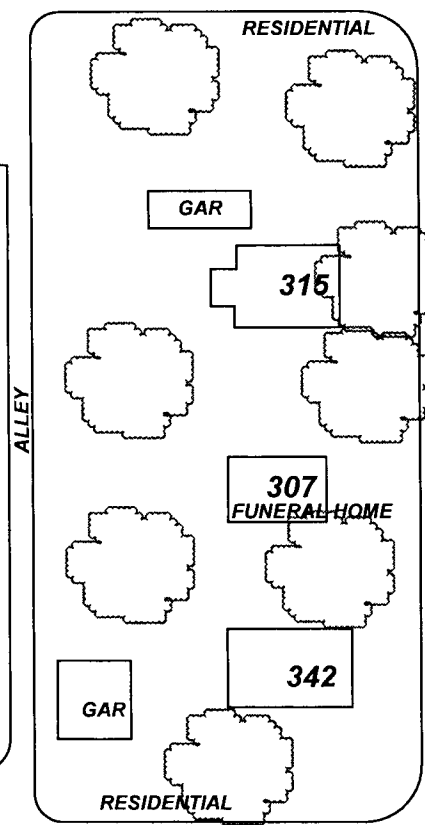

CENTER ST


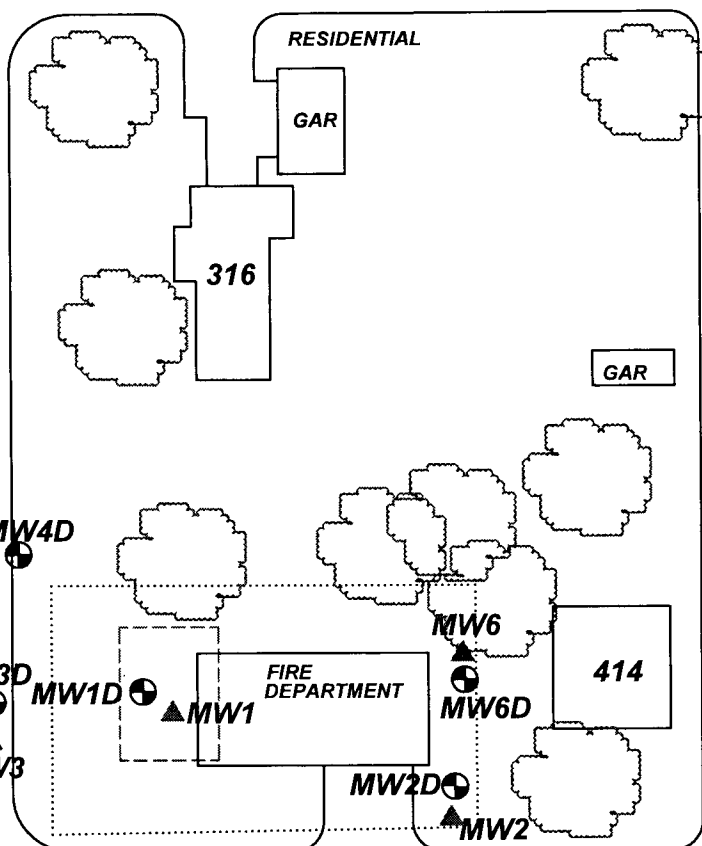


LINCOLN ST

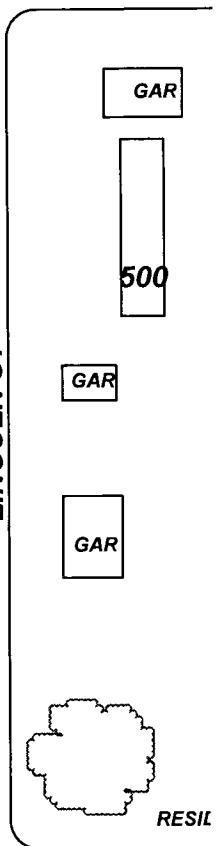


MAIN ST

COMMERCIAL

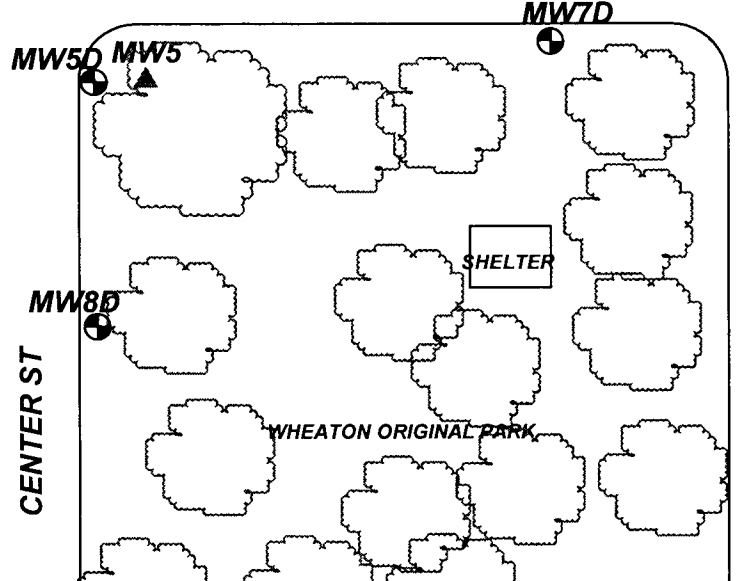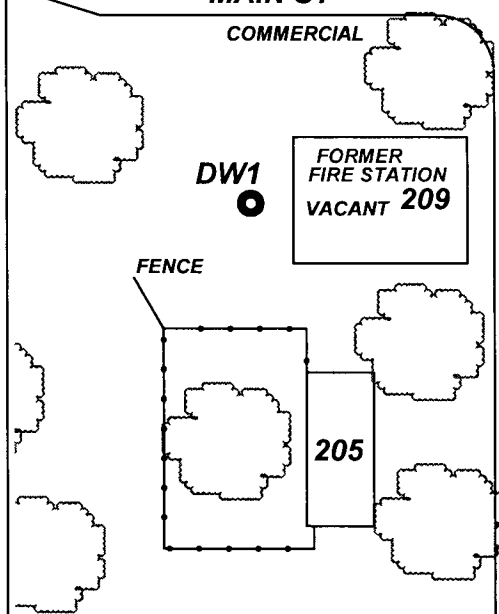

LINCOLN ST

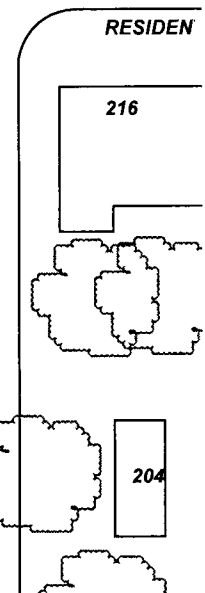

PROJECT: **NEW WHEATON FIRE STATION**

TITLE:


ADDRESS: **MAIN ST & CENTER ST**

LOCATION: **WHEATON, KS**

DRAWN BY: **B. STALNAKER** DATE: **2/6/18**

REVISED BY: **B. STALNAKER** DATE: **1/8/19**


AET JOB # **TM226** KDHE JOB # **U4-075-14975**

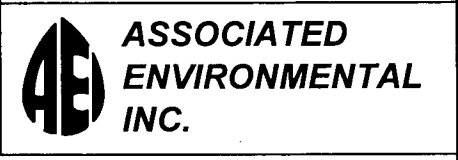

LEGEND:

- = FORMER UST BASIN/EXCAVATION
- = MONITORING WELL
- = PRIVATE WELL
- = PLUGGED/DESTROYED WELL

..... = SUBJECT PROPERTY

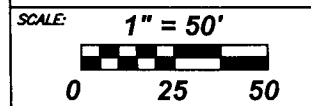

NOTES:
No basements observed within 500'.

