

WATER WELL RECORD Form WWC-5

Division of Water Resources App. No.

Well ID MW6

Original Record Correction Change in Well Use

1 LOCATION OF WATER WELL: County: POTTAWATOMIE Fraction NW 1/4 NW 1/4 SE 1/4 NE 1/4 Section Number 34 Township Number T 06 S Range Number R 11 E W

2 WELL OWNER: Last Name: Business: MIDWEST KANSAS CO-OP ASSOCIATION Address: PO BOX 1045 City: MANHATTAN State: KS ZIP: 66502 Street or Rural Address where well is located: 104 LEONARD ST., ONAGA, KS

3 LOCATE WELL WITH 'X' IN SECTION BOX: N W E S 1 mile

4 DEPTH OF COMPLETED WELL: 15 ft. Depth(s) Groundwater Encountered: 1) 8 ft. 2) 4 ft. 3) 17 ft. WELL'S STATIC WATER LEVEL: 4.17 ft. below land surface, measured on (mo-day-yr) 8/10/17

5 Latitude: 39.48826 Longitude: 96.16979 Horizontal Datum: WGS 84 NAD 83 NAD 27 Source for Latitude/Longitude: GPS (unit make/model) Land Survey Topographic Map Online Mapper

7 WELL WATER TO BE USED AS: 1. Domestic: Household Lawn & Garden Livestock Irrigation Feedlot Industrial 5. Public Water Supply: well ID 6. Dewatering: how many wells? 7. Aquifer Recharge: well ID 8. Monitoring: well ID MW6 9. Environmental Remediation: well ID Air Sparge Soil Vapor Extraction Recovery Injection 10. Oil Field Water Supply: lease 11. Test Hole: well ID Cased Uncased Geotechnical 12. Geothermal: how many bores? a) Closed Loop Horizontal Vertical b) Open Loop Surface Discharge Inj. of Water 13. Other (specify):


Was a chemical/bacteriological sample submitted to KDHE? Yes No If yes, date sample was submitted: Water well disinfected? Yes No

8 TYPE OF CASING USED: Steel PVC Other CASING JOINTS: Glued Clamped Welded Threaded Casing diameter 2 in. to 15 ft., Diameter in. to ft., Diameter in. to ft. Casing height above land surface in. Weight lbs./ft. Wall thickness or gauge No. TYPE OF SCREEN OR PERFORATION MATERIAL: Steel Stainless Steel Fiberglass PVC Brass Galvanized Steel Concrete tile None used (open hole) SCREEN OR PERFORATION OPENINGS ARE: Continuous Slot Mill Slot Gauze Wrapped Torch Cut Drilled Holes Other (Specify) Louvered Shutter Key Punched Wire Wrapped Saw Cut None (Open Hole) SCREEN-PERFORATED INTERVALS: From 5 ft. to 15 ft., From ft. to ft., From ft. to ft. GRAVEL PACK INTERVALS: From 4 ft. to 15 ft., From ft. to ft., From ft. to ft.

9 GROUT MATERIAL: Neat cement Cement grout Bentonite Other Concrete Surface Completion 0 - 0.85 Grout Intervals: From 0 ft. to 85 ft., From 85 ft. to 4 ft., From ft. to ft. Nearest source of possible contamination: Septic Tank Lateral Lines Pit Privy Livestock Pens Insecticide Storage Sewer Lines Cess Pool Sewage Lagoon Fuel Storage Abandoned Water Well Watertight Sewer Lines Seepage Pit Feedyard Fertilizer Storage Oil Well/Gas Well Other (Specify) Direction from well? Distance from well? ft.

Table with 6 columns: 10 FROM, TO, LITHOLOGIC LOG, FROM, TO, LITHO. LOG (cont.) or PLUGGING INTERVALS. Rows: 0 to .25 GRAVEL, .25 to 15 SILTY CLAY, Notes:

11 CONTRACTOR'S OR LANDOWNER'S CERTIFICATION: This water well was constructed, reconstructed, or plugged under my jurisdiction and was completed on (mo-day-year) 7/31/17 and this record is true to the best of my knowledge and belief. Kansas Water Well Contractor's License No. 585 This Water Well Record was completed on (mo-day-year) 8/30/17 under the business name of ASSOCIATED ENVIRONMENTAL INC. Signature

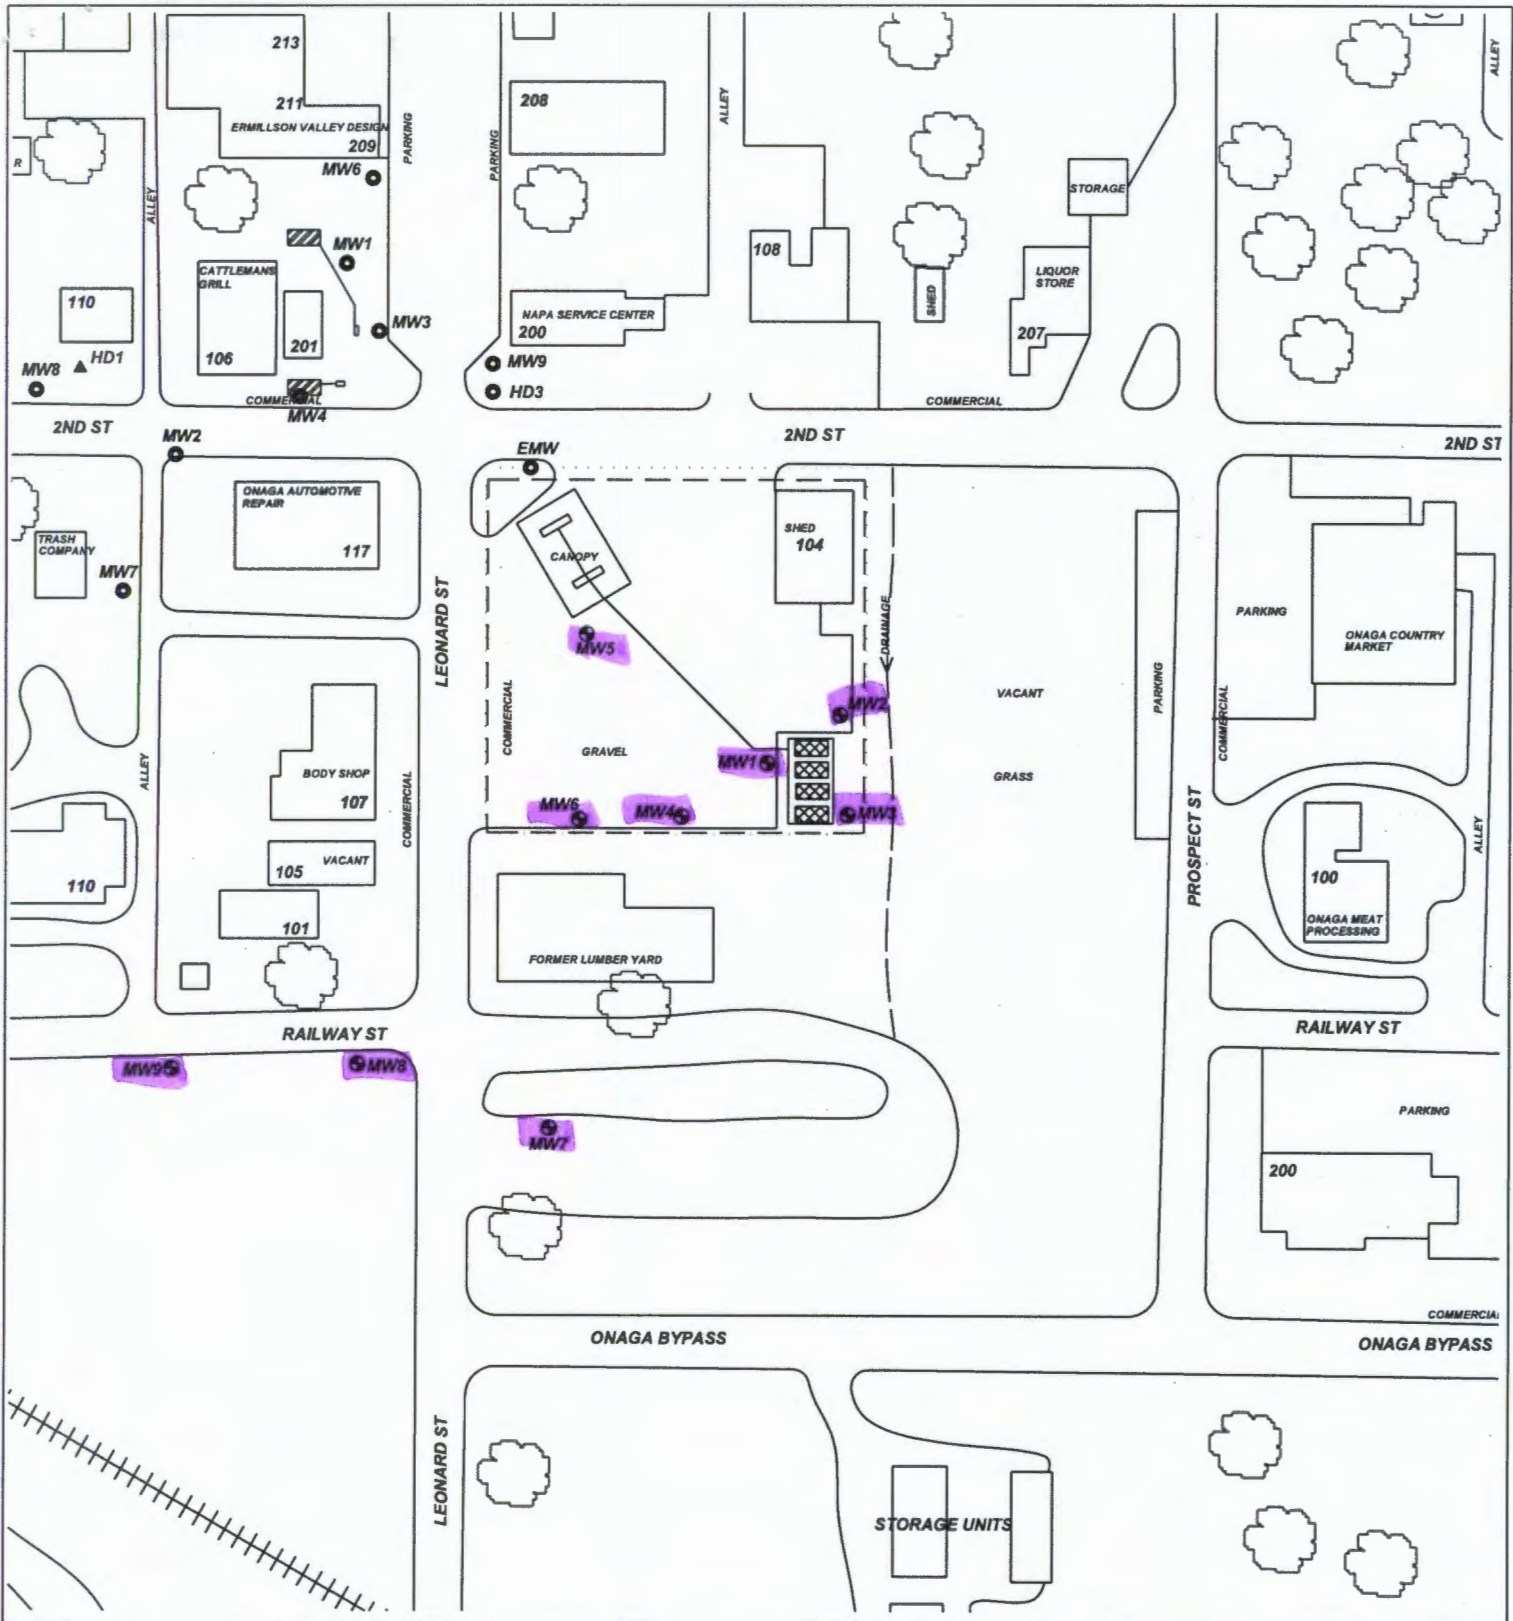

PROJECT: **MKC**

ADDRESS: **104 LEONARD ST.**

LOCATION: **ONAGA, KS**

DRAWN BY: **B. STALNAKER** DATE: **4/11/17**

REVISED BY: **C. ROE** DATE: **8/2/17**


AEI JOB #: **TF503** KDHE JOB #: **A4-075-40470**

TITLE:

**ASSOCIATED ENVIRONMENTAL INC.**

LEGEND:

- = ABOVE GROUND STORAGE TANK
- = MONITOR WELL
- = EXISTING MONITOR WELL
- = PLUGGED/DESTROYED WELL
- = PUMP ISLAND AND PRODUCT LINES
- = OBSERVED BASEMENT
- = SUBJECT PROPERTY

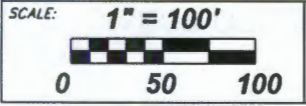

NOTES: