

WATER WELL RECORD Form WWC-5

Division of Water Resources App. No.

MW11

Original Record Correction Change in Well Use

Well ID

1 LOCATION OF WATER WELL: County: ATCHISON Fraction NW 1/4 SW 1/4 NE 1/4 NW 1/4 Section Number 6 Township Number T 6 S Range Number R 21 E W
2 WELL OWNER: Last Name: Business: KDHE-BER Address: 1000 SW JACKSON City: TOPEKA State: KS ZIP: 66612-1367 Street or Rural Address where well is located...
3 LOCATE WELL WITH "X" IN SECTION BOX: Diagram showing well location in a section box.
4 DEPTH OF COMPLETED WELL: 20 ft. Depth(s) Groundwater Encountered: 1) 15 ft. 2) ... ft. 3) ... ft., or 4) Dry Well WELL'S STATIC WATER LEVEL: 10.01 ft.
5 Latitude: 39.56114 Longitude: 95.11790 Horizontal Datum: WGS 84
6 Elevation: 799.88 ft. Source: Land Survey GPS Topographic Map Other

7 WELL WATER TO BE USED AS: 1. Domestic: Household Lawn & Garden Livestock 2. Irrigation 3. Feedlot 4. Industrial 5. Public Water Supply: well ID 6. Dewatering: how many wells? 7. Aquifer Recharge: well ID 8. Monitoring: well ID MW11 9. Environmental Remediation: well ID Air Sparge Soil Vapor Extraction Recovery Injection 10. Oil Field Water Supply: lease 11. Test Hole: well ID Cased Uncased Geotechnical 12. Geothermal: how many bores? a) Closed Loop Horizontal Vertical b) Open Loop Surface Discharge Inj. of Water 13. Other (specify):

Was a chemical/bacteriological sample submitted to KDHE? Yes No If yes, date sample was submitted: Water well disinfected? Yes No


8 TYPE OF CASING USED: Steel PVC Other CASING JOINTS: Glued Clamped Welded Threaded Casing diameter 2 in. to 20 ft., Diameter in. to ft., Diameter in. to ft. Casing height above land surface in. Weight lbs./ft. Wall thickness or gauge No. SCH. 40 TYPE OF SCREEN OR PERFORATION MATERIAL: Steel Stainless Steel Fiberglass PVC Other (Specify) SCREEN OR PERFORATION OPENINGS ARE: Continuous Slot Mill Slot Gauze Wrapped Torch Cut Drilled Holes Other (Specify) Louvered Shutter Key Punched Wire Wrapped Saw Cut None (Open Hole) SCREEN-PERFORATED INTERVALS: From 10 ft. to 20 ft., From ft. to ft., From ft. to ft. GRAVEL PACK INTERVALS: From 8 ft. to 20 ft., From ft. to ft., From ft. to ft.

9 GROUT MATERIAL: Neat cement Cement grout Bentonite Other Concrete Surface Completion 0-1 Grout Intervals: From 0 ft. to 1 ft., From 1 ft. to 8 ft., From ft. to ft. Nearest source of possible contamination: Septic Tank Lateral Lines Pit Privy Livestock Pens Insecticide Storage Sewer Lines Cess Pool Sewage Lagoon Fuel Storage Abandoned Water Well Watertight Sewer Lines Seepage Pit Feedyard Fertilizer Storage Oil Well/Gas Well Other (Specify) Direction from well? SOUTHWEST Distance from well? 130 ft.

Table with columns: FROM, TO, LITHOLOGIC LOG, FROM, TO, LITHO. LOG (cont.) or PLUGGING INTERVALS. Row 1: 0 to .5 ASPHALT. Row 2: .5 to 20 SILTY CLAY. Notes: U4-003-14887

11 CONTRACTOR'S OR LANDOWNER'S CERTIFICATION: This water well was constructed, reconstructed, or plugged under my jurisdiction and was completed on (mo-day-year) 8/26/19 and this record is true to the best of my knowledge and belief. Kansas Water Well Contractor's License No. 585 This Water Well Record was completed on (mo-day-year) 9/17/19 under the business name of ASSOCIATED ENVIRONMENTAL INC. Signature

ATCHISON NW NE NW SEC 6 T6 K21E

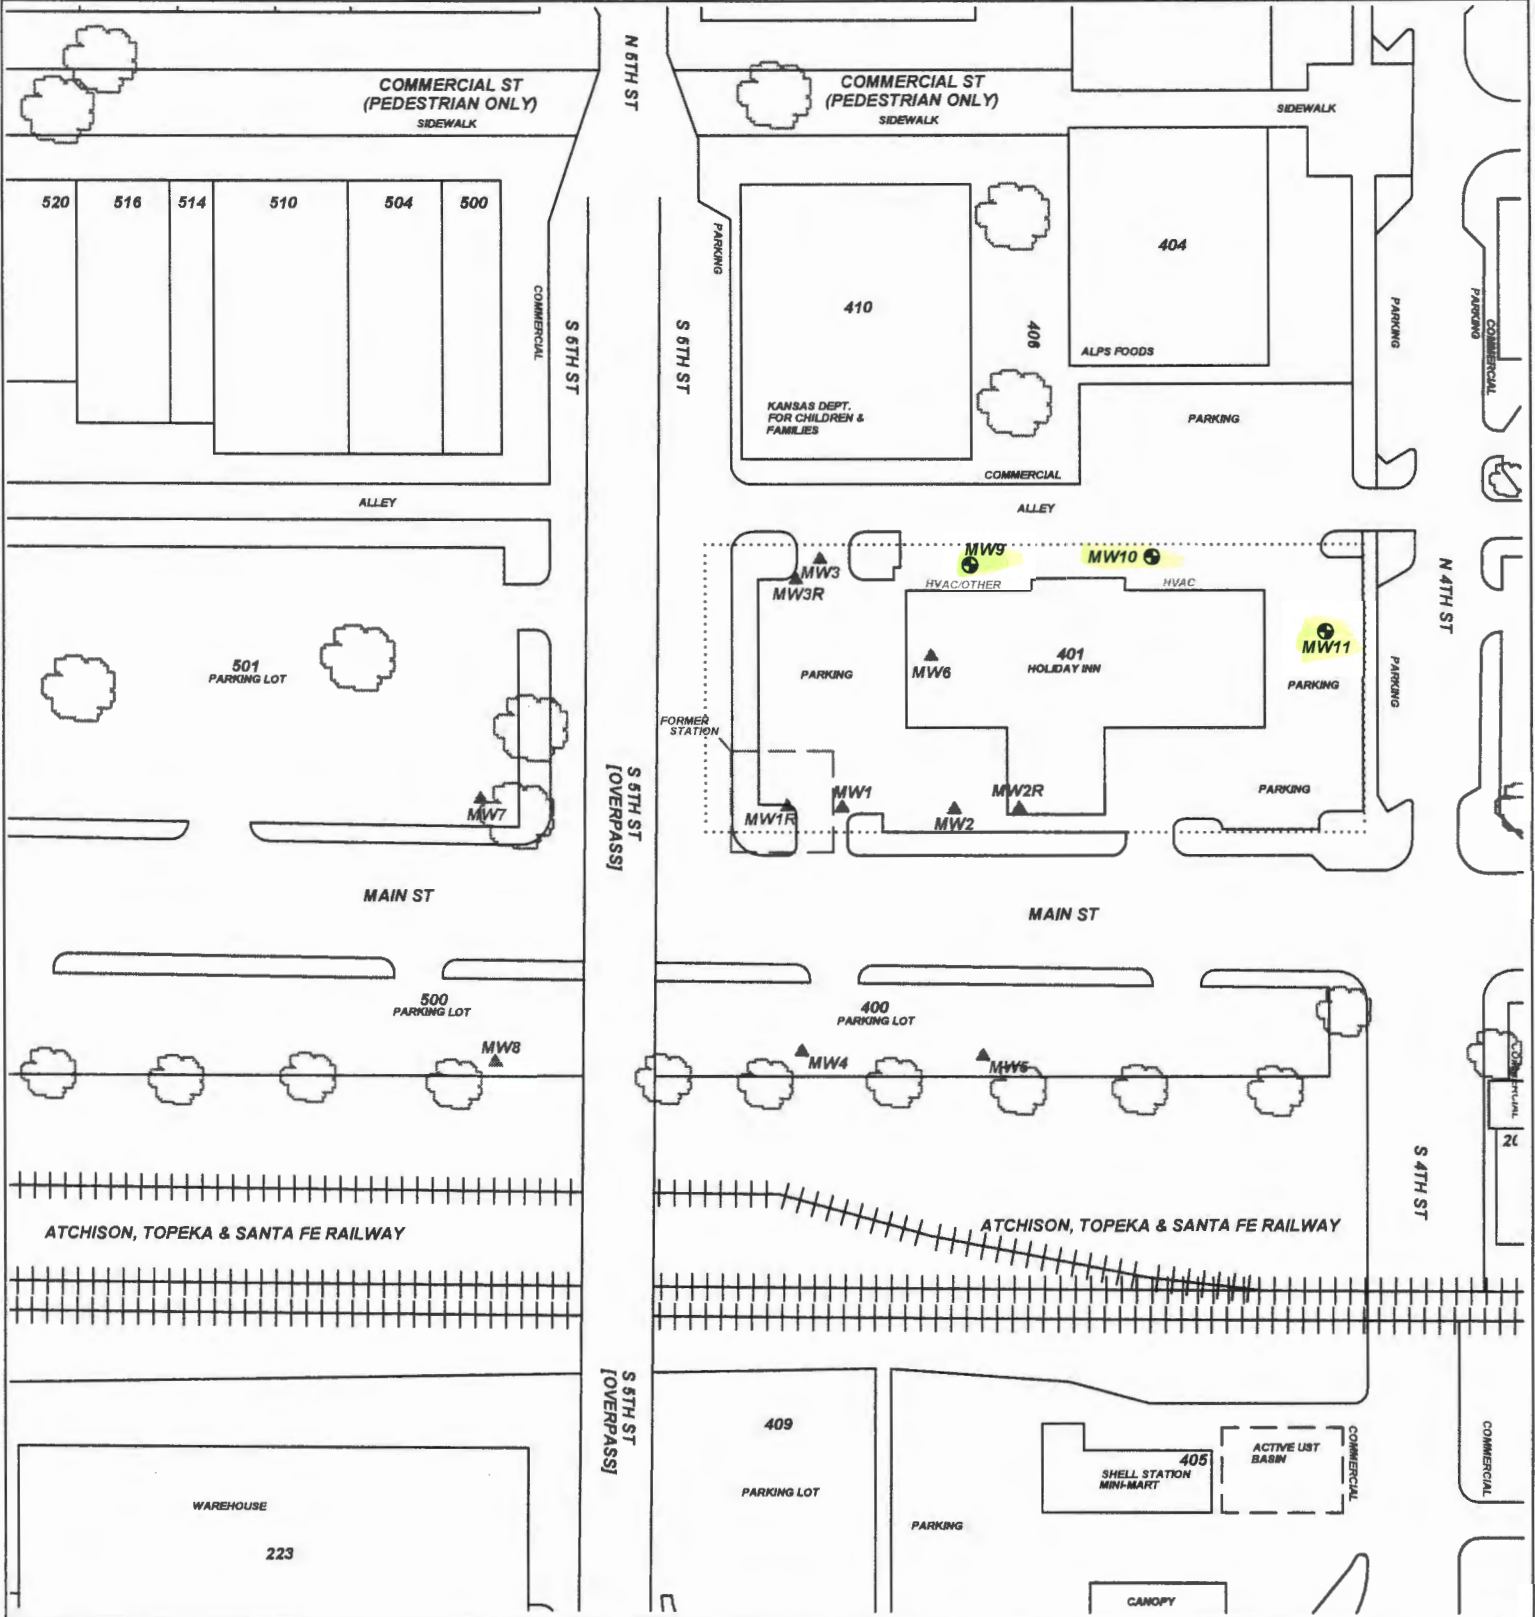

PROJECT: 401 MAIN STREET, ATCHISON  
 ADDRESS: 401 MAIN STREET  
 LOCATION: ATCHISON, KS  
 DRAWN BY: B. SCOTT DATE: 3/25/16  
 REVISED BY: B. STALNAKER DATE: 9/16/19  
 AEI JOB #: TM204 KDHE JOB #: U4-003-14887  
 SCALE: 1" = 100'  
 0 50 100

TITLE:  
 ASSOCIATED ENVIRONMENTAL INC.  
 NOTES:

LEGEND:  
 [Dashed Box] = FORMER FILLING STATION  
 [Circle with Plus] = MONITOR WELL  
 [Triangle] = PLUGGED MONITOR WELL  
 [Dotted Line] = SUBJECT PROPERTY