

WATER WELL RECORD

Form WWC-5

Division of Water Resources App. No.

[Empty box]


Well ID

MW9

[X] Original Record [] Correction [] Change in Well Ust

1 LOCATION OF WATER WELL: County Leavenworth Fraction SW 1/4 NW 1/4 NE 1/4 NE 1/4 Section Number 35 Township Number T 8 S Range Number R 22 [X] E [] W

2 WELL OWNER: Last Name: Business: Storage Box, Inc. (Louis Klemp) Address: 1314 Eisenhower Rd. Leavenworth, KS 66048 City Knoxville State TN ZIP: 37909 Street or Rural Address where well is located (if unknown, distance and direction from nearest town or intersection): 804 Cherokee, Leavenworth, KS

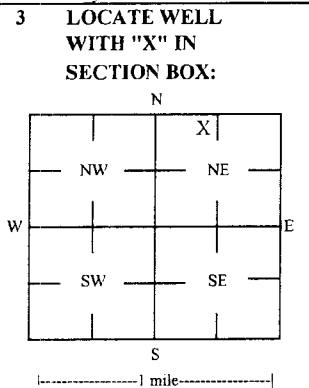

4 DEPTH OF COMPLETED WELL: 19.5 ft Depth(s) Groundwater Encountered: 1) ... 2) ... 3) ... 4) [] Dry Well WELL'S STATIC WATER LEVEL: NA ft. [] below land surface, measured on (mo-day-yr) [] above land surface, measured on (mo-day-yr) Pump test data: Well water was ... after ... hours pumping ... gpm Water well was ... ft after ... hours pumping ... gpm Estimated Yield: ... gpm Bore Hole Diameter: 7.25 in to ... ft, and ... in to ... ft

5 Latitude: 39.31599 (decimal degrees) Longitude: 94.92288 (decimal degrees) Horizontal Datum: [X] WGS 84 [] NAD 83 [] NAD 27 Source for Latitude/Longitude: [] GPS (unit make/model:) (WAAS enabled? [] Yes [] No) [X] Land Survey [] Topographic Map [] Online Mapper

6 Elevation: 794.63 ft [] Ground Level [X] TOC Source: [X] Land Survey [] GPS [] Topographic Map [] Other

7 WELL WATER TO BE USED AS: 1 Domestic: [] Household [] Lawn & Garden [] Livestock [] Irrigation [] Feedlot [] Industrial 2 Public Water Supply: well ID 3 Dewatering: how many wells? 4 Aquifer Recharge: well ID 5 Monitoring: well ID MW9 6 Environmental Remediation: well ID 7 Air Sparge [] Soil Vapor Extractor 8 Recovery [] Injection 9 Oil Field Water Supply: lease 10 Test Hole: well ID [] Cased [] Uncased [] Geotechnical 11 Geothermal: How many bores? a) Closed Loop [] Horizontal [] Vertical b) Open Loop [] Surface Discharge [] Inj. of Water [] Other (specify):

Was a chemical/bacteriological sample submitted to KDHE? [] Yes [X] No If yes, date sample was submitted: Water well disinfected? [] Yes [X] No

8 TYPE OF CASING USED: [] Steel [X] PVC [] Other CASING JOINTS: [] Glued [] Clamped [] Welded [X] Threaded Casing diameter 2 in. to 9.5 ft, Diameter in. to ft, Diameter in. to ft, Casing height above land surface -0.29 in. Weight lbs./ft. Well thickness or gauge No TYPE OF SCREEN OR PERFORATION MATERIAL: [] Steel [] Stainless Steel [] Fiberglass [X] PVC [] Other (Specify) [] Brass [] Galvanized Steel [] Concrete tile [] None used (open hole) SCREEN OR PERFORATION OPENINGS ARE: [] Continuous Slot [X] Mill Slot [] Gauze Wrapped [] Torch Cut [] Drilled Holes [] Other (Specify) [] Louvered Shutter [] Key Punched [] Wire Wrapped [] Saw Cut [] None (Open Hole) SCREEN-PERFORATED INTERVALS: From 9.5 ft. to 19.5 ft, From ft. to ft, From ft. to ft, GRAVEL PACK INTERVALS: From 7.5 ft. to 19.5 ft, From ft. to ft, From ft. to ft,


9 GROUT MATERIAL: [] Neat cement [] Cement grout [X] Bentonite [X] Other Concrete: 0-1 ft Grout intervals: From 1 ft. to 7.5 ft, From ft. to ft, From ft. to ft,

Nearest source of possible contamination: [] Septic Tank [] Lateral Lines [] Pit Privy [] Livestock Pens [] Insecticide Storage [] Sewer Lines [] Cess Pool [] Sewage Lagoon [X] Fuel Storage [] Abandoned Water Well [] Watertight Sewer Lines [] Seepage Pit [] Feedyard [] Fertilizer Storage [] Oil Well / Gas Well [] Other (Specify) Direction from well? N-NW Distance from well? ~105 ft

Table with 6 columns: FROM, TO, LITHOLOGIC LOG, FROM, TO, LITHO LOG (cont.) or PLUGGING INTERVALS. Rows include: 0-0.4 Gravel with silty clay, 0.4-14 Silty clay, 14-16 Gray shale, 16-17.5 Broken limestone, 17.5-19.5 Fossiliferous limestone.

Notes: KDHE ID: Pellman Oil; A4-052-40110 Target of monitoring well is shallow groundwater, <20' of grout was installed at the direction of KDHE.

11 CONTRACTOR'S OR LANDOWNER'S CERTIFICATION: This water well was [X] constructed, [] reconstructed, or [] plugged under my jurisdiction and was completed on (mo-day-year) 1/22/18 and this record is true to the best of my knowledge and belief. Kansas Water Well Contractor's License No 757 This Water Well Record was completed on (mo-day-year) 2/23/18 under the business name of Larsen & Associates, Inc. Signature

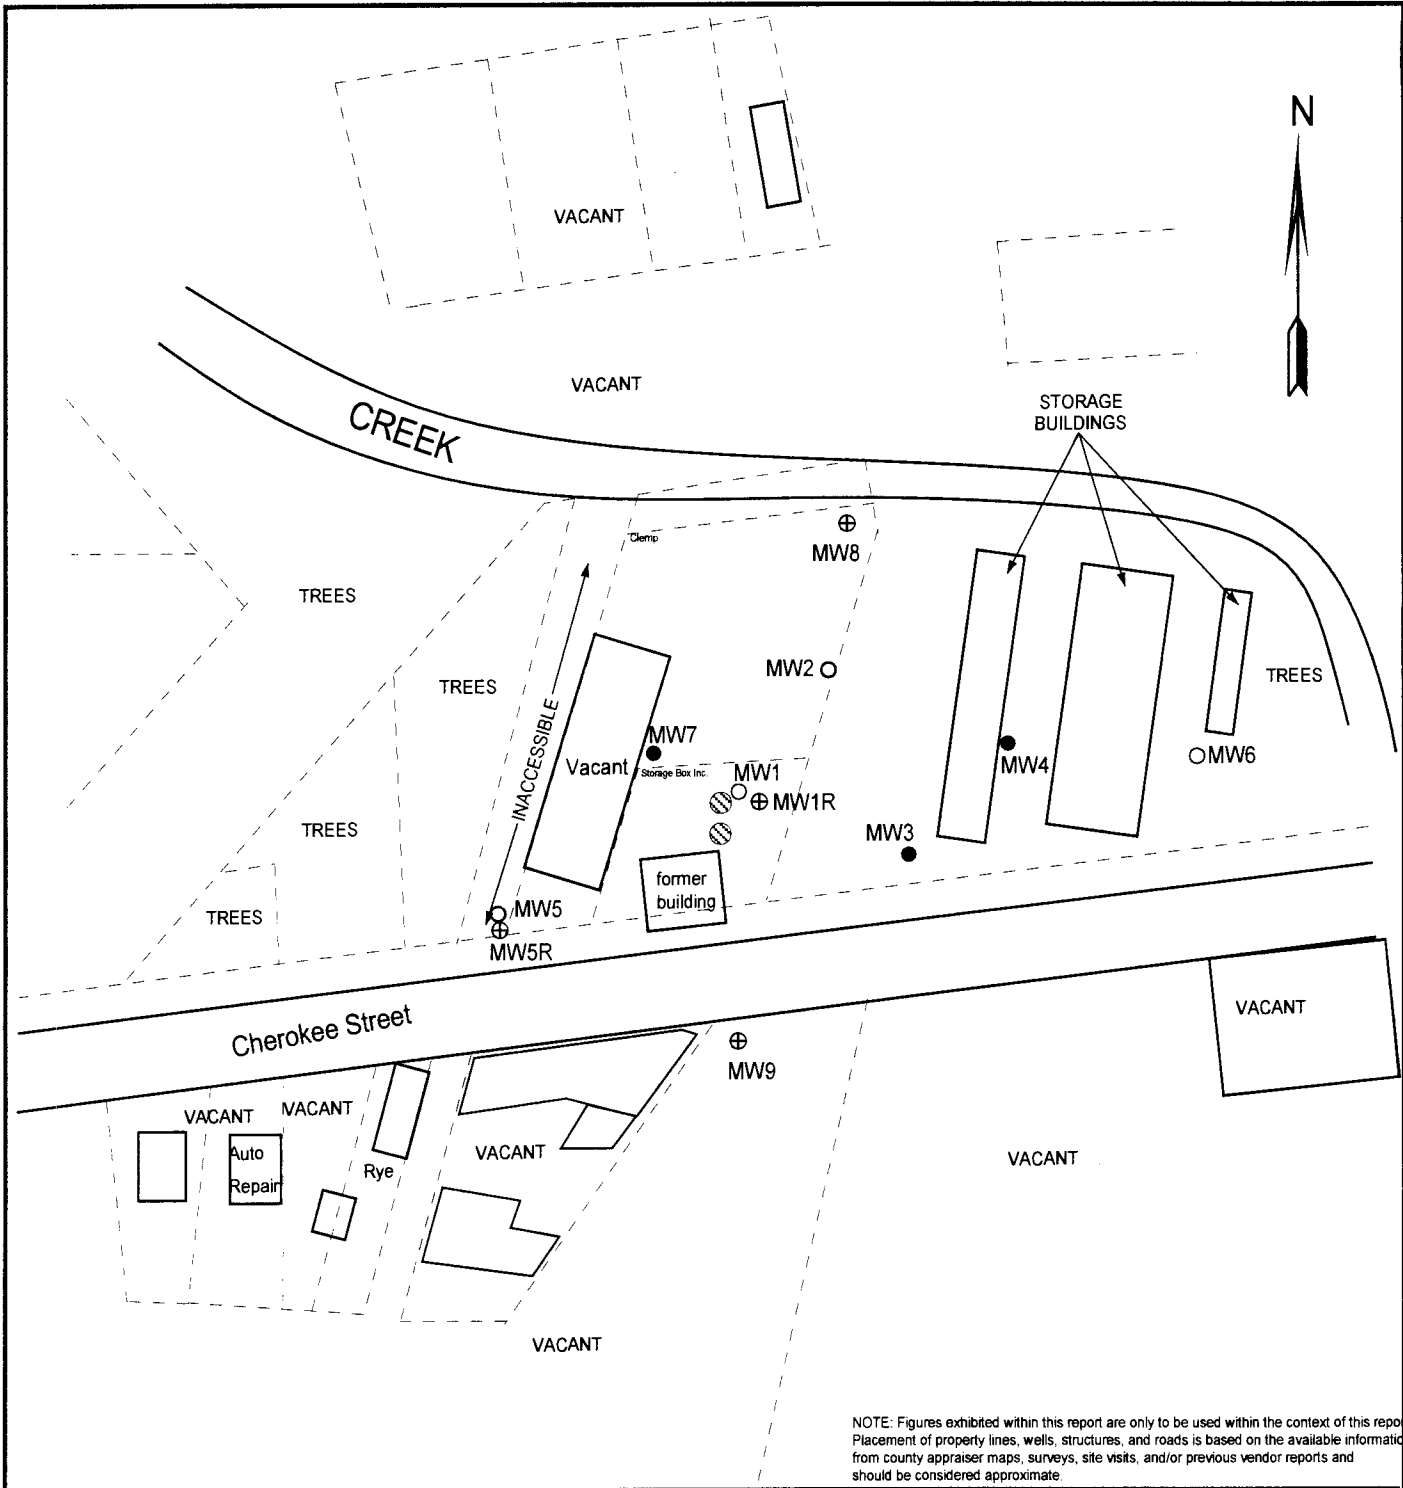

NOTE: Figures exhibited within this report are only to be used within the context of this report. Placement of property lines, wells, structures, and roads is based on the available information from county appraiser maps, surveys, site visits, and/or previous vendor reports and should be considered approximate.

FIGURE 1 - SITE BASE MAP

LEGEND:

- Former AST
- Existing Monitoring Well
- Plugged/Destroyed Monitoring Well
- Monitoring Well (Installed 1/22/18)
- Approximate location of property line



PROJECT:

Pellman Oil
800 Cherokee
Leavenworth, KS
KDHE ID: A4-052-40110
Date: 1/22/18

1311 E. 25th St. Ste. B (785) 841-8707 office
Lawrence, KS 66046 (785) 865-4282 fax



Leavenworth 80

35-8-22E

DENNIS L HANDKE

1820 NW 59th Terrace
TOPEKA, KANSAS 66618
785-286-4047 Home
785-286-1990 Fax

Jess Chapman
Larsen & Assoc.
1311 E. 25th St., Suite B
Topeka, Kansas 66046

February 16, 2018

RE: Monitor Well Elevation Survey
800 Cherokee, Leavenworth, Kansas

Proj. 18-00B
Pellman Oil
KDHE ID A4-052-40110

Bench Mark: Chisled X on top SE bolt of flag pole on East side of driveway.
Elev.: 799.80 North 4723 West 1457 (from SE Cor. Sec. 35-8-22E)

MW-1R	rim	794.46	North 4814	SW1/4,NW1/4,NE1/4,NE1/4
	top pipe	794.13	West 1264	Lat = 39.31634 Long = 94.92291
MW-5R	rim	801.04	North 4748	SE1/4,NE1/4,NW1/4,NE1/4
	top pipe	800.65	West 1403	Lat = 39.31616 Long = 94.92340
MW-8	rim	792.54	North 4921	SW1/4,NW1/4,NE1/4,NE1/4
	top pipe	792.24	West 1237	Lat = 39.31663 Long = 94.92282
MW-9	rim	794.92	North 4685	SW1/4,NW1/4,NE1/4,NE1/4
	top pipe	794.63	West 1254	Lat = 39.31599 Long = 94.92288

Lat & Long derived from Leavenworth 7.5' quad map. WGS84.

Elevation derived from existing project.

If you have any questions, please feel free to call me. Thank you for the opportunity to be of service to you.

February 17, 2018
Dennis L Handke RLS
Dennis L Handke
KANSAS
LAND SURVEYOR

RECEIVED
FEB 28 2018
BUREAU OF WATER