WATER WELL RECOR	RD Form WW	C-5		ision of Water			B # X X / 1		
X Original Record	Correction Change in \	Well Ust	Reso	urces App. No.		Well ID	MW1		
1 LOCATION OF WAT County Leavenworth	ER WELL:	Fraction NE ¼ NE ¼ NE	14 NE 1/2	I .	Township Num	1 -	Number 2 X E W		
2 WELL OWNER: Last N	Name:	First: S	treet or Rural A	Address where w	ell is located (if unk	nown, distance	and direction		
Business: KDHE (Porter Oil Co.) from nearest town or intersection): If at owner's address, check here:									
Address: 1000 SW Jacks	on St	701	Delaware St, Le	eavenworth, KS					
Address: City Topeka	State: KS	ZIP: 66612							
3 LOCATE WELL		PLETED WELL: 1:	5.5 ft	5 Latitude:	39.317	45 (de	cimal degrees)		
WITH "X" IN	Depth(s) Groundwater Er	countered: 1)	ft	Longitude		50 (de	cimal degrees)		
SECTION BOX:	2) ft 3)	ft, or 4) Dry	Well	Horizontal	Datum: WGS 8		83 X NAD 27		
N	WELL'S STATIC WATE	R LEVEL: 12.65	ft.		Latitude/Longitude	:			
		e, measured on (mo-day-yr			unit make/model:	· · · · · · · · · · · · · · · · · · ·			
NW NE	Pump test data: Well v	e, measured on (mo-day-yr) vater wasf			AAS enabled? Topogr)		
		s pumping g		_	Mapper	rupine map			
W	Wat	er well was f							
SW SE	afterhour	rs pumpingg	pm	6 Elevation		Ground L	evel X TOC		
	Estimated Yield:			Source X	Land Survey	GPS	Topographic Mar		
	Bore Hole Diameter:	7.25 in to fi	, and		Other				
S 1 mile		in to f							
7 WELL WATER TO BE I	USED AS:								
1 Domestic:	5 Public Water Supp	ly: well ID	1	0 Oil Field	Water Supply: lease				
Household	6 Dewatering: how		1	1 Test Hole: we					
Lawn & Garden	7 Aquifer Recharge:			Cased	Uncased	Geotechnic	al		
Livestock	8 X Monitoring: well I 9 Environmental Remedi		1	2 Geothermal: He					
2 Irrigation 3 Feedlot	Air Sparge	Soil Vapor Extraction		b) Open Loop	p Horizontal	Vertic scharge			
4 Industrial	Recovery	Injection		Other (spe	_	scharge	iiij. Oi watei		
Was a chemical/bacteriological		E? Yes X No	lf yes, da	ite sample was si	ıbmitted:				
	X No	7				7			
	CD: Steel X PVC	Other	CASING JO	INTS:Gh	ed Clampled [X Threaded		
Casing diameter 2 in. Casing height above land surface	-0.40 in. Wei	ghtlt	s./ft. Well	thickness or gaus	ze No				
TYPE OF SCREEN OR PERI									
Steel Stainless St	eel Fiberglass	X PVC		Other (Specify)					
Brass Galvanized	Steel Concrete tile	None used (open ho	le)						
SCREEN OR PERFORATION	_	_	_						
		Wrapped Torch C		ed Holes	Other (Specify)			
Louvered Shutter	Key Punched Wire W	rapped Saw Cut	None	e (Open Hole)	٥ . ٦		•		
SCREEN-PERFORATED INTE	RVALS: From 5.5 f	t. to 15.5 ft, From	n tt	. to	ft, From	ft. to	ft,		
	RVALS: From 3.5 f				II, FIORI	п. 10	π,		
		ent grout X Bentonite			4- 6				
Grout intervals: From 1 Nearest source of possible con	ft. to 3.5 ft, Fro	лп п. ю		π.	п,				
Septic Tank	Lateral Lines	Pit Privy	l ive	stock Pens	Insecticide	Storage			
Sewer Lines	Cess Pool	Sewage Lagoon		Storage	=	Water Well			
Watertight Sewer Lines	Seepage Pit	Feedyard	=	lizer Storage	Oil Well /				
Other (Specity)	sockage ,								
Direction from well? S		Distance from well?	~20		ft				
10 FROM TO	LITHOLOG	IC LOG	FROM	TO	LITHO, LOG (con	nt.) or PLUGGIN	IG INTERVALS		
0 0.3 Conc									
0.3 8.5 Claye 8.5 15.5 Sand	ey silt			-					
0.5 13.3 Sand	yout								
			_		il Co.; U4-052-150:				
Target of monitoring well is shallow groundwater, <20' of grout was installed at the direction of KDHE.									
11 CONTRACTOR'S OR LANDOWNER'S CERTIFICATION: This water well was X constructed, or plugged under my									
jurisdiction and was completed	jurisdiction and was completed on (mo-day-year) 4/26/18 and this record is true to the best of my knowledge and belief. Kansas Water West Contractor's								
License No. 757 This Water Well Record was completed on (mo-day-year) 5/18/18									
under the business name of L		The state of the s		Signature	10				
	along with a fee of \$5.00 for each St., Suite 420, Topeka, Kansas 6						3		
1				a retain one for you	a records. rerephone		7/10/2015		
Visit us at http://www.kdheks.g	ov/waterweii/index.ntmi	1300 020-121	4				//10/2013		

DENNIS L HANDKE

26-8-22E 35 "

1820 NW 59th Terrace TOPEKA, KANSAS 66618 785-286-4047 Home 785-286-1990 Fax

May 12, 2018

1311 E. 25th St., Suite B Topeka, Kansas 66046

Jess Chapman

Larsen & Assoc.

RE: Monitor Well Elevation Survey 701 Delaware, Leavenworth, Kansas

Proj. 18-00P Porter Oil Co. KDHE ID A4-052-15056

Bench Mark: Chisled square on NE corner of concrete signal light base at the NE corner of property. Elev.: 791.82 North 5219 West 124 (from SE Cor. Sec. 35-8-22E)

		•			
MW-1	rim	791.06	North		NE1/4,NE1/4,NE1/4,NE1/4
	top pipe	790.66	West	118	Lat $= 39.31745$ Long $= 94.91850$
MW-2	rim	790.73	North	5267	NE1/4,NE1/4,NE1/4
	top pipe	790.40	West	257	Lat $= 39.31762$ Long $= 94.91899$
MW-3	rim	792.07	North	5275	SE1/4,SE1/4,SE1/4,SE1/4 (Sec. 26-8-22E)
21211	top pipe	791.69	West	166	Lat $= 39.31764$ Long $= 94.91867$
MW-4	rim	793,39	North	5249	NW1/4,NW1/4,NW1/4,NW1/4 (Sec. 36-8-22E)
172 77	top pipe	793.05	East	21	Lat $= 39.31757$ Long $= 94.91801$
MW-5	rim	790.00	North	5130	NE1/4,NE1/4,NE1/4,NE1/4
141 44 -2	top pipe	789.67	West	311	Lat = 39.31727 Long = 94.91919
MW-6	rim	784.88	North	5044	NE1/4,NE1/4,NE1/4,NE1/4
101 00 -0	top pipe	784.56	West	235	Lat = 39.31701 Long = 94.91892
N4337 7		704.17	NI	5004	NET /4 NET /4 NET /4 NET /4
MW-7	rim	784.16	North		NE1/4,NE1/4,NE1/4
	top pipe	783.86	West	192	Lat = 39.31690 Long = 94.91877

Lat & Long derived from Leavenworth 7.5' quad map. WGS84.


Elevation derived from USGS BM#251 NAVD83.

If you have any questions, please feel free to call me. Thank you for the opportunity to be

RECEIVED

MAY 31 2018

BUREAU OF WATER

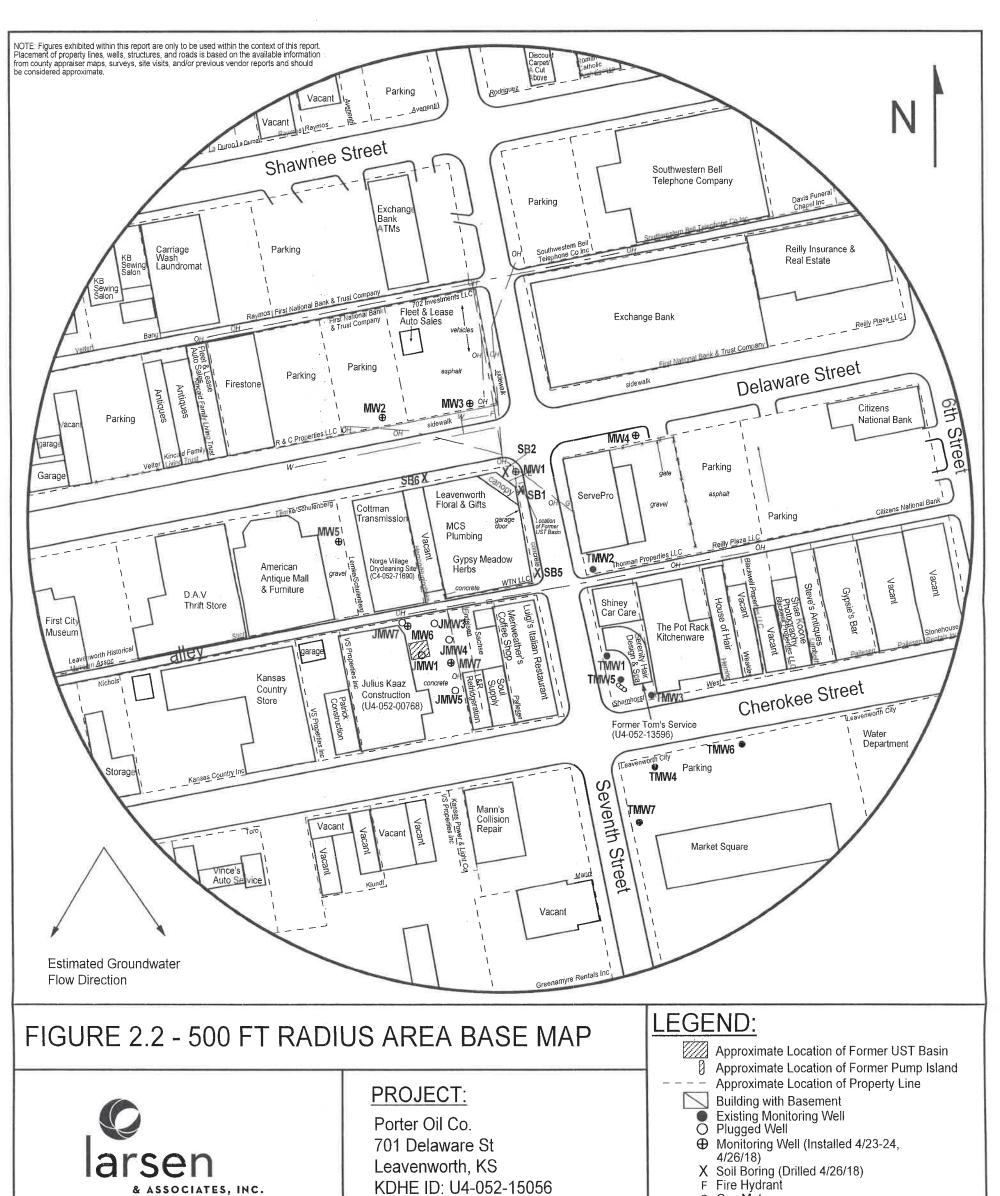

RECEIVED

100 feet

Date: 5/10/18

(785) 841-8707 office

(785) 865-4282 fax

1311 E 25th St., Suite B

Lawrence, KS 66046

G Gas Meter

NOTE: SB5 & SB6 were drilled to collect hydrologic samples NOTE: Utility depths, heights and locations are approximate.

QН

W

MAY 31 2018

BUREAU OF WATER

36 202

Electric Lines (2 - 6 ft BGS)

Water Lines (2 - 6 ft BGS)

Overhead Lines (25-40 ft high)