WATER WELL REC	CORD F	orm WWC-5			Division of Water			N/XX/=		
X Original Record	Correction	Change in Well I	Jst	Re	sources App. No.		Well ID	MW5		
1 LOCATION OF V		Fract NE		NE ¼ NE	1	per Township Nur	nber Range S R 2			
2 WELL OWNER:		First		Street or Rura	Address where w	ell is located (if unk				
Business: KDHE (P				from nearest t	own or intersection	n): If at owner's ac	ddress, check he	ere:		
Address: 1000 SW	Jackson St		7	19 Delaware St.	Leavenworth, KS					
Address:										
	peka State	KS ZIP:	66612	20 6	I stitude	39.317	707 (4-	-in-al dannasa)		
3 LOCATE WELL WITH "X" IN	4 DEP	TH OF COMPLE	etered: 1)	fi	5 Latitude: Longitud		919 (de	cimal degrees)		
SECTION BOX:	Depin(s) G	H 3)	ft, or 4)	n.Well		Datum: WGS	84 NAD	$\overline{\mathbf{X}}$ NAD 27		
N N	WELL'S ST	TATIC WATER LI	EVEL: 14.6	7 ft.		Latitude/Longitude		35 [A] 1411527		
T T			easured on (mo-day			(unit make/model:	•	.)		
			easured on (mo-day			AAS enabled?	Yes No)		
NW NE	Pump tes	st data: Well water	was	ft		Survey Topos		,		
			mping		Onlin	e Mapper				
<i>y</i>	E	Water w		fi						
SW SE	after	hours pu	mping	gpm	6 Elevation					
		d Yield:			Source X	Land Survey	GPS [Topographic Ma		
	Bore Hol	e Diameter:7.	25 in to	ft, and	[L	Other				
S	,		in to	ft						
mile										
7 WELL WATER TO 1 Domestic:		ic Water Supply: v	rell ID		10 Oil Field	Water Supply: leas	e			
Household					11 Test Hole: we					
Lawn & Garden						Cased Uncased Geotechnical				
Livestock		itoring: well ID N			12 Geothermal: H	_				
2 Irrigation		nental Remediation			a) Closed Lo		Vertic	al		
3 Feedlot			Soil Vapor Extraction	or	b) Open Loop Surface Discharge Inj. of Water					
4 Industrial	=	_ =	njection		Other (sp					
				16		1 20 1				
Vas a chemical/bacteriolo	gical sample submi	itted to KDHE?	Yes XN	o II yes,	date sample was s	ubmitted:				
Vater well disinfected?							<u> </u>			
8 TYPE OF CASINO	USED: Steel	X PVC LC	other	CASING.	JOINTS:Gi	uedClampled	Welded	X Threaded		
Casing diameter 2 Casing height above land su	in. to 10 11 rface -0.33	, Diameter	in. to	Ibe /ft W/	Diameter	in. to				
TYPE OF SCREEN OR				103./11.	cii diickiicss oi gat	ige 140				
		_	PVC		Other (Specify)					
		-	None used (open	hole)	Jouner (Speeliy)					
SCREEN OR PERFORA				noic)						
	X Mill Slot	Gauze Wrag	ned Torc	n Cut D	rilled Holes	Other (Specif	v)			
Louvered Shutter		Wire Wran	ned Saw				<i>y</i> ,			
SCREEN-PERFORATED	INTERVALS: From	n 10 ft to	20 ft	From	ft to	ft From	ft to	ft		
GRAVEL PACK I	VTERVALS: From	n 8 ft to	20 ft.	rom	ft. to	ft From	ft to	ft		
9 GROUT MATERIAL		Cement {	grout X Bento	nite A U	ner Concrete: U-1					
	1 ft. to 8	п, гто т		11, Г	romrt.	юп,				
Nearest source of possible			Die Deien		weete els Deme	Tunnatini d	- C+			
Septic Tank		ral Lines	Pit Privy		vestock Pens iel Storage	Insecticid	-			
Sewer Lines	<u>—</u>	Pool	Sewage Lagoon				ed Water Well			
Watertight Sewer Lin	ies Seep	age Pit	Feedyard	F6	ertilizer Storage	Oil Well	Gas Well			
Other (Specity)			Distance from 11	100		A				
irection from well? E			Distance from w			ft				
o FROM TO		ITHOLOGIC I	.OG	FROM	1 TO	LITHO, LOG (co	ont.) or PLUGGI	IG INTERVALS		
0 0.7	Gravel									
0.7 5 5 9.5	Silty clay Clavey silt with occa	sional fine cand								
9.5 9.5	Clavey silt with occa		nses							
7.0	- July 5 Jin Willi Cook	- Januar Into State To								
						Oil Co.; U4-052-15				
					-	shallow groundwate	r, <20' of grout	was installed at		
					on of KDHE.	1				
1 CONTRACTOR'S				ell was X	constructed,	reconstructed or	plugged	under my		
jurisdiction and was comp	pieted on (mo-day-yea	ar) 4/24/18	and this record is	true to the best	of my knowledge	and belies. Kansas	water Well Co.	tractor's		
License No. 757 under the business name	This Wat				8/18 Signature		\sim $+$	<i></i>		
	copy along with a fee of		structed well to: Kans	ac Department of		nent Bureau of Veta	Curr Castion			
	copy along with a fee of ackson St., Suite 420, T									
Visit us at http://www.kd			KSA 82a-					7/10/2015		
The state of the s										

DENNIS L HANDKE

26-8-22E 35 "

1820 NW 59th Terrace TOPEKA, KANSAS 66618 785-286-4047 Home 785-286-1990 Fax

May 12, 2018

1311 E. 25th St., Suite B Topeka, Kansas 66046

Jess Chapman

Larsen & Assoc.

RE: Monitor Well Elevation Survey 701 Delaware, Leavenworth, Kansas

Proj. 18-00P Porter Oil Co. KDHE ID A4-052-15056

Bench Mark: Chisled square on NE corner of concrete signal light base at the NE corner of property. Elev.: 791.82 North 5219 West 124 (from SE Cor. Sec. 35-8-22E)

		•			
MW-1	rim	791.06	North		NE1/4,NE1/4,NE1/4,NE1/4
	top pipe	790.66	West	118	Lat $= 39.31745$ Long $= 94.91850$
MW-2	rim	790.73	North	5267	NE1/4,NE1/4,NE1/4
	top pipe	790.40	West	257	Lat $= 39.31762$ Long $= 94.91899$
MW-3	rim	792.07	North	5275	SE1/4,SE1/4,SE1/4,SE1/4 (Sec. 26-8-22E)
21211	top pipe	791.69	West	166	Lat $= 39.31764$ Long $= 94.91867$
MW-4	rim	793,39	North	5249	NW1/4,NW1/4,NW1/4,NW1/4 (Sec. 36-8-22E)
172 77	top pipe	793.05	East	21	Lat = 39.31757 Long = 94.91801
MW-5	rim	790.00	North	5130	NE1/4,NE1/4,NE1/4,NE1/4
141 44 -2	top pipe	789.67	West	311	Lat = 39.31727 Long = 94.91919
MW-6	rim	784.88	North	5044	NE1/4,NE1/4,NE1/4,NE1/4
101 00 -0	top pipe	784.56	West	235	Lat = 39.31701 Long = 94.91892
N4337 7		704.17	NI	5004	NET /4 NET /4 NET /4 NET /4
MW-7	rim	784.16	North		NE1/4,NE1/4,NE1/4
	top pipe	783.86	West	192	Lat = 39.31690 Long = 94.91877

Lat & Long derived from Leavenworth 7.5' quad map. WGS84.


Elevation derived from USGS BM#251 NAVD83.

If you have any questions, please feel free to call me. Thank you for the opportunity to be

RECEIVED

MAY 31 2018

BUREAU OF WATER

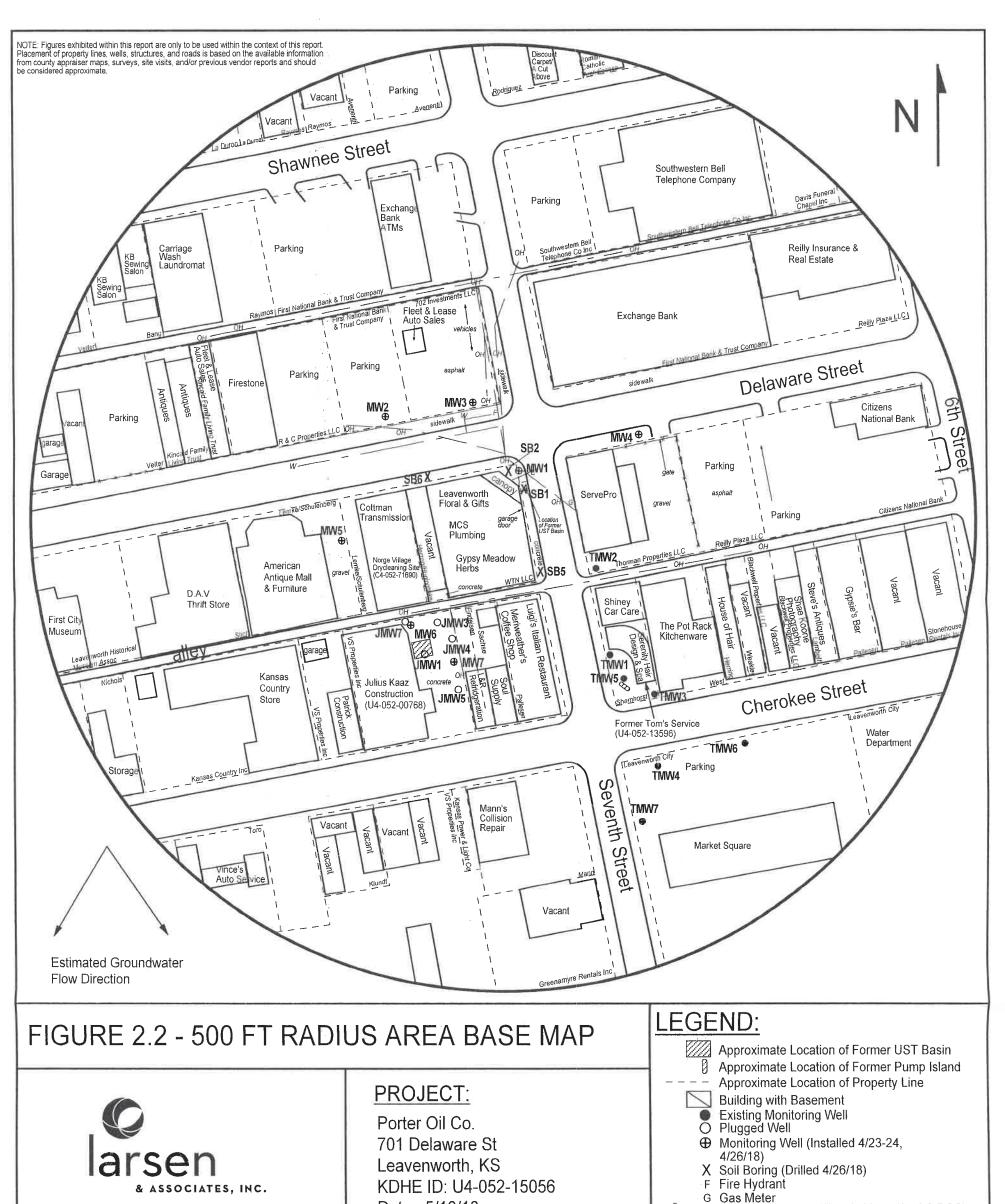

RECEIVED

100 feet

QН

W

NOTE: SB5 & SB6 were drilled to collect hydrologic samples NOTE: Utility depths, heights and locations are approximate.

Date: 5/10/18

(785) 841-8707 office

(785) 865-4282 fax

1311 E 25th St., Suite B

Lawrence, KS 66046

MAY 31 2018

BUREAU OF WATER

Electric Lines (2 - 6 ft BGS)

Water Lines (2 - 6 ft BGS)

Overhead Lines (25-40 ft high)