WATER WELL RECORD Form WWC-5	Division of Water					
X Original Record Correction Change in Well Ust	Resources App. No. Well ID MW6					
1 LOCATION OF WATER WELL: Fraction County Leavenworth NE 1/4 NE 1/4 NE	Section Number Township Number Range Number E ¼ NE ¼ 35 T 8 S R 22 X E W					
	Street or Rural Address where well is located (if unknown, distance and direction from nearest town or intersection): If at owner's address, check here:					
Address: 1000 SW Jackson St 716	Cherokee St, Leavenworth, KS					
Address: City Topeka State: KS ZIP: 66612						
3 LOCATE WELL 4 DEPTH OF COMPLETED WELL:	16 ft 5 Latitude: 39.31701 (decimal degrees)					
WITH "X" IN Depth(s) Groundwater Encountered: 1) SECTION BOX: 2)	ft Longitude 94.91892 (decimal degrees) Well Horizontal Datum: WGS 84 NAD 83 X NAD 27					
N WELL'S STATIC WATER LEVEL: 12.05	ft. Source for Latitude/Longitude:					
below land surface, measured on (mo-day-yr above land surface, measured on (mo-day-yr						
NW NE Dabove land surface, measured on (mo-day-yi	Topographic Map					
w after hours pumping g	pm Online Mapper					
after hours pumping	ppm 6 Elevation 784.56 ft Ground Level X TOC					
Estimated Yield: gpm	Source X Land Survey GPS Topographic Map					
	i, and Other					
S f f						
7 WELL WATER TO BE USED AS: 1 Domestic: 5 Public Water Supply: well ID	10 Oil Field Water Supply: lease					
1 Domestic: 5 Public Water Supply: well ID Household 6 Dewatering: how many wells?	10 Oil Field Water Supply: lease					
Lawn & Garden 7 Aquifer Recharge: well ID	Cased Uncased Geotechnical					
Livestock 8 X Monitoring: well ID MW6 2 Irrigation 9 Environmental Remediation: well ID	12 Geothermal: How many bores? a) Closed Loop Horizontal Vertical					
3 Feedlot Air Sparge Soil Vapor Extraction	b) Open Loop Surface Discharge Inj. of Water					
4 Industrial Recovery Injection	Other (specify):					
Was a chemical/bacteriological sample submitted to KDHE? Yes X No Water well disinfected? Yes X No	If yes, date sample was submitted:					
8 TYPE OF CASING USED: Steel X PVC Other	CASING JOINTS: Glued Clampled Welded X Threaded					
Casing diameter 2 in. to 6 ft, Diameter in. to	ft, Diameter in to ft,					
Casing height above land surface -0.32 in. Weight lbs./ft. Well thickness or gauge No TYPE OF SCREEN OR PERFORATION MATERIAL:						
Steel Stainless Steel Fiberglass X PVC	Other (Specify)					
Brass Galvanized Steel Concrete tile None used (open ho						
SCREEN OR PERFORATION OPENINGS ARE: Continuous Slot X Mill Slot Gauze Wrapped Torch C	Other (Specify)					
Louvered Shutter Key Punched Wire Wrapped Saw Cu						
SCREEN-PERFORATED INTERVALS: From 6 ft. to 16 ft, From ft. to ft, From ft. to ft,						
GRAVEL PACK INTERVALS: From 4 ft. to 16 ft, Fro.						
9 GROUT MATERIAL: Neat cement Cement grout X Bentonit Grout intervals: From 0.6 ft. to 4 ft, From ft. to	e X Other Concrete: 0-0.6'					
Grout intervals: From 0.6 ft. to 4 ft, From ft. to Nearest source of possible contamination:	II, FIOII					
Septic Tank Lateral Lines Pit Privy	Livestock Pens Insecticide Storage					
Sewer Lines Cess Pool Sewage Lagoon	X Fuel Storage Abandoned Water Well					
Watertight Sewer Lines	Fertilizer Storage Oil Well / Gas Well					
Direction from well? NE Distance from well?	~]75ft					
10 FROM TO LITHOLOGIC LOG	FROM TO LITHO. LOG (cont.) or PLUGGING INTERVALS					
0 0.6 Concrete 0.6 5 Silty clay						
5 7 Silt with some clay						
7 10 Silt with some clay and fine sand 10 16 Sandy silt with some clay						
To Dandy Silt Will Sollie Glay						
	Notes: KDHE ID: Porter Oil Co.; U4-052-15056					
	Target of monitoring well is shallow groundwater, <20' of grout was installed at the direction of KDHE.					
11 CONTRACTOR'S OR LANDOWNER'S CERTIFICATION: This water well was X constructed, or plugged under my						
jurisdiction and was completed on (mo-day-year) 4/24/18 and this record is true to the best of my knowledge and belief. Kansas Water Well Contractor's License No 757 This Water Well Record was completed on (mo-day-year) 5/18/18						
under the business name of Larsen & Associates, Inc. Signature						
Mail 1 white copy along with a fee of \$5.00 for each constructed well to: Kansas Department of Health and Environment, Bureau of Water, O'V & Section. 1000 SW Jackson St., Suite 420, Topeka, Kansas 66612-1367, Mail one to Water Well Owner and retain one for your records. Telephone 783-296-5524.						
Visit us at http://www.kdheks.gov/waterwell/index.html KSA 82a-1212 Revised 7/10/2015						

DENNIS L HANDKE

26-8-22E 35 "

1820 NW 59th Terrace TOPEKA, KANSAS 66618 785-286-4047 Home 785-286-1990 Fax

May 12, 2018

1311 E. 25th St., Suite B Topeka, Kansas 66046

Jess Chapman

Larsen & Assoc.

RE: Monitor Well Elevation Survey 701 Delaware, Leavenworth, Kansas

Proj. 18-00P Porter Oil Co. KDHE ID A4-052-15056

Bench Mark: Chisled square on NE corner of concrete signal light base at the NE corner of property. Elev.: 791.82 North 5219 West 124 (from SE Cor. Sec. 35-8-22E)

MW-1	rim	791.06	North		NE1/4,NE1/4,NE1/4,NE1/4
	top pipe	790.66	West	118	Lat $= 39.31745$ Long $= 94.91850$
MW-2	rim	790.73	North	5267	NE1/4,NE1/4,NE1/4
	top pipe	790.40	West	257	Lat $= 39.31762$ Long $= 94.91899$
MW-3	rim	792.07	North	5275	SE1/4,SE1/4,SE1/4,SE1/4 (Sec. 26-8-22E)
141 11 3	top pipe	791.69	West	166	Lat $= 39.31764$ Long $= 94.91867$
MW-4	rim	793.39	North	5249	NW1/4,NW1/4,NW1/4,NW1/4 (Sec. 36-8-22E)
	top pipe	793.05	East	21	Lat $= 39.31757$ Long $= 94.91801$
MW-5	rim	790.00	North	5139	NE1/4,NE1/4,NE1/4,NE1/4
1,1,1,	top pipe	789.67	West	311	Lat $= 39.31727$ Long $= 94.91919$
MW-6	rim	784.88	North	5044	NE1/4,NE1/4,NE1/4,NE1/4
141 44 -0	top pipe	784.56	West	235	Lat = 39.31701 Long = 94.91892
MW.7	rim	784 16	North	5004	NE1/4 NE1/4 NE1/4 NE1/4
141 AA - \					
MW-7	rim top pipe	784.16 783.86	North West	5004 192	NE1/4,NE1/4,NE1/4 Lat = 39.31690 Long = 94.91877

Lat & Long derived from Leavenworth 7.5' quad map. WGS84.


Elevation derived from USGS BM#251 NAVD83.

If you have any questions, please feel free to call me. Thank you for the opportunity to be

RECEIVED

MAY 31 2018

BUREAU OF WATER

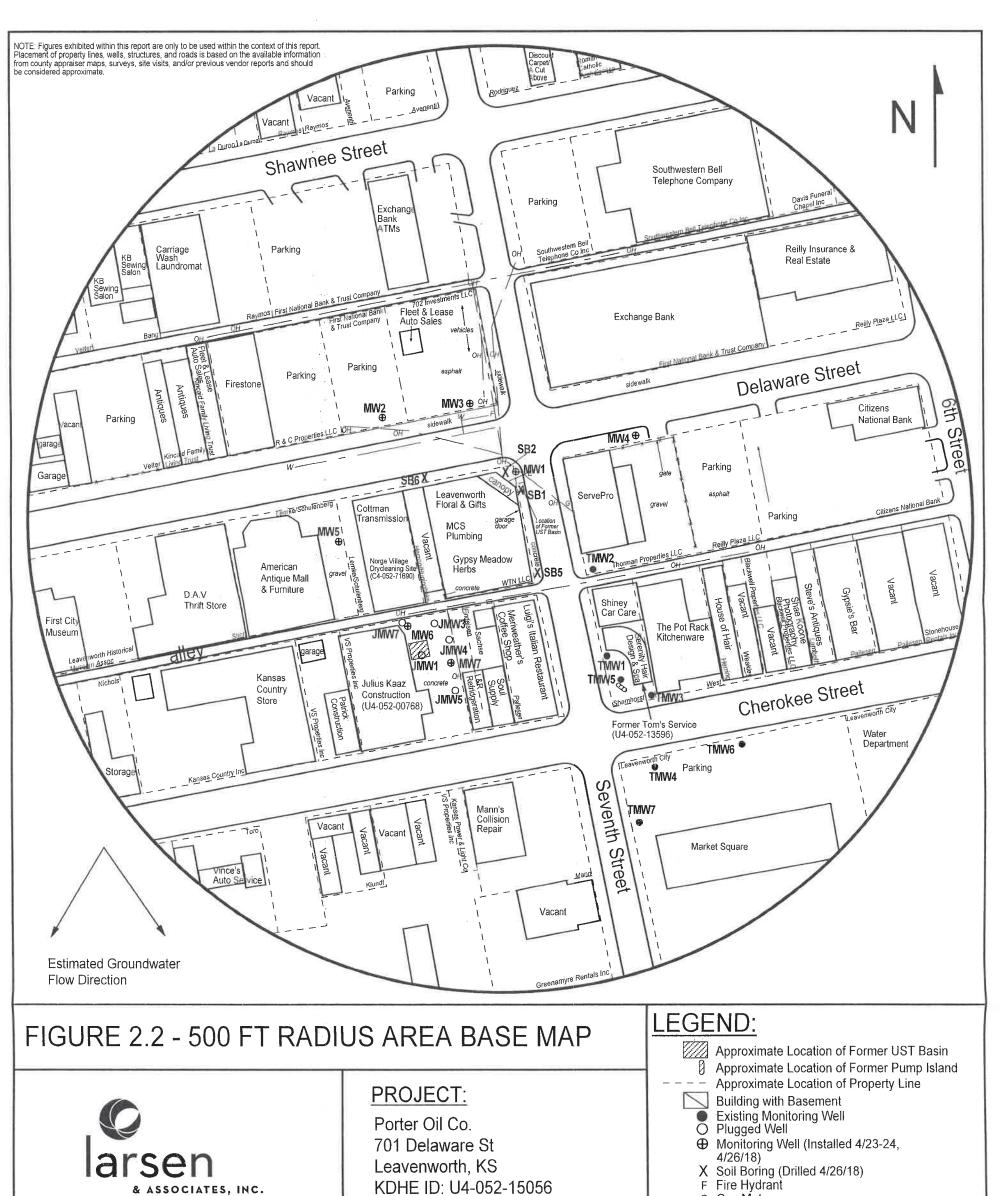

RECEIVED

100 feet

Date: 5/10/18

(785) 841-8707 office

(785) 865-4282 fax

1311 E 25th St., Suite B

Lawrence, KS 66046

G Gas Meter

NOTE: SB5 & SB6 were drilled to collect hydrologic samples NOTE: Utility depths, heights and locations are approximate.

QН

W

MAY 31 2018

BUREAU OF WATER

36 202

Electric Lines (2 - 6 ft BGS)

Water Lines (2 - 6 ft BGS)

Overhead Lines (25-40 ft high)