WATER WELL RECORD Form WWC-5	Division of Water Resources App. No. Well ID MW7					
X Original Record Correction Change in Well Ust						
1 LOCATION OF WATER WELL: Fraction County Leavenworth NE 1/4 NI	Section Number Township Number Range Number  VA NE VA NE VA S S R 22 X E W					
	Street or Rural Address where well is located (if unknown, distance and direction					
2 WELL OWNER: Last Name: First: Business: KDHE (Porter Oil Co.)	from nearest town or intersection): If at owner's address, check here:					
Address: 1000 SW Jackson St	716 Cherokee St, Leavenworth, KS					
Address:						
City Topeka State: KS ZIP: 66612	20.21/00					
3 LOCATE WELL 4 DEPTH OF COMPLETED WE Depth(s) Groundwater Encountered:	L: 14 ft 5 Latitude: 39.31690 (decimal degrees)  ft Longitude 94.91877 (decimal degrees)					
SECTION BOX:   2)	Horizontal Datum: WGS 84 NAD 83 X NAD 27					
N WELL'S STATIC WATER LEVEL:	11.61 ft. Source for Latitude/Longitude:					
X below land surface, measured on						
NW NE above land surface, measured on						
Pump test data: Well water was						
W after hours pumping Water well was	gpm Online Mapper					
after hours pumping	gpm 6 Elevation 783.86 ft Ground Level X TOC					
SW SE Estimated Yield: gpm	Source X Land Survey GPS Topographic Map					
Bore Hole Diameter: 7.25 in	oft, and Other					
S in	oft					
7 WELL WATER TO BE USED AS:						
1 Domestic: 5 Public Water Supply: well ID	10 Oil Field Water Supply: lease					
Household 6 Dewatering: how many wells?	11 Test Hole: well ID					
Lawn & Garden 7 Aquifer Recharge: well ID	Cased Uncased Geotechnical					
Livestock 8 X Monitoring: well ID MW7	12 Geothermal: How many bores?					
2 Irrigation 9 Environmental Remediation: well ID	a) Closed Loop Horizontal Vertical					
3 Feedlot Air Sparge Soil Vapor	Extractior b) Open Loop Surface Discharge Inj. of Water Other (specify):					
4 Industrial Recovery Injection						
Was a chemical/bacteriological sample submitted to KDHE? Yes	X No If yes, date sample was submitted:					
Water well disinfected? Yes X No						
8 TYPE OF CASING USED: Steel X PVC Other	CASING JOINTS: Glued Clampled Welded X Threaded					
Casing diameter 2 in. to 4 ft, Diameter  Casing height above land surface -0.30 in. Weight	n. toft, Diameterin. toft, lbs./ft. Well thickness or gauge No					
TYPE OF SCREEN OR PERFORATION MATERIAL:						
Steel Stainless Steel Fiberglass X PVC	Other (Specify)					
Brass Galvanized Steel Concrete tile None us	ed (open hole)					
SCREEN OR PERFORATION OPENINGS ARE:						
Continuous Slot X Mill Slot Gauze Wrapped	Torch Cut Drilled Holes Other (Specify)					
Louvered Shutter Key Punched Wire Wrapped	Saw Cut None (Open Hole)					
SCREEN-PERFORATED INTERVALS: From 4 ft. to 14	ft, From ft. to ft, From ft. to ft,					
GRAVEL PACK INTERVALS: From 3 ft. to 14 ft, From ft. to ft, From ft. to ft,						
9 GROUT MATERIAL: Neat cement Cement grout	Bentonite X Other Concrete: 0-1'					
Grout intervals: From 1 ft. to 3 ft, From	. to					
Nearest source of possible contamination:    Septic Tank	Livestock Pens Insecticide Storage					
Sewer Lines Cess Pool Sewage Lagoon X Fuel Storage Abandoned Water Well Watertight Sewer Lines Seepage Pit Feedyard Fertilizer Storage Oil Well / Gas Well						
Other (Specity)						
	from well? ~185 ft					
10 FROM TO LITHOLOGIC LOG	FROM TO LITHO. LOG (cont.) or PLUGGING INTERVALS					
0 0.6 Concrete						
0.6 0.8 Rubble fill						
0.8 14 Clayey silt						
	Notes: KDHE ID: Porter Oil Co.; U4-052-15056  Target of monitoring well is shallow groundwater, <20' of grout was installed at					
	the direction of KDHE.					
11 CONTRACTOR'S OR LANDOWNER'S CERTIFICATION: This	water well was X constructed, reconstructed, or plugged under my					
jurisdiction and was completed on (mo-day-year) 4/24/18 and this record is true to the best of my knowledge and belief. Kansas Water Wilcontractor's						
License No 757 This Water Well Record was completed on (nio-day-year) 5/18/18						
under the business name of Larsen & Associates, Inc.  Mail I white copy along with a fee of \$5.00 for each constructed well to: Kansas Department of Health and Environment, Bureau (Water, GW).						
1000 SW Jackson St., Suite 420, Topeka, Kansas 66612-1367, Mail one to Water Well Owner and retain one for your records. Telephone 785-296-5524.						
	SA 82a-1212 Revised 7/10/2015					

## DENNIS L HANDKE

26-8-22E 35 "

1820 NW 59th Terrace TOPEKA, KANSAS 66618 785-286-4047 Home 785-286-1990 Fax

May 12, 2018

1311 E. 25<sup>th</sup> St., Suite B Topeka, Kansas 66046

Jess Chapman

Larsen & Assoc.

RE: Monitor Well Elevation Survey 701 Delaware, Leavenworth, Kansas

Proj. 18-00P Porter Oil Co. KDHE ID A4-052-15056

Bench Mark: Chisled square on NE corner of concrete signal light base at the NE corner of property. Elev.: 791.82 North 5219 West 124 (from SE Cor. Sec. 35-8-22E)

		•			
MW-1	rim	791.06	North		NE1/4,NE1/4,NE1/4,NE1/4
	top pipe	790.66	West	118	Lat $= 39.31745$ Long $= 94.91850$
MW-2	rim	790.73	North	5267	NE1/4,NE1/4,NE1/4
	top pipe	790.40	West	257	Lat $= 39.31762$ Long $= 94.91899$
MW-3	rim	792.07	North	5275	SE1/4,SE1/4,SE1/4,SE1/4 (Sec. 26-8-22E)
	top pipe	791.69	West	166	Lat $= 39.31764$ Long $= 94.91867$
MW-4	rim	793,39	North	5249	NW1/4,NW1/4,NW1/4,NW1/4 (Sec. 36-8-22E)
172 77	top pipe	793.05	East	21	Lat $= 39.31757$ Long $= 94.91801$
MW-5	rim	790.00	North	5130	NE1/4,NE1/4,NE1/4,NE1/4
141 44 -2	top pipe	789.67	West	311	Lat = $39.31727$ Long = $94.91919$
MW-6	rim	784.88	North	5044	NE1/4,NE1/4,NE1/4,NE1/4
101 00 -0	top pipe	784.56	West	235	Lat = $39.31701$ Long = $94.91892$
N4337 7		704.17	NI	5004	NET /4 NET /4 NET /4 NET /4
MW-7	rim	784.16	North		NE1/4,NE1/4,NE1/4
	top pipe	783.86	West	192	Lat = 39.31690 Long = 94.91877

Lat & Long derived from Leavenworth 7.5' quad map. WGS84.


Elevation derived from USGS BM#251 NAVD83.

If you have any questions, please feel free to call me. Thank you for the opportunity to be

RECEIVED

MAY 31 2018

BUREAU OF WATER

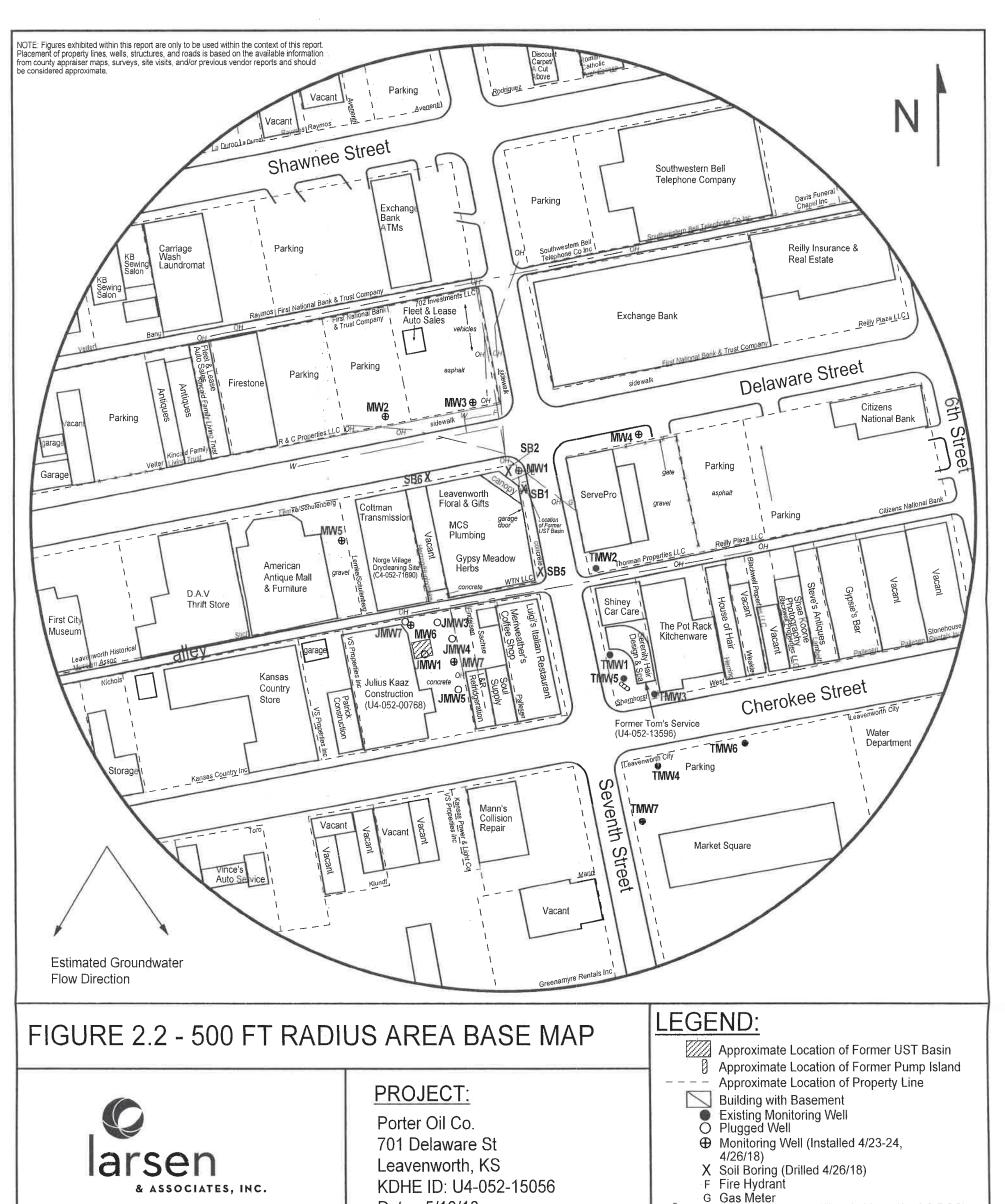

RECEIVED

100 feet

QН

W

NOTE: SB5 & SB6 were drilled to collect hydrologic samples NOTE: Utility depths, heights and locations are approximate.

Date: 5/10/18

(785) 841-8707 office

(785) 865-4282 fax

1311 E 25th St., Suite B

Lawrence, KS 66046

MAY 31 2018

BUREAU OF WATER

Electric Lines (2 - 6 ft BGS)

Water Lines (2 - 6 ft BGS)

Overhead Lines (25-40 ft high)