NATER WELL RECORD Form WWC-5			Division of Water Resources App. No. Well ID MW4					
X Original Record	Correction Change in	Well Ust	Resou	rces App. No.	L	Well ID		
1 LOCATION OF WA	TER WELL:	Fraction	W IZ NW IZ		er Township Nun			
County Leavenworth		NW 1/4 NW 1/4 N		·	T 8	S   R 22		
2 WELL OWNER: Last Business: KDHE (Porter		First:			ell is located (if unk ): If at owner's ad			
Address: 1000 SW Jack		62	Delaware St. Lea		). If at Owner's ac	idiess, elicer liei	· -	
Address: 1000 3 W Jack	3011 31	02	Dolaware St, Bee	remoral, res				
City Topeka	State: KS	ZIP: 66612						
3 LOCATE WELL	4 DEPTH OF CO	MPLETED WELL:	20 ft 5				imal degrees)	
WITH "X" IN	Depth(s) Groundwater	Encountered: 1)	ft ft	Longitude	94.918	01 (dec	imal degrees)	
SECTION BOX:	2) ft 3	) ft, or 4) Dr	y Well		Datum: WGS Latitude/Longitude		3 X NAD 27	
N N	-	TER LEVEL: 15.57 ace, measured on (mo-day-	I		unit make/model:	•	,	
		ace, measured on (mo-day-		`	AAS enabled?			
NW - NE -	Pump test data: Wel		fi					
		ours pumping						
W	E   W	ater well was	ft					
SW SE		ours pumping	gpm		793.05 ft			
3w = 3E	Estimated Yield:	gpm	1	Source X	Land Survey			
	Bore Hole Diameter:	7.25 in to	ft, and		Other			
S		in to	,n					
7 WELL WATER TO BE								
1 Domestic:	5 Public Water Su	pply: well ID	10	Oil Field	Water Supply: lease	e		
Household	6 Dewatering: how		1	Test Hole: wel				
Lawn & Garden	7 Aquifer Recharg			Cased	Uncased	Geotechnica	l	
Livestock	8 X Monitoring: wel	I ID MW4	13	Geothermal: Ho	ow many bores?			
2 Irrigation	9 Environmental Reme	diation: well ID		<ul> <li>a) Closed Loc</li> </ul>	· ==		i	
3 Feedlot	Air Sparge	Soil Vapor Extraction		b) Open Loop		ischarge	Inj. of Water	
4 Industrial	Recovery	Injection		Other (spe	ecify):			
Was a chemical/bacteriologic	al sample submitted to KD	HE? Yes X No	If yes, dat	e sample was su	ıbmitted:			
Water well disinfected? Ye								
8 TYPE OF CASING US	SED: Steel X PVC	Other	CASING JOI	NTS:Glı	ied Clampled	Welded 2	Threaded	
Casing diameter 2 in.	to 10 ft, Diame	eterin. to	ft,	Diameter	in. to	ft,	İ	
Casing height above land surface	ce0.34in. W	eight	ıbs./π. well t	nickness or gau	ge No			
TYPE OF SCREEN OR PE		X PVC		ther (Specify)				
Steel Stainless	<b>=</b>	=		ther (Specify)				
Brass Galvanize		None used (open )	iole)					
l		e Wrapped Torch	Cut Drille	d Holes	Other (Specify	۸		
Louvered Shutter					Outer (Specify	<u> </u>		
SCREEN-PERFORATED INT	ERVALS: From 10	ft to 20 ft F	rom ft.	to	ft. From	ft. to	ft	
GRAVEL PACK INT	ERVALS: From 8	ft. to 20 ft. F	om ft.	to	ft. From	ft. to	ft.	
9 GROUT MATERIAL:		ement grout X Bentor						
	1 ft. to 8 ft, F				to ft			
Nearest source of possible co		1011	16, 1101	11	11,			
Septic Tank	Lateral Lines	Pit Privy	Lives	tock Pens	Insecticide	Storage		
Sewer Lines	Cess Pool	Sewage Lagoon		Storage	===	d Water Well		
Watertight Sewer Lines	Seepage Pit	Feedyard		izer Storage	Oil Well /			
Other (Specity)	Scopage i ii	recayand		izer Storage	on en /	Cuscii		
Direction from well? SW		Distance from we	1? ~140		ft			
10 FROM TO	LITHOLO		FROM	ТО		nt.) or PLUGGIN	G INTERVALS	
	ndscaping mulch							
0.3 15 Sil	ty clay							
15 20 Fin	e sand with silt							
			_		il Co.; U4-052-150			
			_	•	hallow groundwater	r, <20' of grout v	was installed at	
11 CONTRACTORIS OR	LANDOWNEDIC CERTIFIC	CATION: Thisstar	the direction of		reconstructed, or	plugged	ınder my	
	LANDOWNER'S CERTIFI							
jurisdiction and was completed on (mo-day-year) 4/24/18 and this record is true to the best of my knowledge and belief. Kansas Water well Contractor's  License No 757 This Water Well Record was completed on (mo-day-year) 5/18/18								
under the business name of Larsen & Associates, Inc. Signature								
Mail 1 white cop	y along with a fee of \$5.00 for ea	ach constructed well to: Kansa	Department of Hea	alth and Environm	ent. Bureau of Water	Our Section		
	on St., Suite 420, Topeka, Kansa			retain one for you	ur records. Telephone			
Visit us at http://www.kdhek	s.gov/waterwell/index.html	KSA 82a-1	212			Revised	7/10/2015	

1820 NW 59th Terrace TOPEKA, KANSAS 66618 785-286-4047 Home 785-286-1990 Fax 26-8-22E 35 "

Jess Chapman Larsen & Assoc. 1311 E. 25<sup>th</sup> St., Suite B Topeka, Kansas 66046 May 12, 2018

RE: Monitor Well Elevation Survey 701 Delaware, Leavenworth, Kansas

Proj. 18-00P Porter Oil Co. KDHE ID A4-052-15056

Bench Mark: Chisled square on NE corner of concrete signal light base at the NE corner of property. Elev.: 791.82 North 5219 West 124 (from SE Cor. Sec. 35-8-22E)

MW-1	rim	791.06	North	5206	NE1/4,NE1/4,NE1/4,NE1/4
	top pipe	790.66	West	118	Lat = 39.31745 Long = 94.91850
MW-2	rim top pipe	790.73 790.40	North West	5267 257	NE1/4,NE1/4,NE1/4,NE1/4 Lat = 39.31762 Long = 94.91899
MW-3	rim	792.07	North :	5275	SE1/4,SE1/4,SE1/4,SE1/4 (Sec. 26-8-22E)
	top pipe	791.69	West	166	Lat = 39.31764 Long = 94.91867
MW-4	rim	793.39	North :	5249	NW1/4,NW1/4,NW1/4,NW1/4 (Sec. 36-8-22E)
	top pipe	793.05	East	21	Lat = 39.31757 Long = 94.91801
MW-5	rim top pipe	790.00 7 <b>8</b> 9.67	North :	5139 311	NE1/4,NE1/4,NE1/4,NE1/4 Lat = 39.31727 Long = 94.91919
MW-6	rim	784.88	North S	5044	NE1/4,NE1/4,NE1/4,NE1/4
	top pipe	784.56	West	235	Lat = 39.31701 Long = 94.91892
MW-7	rim top pipe	784.16 783.86	North 5	5004 192	NE1/4,NE1/4,NE1/4,NE1/4 Lat = 39.31690 Long = 94.91877

Lat & Long derived from Leavenworth 7.5' quad map. WGS84.

Elevation derived from USGS BM#251 NAVD83.


If you have any questions, please feel free to call me. Thank you for the opportunity to be

engis Lellandiko RL

RECEIVED

MAY 31 2018

BUREAU OF WATER

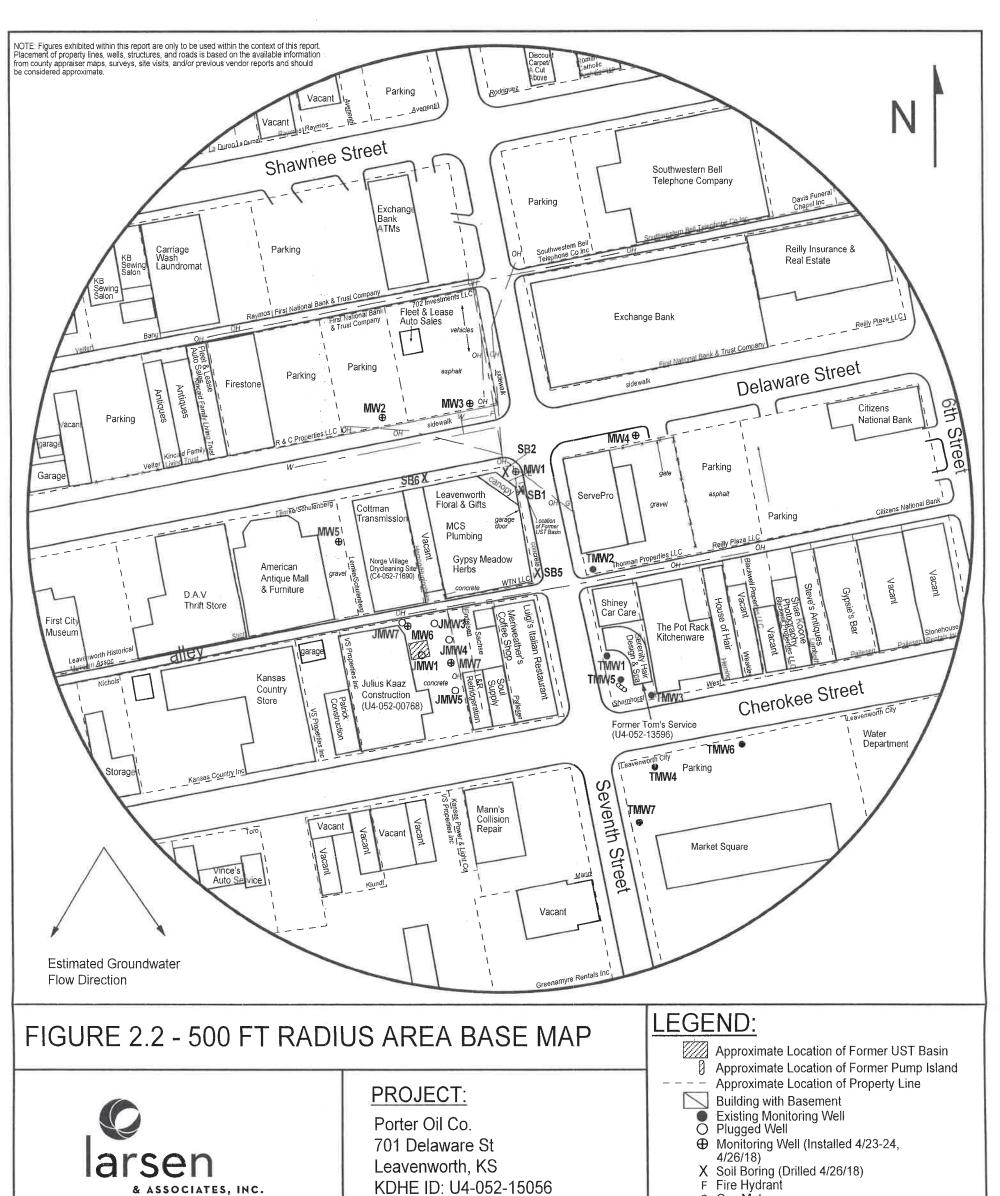

RECEIVED

100 feet

Date: 5/10/18

(785) 841-8707 office

(785) 865-4282 fax

1311 E 25th St., Suite B

Lawrence, KS 66046

G Gas Meter

NOTE: SB5 & SB6 were drilled to collect hydrologic samples NOTE: Utility depths, heights and locations are approximate.

QН

W

MAY 31 2018

BUREAU OF WATER

36 202

Electric Lines (2 - 6 ft BGS)

Water Lines (2 - 6 ft BGS)

Overhead Lines (25-40 ft high)