
WATER WELL REC		WWC-5		sion of Water		MW-10		
■ Original Record □ Co		e in Well Use		urces App. No.		Well ID		
1 LOCATION OF WATE	ER WELL:	Fraction		tion Number	Township Numbe			
County: Clay		NE1/4 NE1/4 NW 1/4				R 3 ■E□W		
2 WELL OWNER: Last N	ame:	First:	Street or Rural Address where well is located (if unknown, distance and					
Business: KDHE direction from nearest town or intersection): If at owner's address, check here:								
Address: 1000 SW Jackson St; Ste. 410 Between 5th & 6th streets and Pomeroy St.								
Address:								
City: Topeka	State: KS	ZIP: 66612	Clay G					
3 LOCATE WELL	DEDTH OF COM	IPLETED WELL: .	30 fr	5 Lotitud	39.3724	(desimal dagrass)		
		5 Latitude: 39.37244 (decimal degrees) Longitude: -97.12588 (decimal degrees)						
SECTION BOX: Depth(s) Groundwater Encountered: 1)				Well Horizontal Datum: WGS 84 NAD 83 NAD 27				
WELL'S STATIC WATER LEVEL:				Horizont	al Datum: WGS 84	□ NAD 83 □ NAD 27		
below land surface, measured on (mo-day-yr)				Source for Latitude/Longitude:				
	above land surface, measured on (mo-day-yr)				_ / _ /			
Pump test data: Well water was				☐ Land Survey ☐ Topographic Map				
W A after hours pumping gpm Well water was ft.				Online Mapper:				
SWSE after hours pumping gpm								
	gpm	gpm	6 Elevation	on:ft.	☐ Ground Level ☐ TOC			
S	gpm 8.5 in. to30							
mile								
7 WELL WATER TO BE USED AS: 1. Domestic: 5. □ Public Water Supply: well ID								
1. Domestic:								
Household	g: how many wells?							
Lawn & Garden	echarge: well ID							
☐ Lawn & Garden ☐ Livestock 7. ☐ Aquifer Recharge: well ID MW-10 8. ☐ Monitoring: well ID								
2. Irrigation 9. Environmental Remediation: well ID								
3. ☐ Feedlot	☐ Air Sparge		Extraction	traction b) Open Loop Surface Discharge Inj. of Water 13. Other (specify):				
4. Industrial	☐ Recovery	☐ Injection		13. ☐ Othe	r (specify):			
Was a chemical/bacteriological sample submitted to KDHE? Yes No If yes, date sample was submitted:								
Water well disinfected? ☐ Yes ☐ No								
8 TYPE OF CASING USED: ☐ Steel ☐ PVC ☐ Other								
Casing diameter 2 in to 20 ft Diameter in to ft Diameter in to								
Casing diameter								
TYPE OF SCREEN OR PERFORATION MATERIAL:								
SCREEN OR PERFORATION OPENINGS ARE:								
☐ Continuous Slot ☐ Mill Slot ☐ Gauze Wrapped ☐ Torch Cut ☐ Drilled Holes ☐ Other (Specify)								
□ Louvered Shutter □ Key Punched □ Wire Wrapped □ Saw Cut □ None (Open Hole)								
SCREEN-PERFORATED INTERVALS: From .20 ft. to .30 ft., From ft. to ft., From ft. to ft.								
GRAVEL PACK INTERVALS: From								
9 GROUT MATERIAL: ☐ Neat cement ☐ Cement grout ☐ Bentonite ☐ Other								
Grout Intervals: From								
Nearest source of possible contamination:								
☐ Septic Tank ☐ Lateral Lines ☐ Pit Privy ☐ Livestock Pens ☐ Insecticide Storage								
☐ Sewer Lines ☐ Cess Pool ☐ Sewage Lagoon ☐ Fuel Storage ☐ Abandoned Water Well								
☐ Watertight Sewer Lines ☐ Seepage Pit ☐ Feedyard ☐ Fertilizer Storage ☐ Oil Well/Gas Well								
Other (Specify)								
Direction from well?								
10 FROM TO	LITHOLOG	GIC LOG	FROM	TO L	ITHO. LOG (cont.) or	PLUGGING INTERVALS		
0 5 Black	silty clay							
5 25 Light	Brown silty clay							
25 30 Light	prown medium sand							
			 					
			Notes:					
11 CONTRACTOR'S OR LANDOWNER'S CERTIFICATION: This water well was constructed, reconstructed, or plugged								
under my jurisdiction and was completed on (mo-day-year) 5/31/2019 and this record is troe to the best of my knowledge and belief.								
Kansas Water Well Contractor's License No. 710 This Water Well Record was completed on md-hay-year) 06/26/2019								
under the business name of Below Ground Surface, Inc. Signature () Signature								
Mail I white copy along with a fee of \$5.00 for each constructed well to: Kansas Department of Health and Environment, Bureau of Water, GWTS Section,								
1000 SW Jackson St., Suite 420, Topeka, Kansas 66612-1367. Mail one to Water Well Owner and retain one for your records. Telephone 785-296-5524.								
Visit us at http://www.kdheks.gov/waterwell/index.html KSA 82a-1212 Revised 7/10/2015								

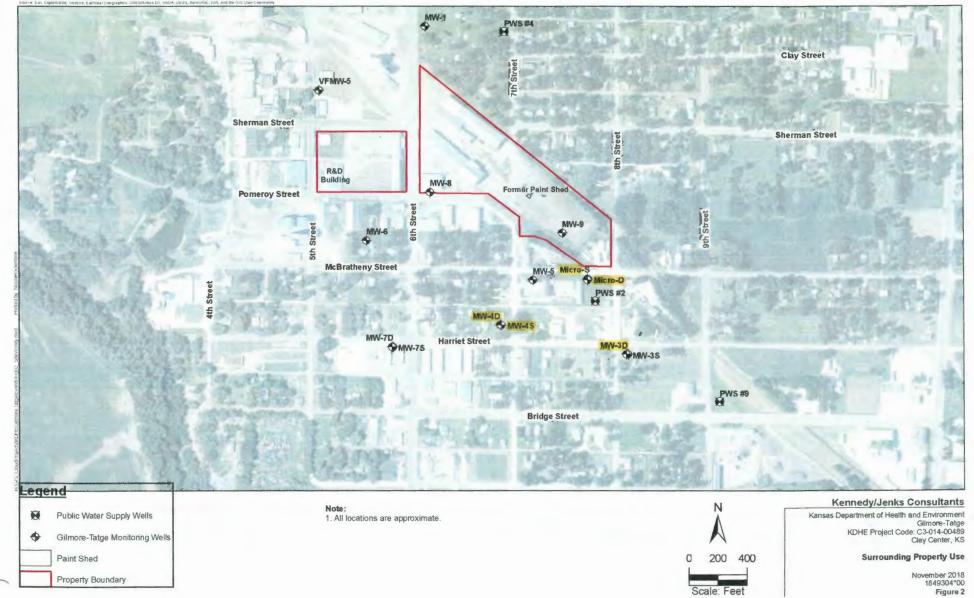

lay