
WATER WELL R		WWC-5		sion of Water		MW-12	
Original Record		ge in Well Use	Reso	urces App. No.		Well ID	
1 LOCATION OF W	ATER WELL:	Fraction	Sec	tion Number	Township Number		
County: Clay	NE1/4 NE1/4 NW 1/4						
2 WELL OWNER: Last Name: First: Street or Rural					nere well is located (i		
Business: KDHE direction from nearest town or intersection): If at owner's address, check here:							
Address: 1000 SW Jackson St; Ste. 410 Between 5th and loth Streets at Pomerou St.							
Addiess.						Tomerog 21.	
City: Topeka	State: KS	ZIP: 66612	clay (enter	<u> </u>		
3 LOCATE WELL	A DEPTH OF COA	IPLETED WELL:		E I addud	39.3722	7 (desired decree)	
WITH "X" IN			5 Latitud	5 Latitude: 39. 37227 (decimal degrees) Longitude: 97. 12530 (decimal degrees)			
SECTION BOX:	Depth(s) Groundwater Encountered: 1)			Longitu	Horizontal Datum: WGS 84 NAD 83 NAD 27		
N	2) ft. 3) ft., or 4) \(\subseteq \text{ Dry Well} \) WELL'S STATIC WATER LEVEL: ft.			Horizont	al Datum: WGS 84	□ NAD 83 □ NAD 2/	
	below land surface, measured on (mo-day-yr)				Source for Latitude/Longitude:		
' '	above land surface, measured on (mo-day-yr)				GPS (unit make/model: Garmin etrek		
NW NE				(WAAS enabled? Yes No)			
	Pump test data: Well water was			☐ Land Survey ☐ Topographic Map			
W X E	after			☐ Online Mapper:			
SW SE	after hours pumping gpm						
	Estimated Yield:gpm			6 Elevation	on:ft.	☐ Ground Level ☐ TOC	
S	Bore Hole Diameter:			Source: Land Survey GPS Topographic Map			
mile	Bole Hole Diameter	in to	. II. and				
The state of the s							
7 WELL WATER TO BE USED AS: 1. Domestic: 5. ☐ Public Water Supply: well ID							
1. Domestic:							
Household	6. ☐ Dewatering: how many wells?			11. Test Hole: well ID			
Lawn & Garden	/. \square Aquiter R	.12		☐ Cased ☐ Uncased ☐ Geotechnical			
Livestock				12. Geothermal: how many bores?			
2. Irrigation	9. Environmental Remediation: well 1D				a) Closed Loop Horizontal Vertical		
	3. ☐ Feedlot ☐ Air Sparge ☐ Soil Vapor Extraction				b) Open Loop Surface Discharge Inj. of Water		
4. Industrial	☐ Recovery	☐ Injection		13. □ Othe	r (specify):		
Was a chemical/bacteriological sample submitted to KDHE? Yes No If yes, date sample was submitted:							
Water well disinfected? ☐ Yes ■ No							
		C D Other	CASIN	IG IOINTS:	☐ Glued ☐ Clamped	☐ Welded ■ Threaded	
8 TYPE OF CASING USED: Steel PVC Other CASING JOINTS: Glued Clamped Welded Threaded Casing diameter 2 in to 20 ft Diameter in to the Diameter in to the Diameter of the Diamet							
Casing diameter							
TYPE OF SCREEN OR PERFORATION MATERIAL:							
☐ Steel ☐ Stainless Steel ☐ Fiberglass ☐ PVC ☐ Other (Specify)							
☐ Brass ☐ Galvanized Steel ☐ Concrete tile ☐ None used (open hole)							
SCREEN OR PERFORATION OPENINGS ARE:							
□ Louvered Shutter □ Key Punched □ Wire Wrapped □ Saw Cut □ None (Open Hole)							
SCREEN-PERFORATED INTERVALS: From 20 ft. to 30 ft., From ft. to ft., From ft. to ft.							
GRAVEL PACK INTERVALS: From							
9 GROUT MATERIAL: ☐ Neat cement ☐ Cement grout ☐ Bentonite ☐ Other							
Grout Intervals: From							
Nearest source of possible contamination:							
☐ Septic Tank ☐ Lateral Lines ☐ Pit Privy ☐ Livestock Pens ☐ Insecticide Storage							
☐ Sewer Lines ☐ Cess Pool ☐ Sewage Lagoon ☐ Fuel Storage ☐ Abandoned Water Well							
☐ Watertight Sewer Lines ☐ Seepage Pit ☐ Feedyard ☐ Fertilizer Storage ☐ Oil Well/Gas Well							
☐ Other (Specify) Direction from well? Distance from well? ft.							
			11?		ft.		
10 FROM TO	LITHOLO	GIC LOG	FROM	TO L	THO. LOG (cont.) or F	LUGGING INTERVALS	
	Black silty clay						
5 25 L	ight Brown silty clay						
25 30 L	ight brown medium sand						
			 				
					····		
			Notes:				
11 CONTRACTOR'S OR LANDOWNER'S CERTIFICATION: This water well was constructed, reconstructed, or plugged							
under my jurisdiction and was completed on (mo-day-year) 5/31/2019 and this record is artic to the best of my knowledge and belief.							
Kansas Water Well Contractor's License No. 710 This Water Well Record was completed on Job Iddy-year) 06/26/2019							
under the business name of Below Ground Surface, Inc. Signature Asi K. Here							
Mail 1 white copy along with a fee of \$5.00 for each constructed well to: Kansas Department of Health and Environment, Bureau of Water, GWTS Section,							
1000 SW Jackson St., Suite 420, Topeka, Kansas 66612-1367. Mail one to Water Well Owner and retain one for your records. Telephone 785-296-5524.							
Visit us at http://www.kdheks.gov/waterwell/index.html KSA 82a-1212 Revised 7/10/201							

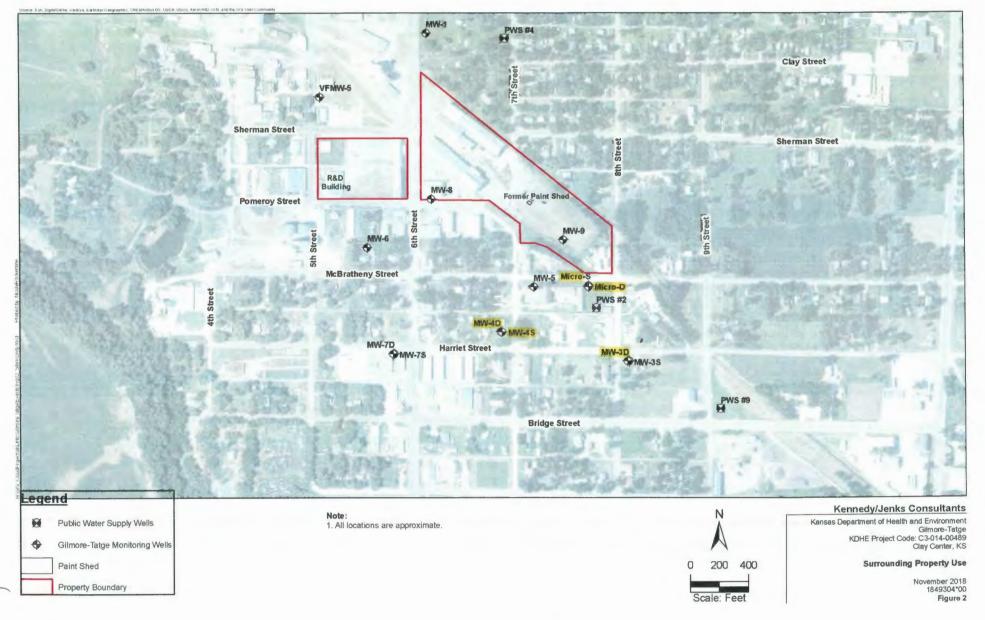

lan