
COLATION OF WATER WELL:	WATER WELL R		WWC-5	Divi	sion of Water	·	MW-14	
County-Clay NEL NEV. N			ge in Well Use				Well ID	
Street or Kural Address where well is located (if unknown, distince and Basiness, CRM) Street or Kural Address where well is located (if unknown, distince and States) Street or Kural Address where well is located (if unknown, distince and States) Statistics		ATER WELL:						
Basines Rober Goldan Address Goldan Sale Sale Address Goldan Sale	County: Clay			- 1	_	1 0		
Address: 100 SW Jackson St. Ste. 410 ADDRESS: 100 SW Jackson St. ADDRESS: 100 SW Jackson St. 410 ADDRESS: 100 SW Jackson St. ADDRESS: 100 SW Jackson St. ADDRESS: 100 SW Jackson St. 410 ADDRESS: 100 SW Jackson St. ADDRESS: 100 SW Jackson St. ADDRESS: 100 SW Jackson St. 410 ADD		st Name:	First:	Street or Rura	al Address v	where well is located	(if unknown, distance and	
Succase May 1				direction from ne	earest town or	intersection): If at owner	r's address, check here:	
Source for Lander Land Land Land Land Land Land Land Land	Address: 1000 SW Jackson St; Ste. 410 Between 5th and 6th St. at Pomerry St.							
A DEPTH OF COMPLETED WELL 30 ft.								
Depthis Groundwater Encountered: 1)		State. NO	ZIF: 00012	cay !	enes	20 27 2	~~	
SECTION BOX: Depth(s) Groundwafer Encountered: 1)		4 DEPTH OF COM	MPLETED WELL: .	30 ft.	5 Latitu	de: 27.272	(decimal degrees)	
2		Depth(s) Groundwater	Encountered: 1)	ft.	Longi			
WELL STATIC WATER LEVEL State St					Horizo			
Section Sect					Source for Latitude/Longitude:			
Pump test data: Well water was farter hours pumping gpm dafter hours pumping dafter hours pu					GPS (unit make/model: Garmin etrek)			
Second S	NW NE							
Section Sect								
after	W X	Well	water was f	gpm		☐ Online Mapper:		
Similared Yield:	SW SE	after — hour	s numning	gnm				
S		Estimated Yield:	gpm	Sh				
mile	S	Bore Hole Diameter:	8.5 in. to 30	ft. and	Source	Source: Land Survey GPS Topographic Map		
Notes: N	1 mile					☐ Other		
Domestic: Goldware Supply: well ID 10 Oil Field Water Supply: lease Household Goldware Supply: lease Household Goldware Recharge: well ID Goldware Goldware Recharge: well ID How Will Goldware Go	· . · · · · · · · · · · · · · · · · · ·							
Household G. Dewatering: how many wells? 11. Test Hole: well ID Cased Incased Geotechnical Lawn & Garden Cased Menitoring: well ID 12. Geothermal: how many bores?	1		ater Supply: well ID		10. 🗌 Oil	Field Water Supply: le	ease	
Livestock S. Monitoring: well ID MW-14 Cased Uncased Geotechnical Ceothermals Norses' Uncased Geotechnical Ceothermals Norses' C		6. Dewateri	ng: how many wells?					
2. Irrigation S. Environmental Remediation: well ID a) Closed Loop Horizontal Vertical A Industrial Ari Sparge Soil Vapor Extraction Boopen Loop Surface Discharge Inj. of Water A Industrial Recovery Injection Boopen Loop Surface Discharge Inj. of Water A Industrial Recovery Injection Boopen Loop Surface Discharge Inj. of Water A Industrial Recovery Injection Boopen Loop Surface Discharge Inj. of Water A Inj. Other (specify): Was a chemical/bacteriological sample submitted to KDHE? Yes No No No No No No No N	☐ Lawn & Garden	7. Aquifer Recharge: well ID				☐ Cased ☐ Uncased ☐ Geotechnical		
Air Sparge	☐ Livestock	8. Monitorii	ng: well IDMW	/-14	Geoth	12. Geothermal: how many bores?		
A		Environmen				a) Closed Loop		
Was a chemical/bacteriological sample submitted to KDHE? Yes	i -			Extraction				
Water well disinfected? Yes No No No No No No No N	4. Industrial Recovery Injection 13. Other (specify):							
Water well disinfected? Yes No No No No No No No N	Was a chemical/bacteriological sample submitted to KDHE? ☐ Yes ■ No If yes, date sample was submitted:							
Casing diameter								
Casing diameter	8 TYPE OF CASING USED: □ Steel ■ PVC □ Other CASING IOINTS: □ Glued □ Clamped □ Welded ■ Threaded							
TYPE OF SCREEN OR PERFORATION MATERIAL: Steel	Casing diameter 2 in to 20 ft. Diameter in to ft. Diameter in to ft.							
TYPE OF SCREEN OR PERFORATION MATERIAL: Steel	Casing height above land surface							
Brass Galvanized Steel Concrete tile None used (open hole) SCREEN OR PERFORATION OPENINGS ARE: Continuous Slot Mill Slot Gauze Wrapped Saw Cut None (Open Hole) SCREEN-PERFORATED INTERVALS: From 20. ft. to 30. ft., From ft. to ft., From ft. to ft. GRAVEL PACK INTERVALS: From 18. ft. to 30. ft., From ft. to ft., From ft. to ft. GRAVEL PACK INTERVALS: From 18. ft. to 30. ft., From ft. to ft., From ft. to ft. GRAVEL PACK INTERVALS: From 18. ft. to ft., From ft. to ft. From	TYPE OF SCREEN OR PERFORATION MATERIAL:							
SCREEN OR PERFORATION OPENINGS ARE: Continuous Slot	☐ Steel ☐ Stainless Steel ☐ Fiberglass ☐ PVC ☐ Other (Specify)							
Continuous Stot Mill Slot Gauze Wrapped Torch Cut Drilled Holes Other (Specify) Louvered Shutter Key Punched Wire Wrapped Saw Cut None (Open Hole) SCREEN-PERFORATED INTERVALS: From 20	☐ Brass ☐ Galvanized Steel ☐ Concrete tile ☐ None used (open hole)							
Louvered Shutter Key Punched Wire Wrapped Saw Cut None (Open Hole) SCREEN-PERFORATED INTERVALS: From 20 ft. to 30 ft., From ft. to ft., From ft. to ft. GRAVEL PACK INTERVALS: From 18 ft. to 30 ft., From ft. to ft., From ft. to ft. GRAVEL PACK INTERVALS: From 18 ft. to 30 ft., From ft. to ft. GROUT MATERIAL: Neat cement Cement grout Bentonite Other Grout Intervals: From 2 ft. to 18 ft., From ft. to ft. Grout Intervals: From 2 ft. to 18 ft., From ft. to ft. Nearest source of possible contamination: Septic Tank Lateral Lines Pit Privy Livestock Pens Insecticide Storage Sewer Lines Seepage Pit Feedyard Fertilizer Storage Oil Well/Gas Well Other (Specify) Direction from well? Distance from well? ft. Officer (Specify) Direction from well? Distance from well? ft. Officer (Specify) Direction from well? ft. Officer (Specify) Direction from well? ft. Officer (Specify) Direction from well ft. Officer (Specify) ft. Officer (Specify) Direction from well ft. Officer (Specify) ft. Officer (SCREEN OR PERFORATION OPENINGS ARE:							
SCREEN-PERFORATED INTERVALS: From 20	☐ Continuous Slot ☐ Mill Slot ☐ Gauze Wrapped ☐ Torch Cut ☐ Drilled Holes ☐ Other (Specify)							
GRAVEL PACK INTERVALS: From 18 ft. to 30 ft., From ft. to ft., From ft. to ft.	☐ Louvered Shutter ☐ Key Punched ☐ Wire Wrapped ☐ Saw Cut ☐ None (Open Hole)							
9 GROUT MATERIAL: Neat cement Cement grout Bentonite Other Grout Intervals: From 2 ft. to 18 ft., From ft. to ft., From ft., From ft., To ft., From ft., From ft., From ft., To ft., From f	SCREEN-PERFORATED INTERVALS: From .20 ft. to .30 ft., From ft., From ft., From ft. to ft.							
Notes: Nearest source of possible contamination:	GRAVEL PACK INTERVALS: From							
Notes: Nearest source of possible contamination:	9 GROUT MATERIAL: ☐ Neat cement ☐ Cement grout ☐ Bentonite ☐ Other							
Septic Tank	Grout Intervals: From							
Sewer Lines	· · · · · · · · · · · · · · · · · · ·							
Watertight Sewer Lines		_	,					
Other (Specify) Direction from well? Distance from well? Ithough To LITHOLOGIC LOG FROM TO LITHO. LOG (cont.) or PLUGGING INTERVALS Solid Light Brown silty clay Solid Light Brown medium sand Solid Light Brown medi								
Direction from well?				☐ ł	rertilizer Stoi	age ∐ Oil We	as well	
11 CONTRACTOR'S OR LANDOWNER'S CERTIFICATION: This water well was constructed, reconstructed, or plugged under my jurisdiction and was completed on (mo-day-year) 5/31/2019 and this record is true to the best of my knowledge and belief. Kansas Water Well Contractor's License No. 7:10. This water Well Record was completed on (mo-day-year) 5/31/2019 and this record is true to the best of my knowledge and belief. Kansas Water Well Contractor's License No. 7:10. This water Well Record was completed on (mo-day-year) 06/26/2019 and this record is true to the best of my knowledge and belief. Kansas Water Well Contractor's License No. 7:10. This water Well Record was completed on mod day-year) 06/26/2019 and this record is true to the best of my knowledge and belief. Kansas Water Well Contractor's License No. 7:10. Signature Mail I white copy along with a fee of \$5.00 for each constructed well to: Kansas Department of Health and Environment, Bureau of Water, GWTS Section, 1000 SW Jackson St., Suite 420, Topeka, Kansas 66612-1367. Mail one to Water Well Owner and retain one for your records. Telephone 785-296-5524.	Direction from well?		Distance from 11	 119		c.		
0 5 Black silty clay 5 25 Light Brown silty clay 25 30 Light brown medium sand Notes: Notes: Notes:		LITHOLO	CIC LOC					
5 25 Light Brown silty clay 25 30 Light brown medium sand Notes: 11 CONTRACTOR'S OR LANDOWNER'S CERTIFICATION: This water well was ■ constructed, □ reconstructed, or □ plugged under my jurisdiction and was completed on (mo-day-year) 5/31/2019			GIC LOG	TROW	10	LITTIO. LOG (COIII.) OI	I LOGOTIAO TIA LEKA MES	
Notes: 11 CONTRACTOR'S OR LANDOWNER'S CERTIFICATION: This water well was constructed, reconstructed, or plugged under my jurisdiction and was completed on (mo-day-year) 5/31/2019 and this record is true to the best of my knowledge and belief. Kansas Water Well Contractor's License No. 710 This Water Well Record was completed on (no-day-year) 06/26/2019 under the business name of Below Ground Surface, Inc. Mail white copy along with a fee of \$5.00 for each constructed well to: Kansas Department of Health and Environment, Bureau of Water, GWTS Section, 1000 SW Jackson St., Suite 420, Topeka, Kansas 66612-1367. Mail one to Water Well Owner and retain one for your records. Telephone 785-296-5524.				1				
Notes: 11 CONTRACTOR'S OR LANDOWNER'S CERTIFICATION: This water well was constructed, reconstructed, or plugged under my jurisdiction and was completed on (mo-day-year) 5/31/2019 and this record is true to the best of my knowledge and belief. Kansas Water Well Contractor's License No. 710 This Water Well Record was completed on Inolday-year) 06/26/2019 under the business name of Below Ground Surface. Inc. Mail I white copy along with a fee of \$5.00 for each constructed well to: Kansas Department of Health and Environment, Bureau of Water, GWTS Section, 1000 SW Jackson St., Suite 420, Topeka, Kansas 66612-1367. Mail one to Water Well Owner and retain one for your records. Telephone 785-296-5524.				+				
11 CONTRACTOR'S OR LANDOWNER'S CERTIFICATION: This water well was constructed, reconstructed, or plugged under my jurisdiction and was completed on (mo-day-year) 5/31/2019 and this record is true to the best of my knowledge and belief. Kansas Water Well Contractor's License No. 710 This Water Well Record was completed on no day-year) 96/26/2019 under the business name of Below Ground Surface, Inc. Signature Mail I white copy along with a fee of \$5.00 for each constructed well to: Kansas Department of Health and Environment, Bureau of Water, GWTS Section, 1000 SW Jackson St., Suite 420, Topeka, Kansas 66612-1367. Mail one to Water Well Owner and retain one for your records. Telephone 785-296-5524.		g oromi modium sand		 				
11 CONTRACTOR'S OR LANDOWNER'S CERTIFICATION: This water well was constructed, reconstructed, or plugged under my jurisdiction and was completed on (mo-day-year) 5/31/2019 and this record is true to the best of my knowledge and belief. Kansas Water Well Contractor's License No. 710 This Water Well Record was completed on no day-year) 96/26/2019 under the business name of Below Ground Surface, Inc. Signature Mail I white copy along with a fee of \$5.00 for each constructed well to: Kansas Department of Health and Environment, Bureau of Water, GWTS Section, 1000 SW Jackson St., Suite 420, Topeka, Kansas 66612-1367. Mail one to Water Well Owner and retain one for your records. Telephone 785-296-5524.				+				
11 CONTRACTOR'S OR LANDOWNER'S CERTIFICATION: This water well was constructed, reconstructed, or plugged under my jurisdiction and was completed on (mo-day-year) 5/31/2019 and this record is true to the best of my knowledge and belief. Kansas Water Well Contractor's License No. 710 This Water Well Record was completed on no day-year) 96/26/2019 under the business name of Below Ground Surface, Inc. Signature Mail I white copy along with a fee of \$5.00 for each constructed well to: Kansas Department of Health and Environment, Bureau of Water, GWTS Section, 1000 SW Jackson St., Suite 420, Topeka, Kansas 66612-1367. Mail one to Water Well Owner and retain one for your records. Telephone 785-296-5524.								
11 CONTRACTOR'S OR LANDOWNER'S CERTIFICATION: This water well was constructed, reconstructed, or plugged under my jurisdiction and was completed on (mo-day-year) 5/31/2019 and this record is true to the best of my knowledge and belief. Kansas Water Well Contractor's License No. 710 This Water Well Record was completed on no day-year) 96/26/2019 under the business name of Below Ground Surface, Inc. Mail I white copy along with a fee of \$5.00 for each constructed well to: Kansas Department of Health and Environment, Bureau of Water, GWTS Section, 1000 SW Jackson St., Suite 420, Topeka, Kansas 66612-1367. Mail one to Water Well Owner and retain one for your records. Telephone 785-296-5524.				1				
under my jurisdiction and was completed on (mo-day-year) 5/31/2019 and this record is true to the best of my knowledge and belief. Kansas Water Well Contractor's License No. 710 This Water Well Record was completed on pholday-year) 96/26/2019 under the business name of Below Ground Surface, Inc. Mail I white copy along with a fee of \$5.00 for each constructed well to: Kansas Department of Health and Environment, Bureau of Water, GWTS Section, 1000 SW Jackson St., Suite 420, Topeka, Kansas 66612-1367. Mail one to Water Well Owner and retain one for your records. Telephone 785-296-5524.				Notes:				
under my jurisdiction and was completed on (mo-day-year) 5/31/2019 and this record is true to the best of my knowledge and belief. Kansas Water Well Contractor's License No. 710 This Water Well Record was completed on pholday-year) 96/26/2019 under the business name of Below Ground Surface, Inc. Mail I white copy along with a fee of \$5.00 for each constructed well to: Kansas Department of Health and Environment, Bureau of Water, GWTS Section, 1000 SW Jackson St., Suite 420, Topeka, Kansas 66612-1367. Mail one to Water Well Owner and retain one for your records. Telephone 785-296-5524.				_				
under my jurisdiction and was completed on (mo-day-year) 5/31/2019 and this record is true to the best of my knowledge and belief. Kansas Water Well Contractor's License No. 710 This Water Well Record was completed on pholday-year) 96/26/2019 under the business name of Below Ground Surface, Inc. Mail I white copy along with a fee of \$5.00 for each constructed well to: Kansas Department of Health and Environment, Bureau of Water, GWTS Section, 1000 SW Jackson St., Suite 420, Topeka, Kansas 66612-1367. Mail one to Water Well Owner and retain one for your records. Telephone 785-296-5524.	11 002	0011	OF OFF					
Kansas Water Well Contractor's License No. 710. This Water Well Record was completed on Thofday-year) 06/26/2019. under the business name of Below Ground Surface, Inc. Signature Mail I white copy along with a fee of \$5.00 for each constructed well to: Kansas Department of Health and Environment, Bureau of Water, GWTS Section, 1000 SW Jackson St., Suite 420, Topeka, Kansas 66612-1367. Mail one to Water Well Owner and retain one for your records. Telephone 785-296-5524.	11 CONTRACTOR'S	OR LANDOWNER	S CERTIFICATION	: This water	well was	constructed, reco	onstructed, or plugged	
under the business name of Below Ground Surface, Inc. Signature Mail 1 white copy along with a fee of \$5.00 for each constructed well to: Kansas Department of Health and Environment, Bureau of Water, GWTS Section, 1000 SW Jackson St., Suite 420, Topeka, Kansas 66612-1367. Mail one to Water Well Owner and retain one for your records. Telephone 785-296-5524.	under my jurisdiction an	id was completed on (mo-day-year) 5/31/2019	and t	nis record is	s true to the best of m	ly knowledge and belief.	
Mail 1 white copy along with a fee of \$5.00 for each constructed well to: Kansas Department of Health and Environment, Bureau of Water, GWTS Section, 1000 SW Jackson St., Suite 420, Topeka, Kansas 66612-1367. Mail one to Water Well Owner and retain one for your records. Telephone 785-296-5524.	under the business neme	of Below Ground Surface	ce. Inc.	ner well Kec	ora was con	piered on vito day-y	<u>-</u>	
1000 SW Jackson St., Suite 420, Topeka, Kansas 66612-1367. Mail one to Water Well Owner and retain one for your records. Telephone 785-296-5524.	Mail I white copy alor	ng with a fee of \$5.00 for es	ich constructed well to: Kar	isas Denaitment	of Health and	hvirotment Bureau of W	ater, GWTS Section.	
	1000 SW Jackson St	Suite 420 Topeka Kansa	s 66612-1367 Mail one to	Water Well Own	er and retain o	ne for your records. Telenl	none 785-296-5524.	
Visit us at http://www.kdheks.gov/waterwell/index.html KSA 82a-1212 Revised 7/10/2015				KSA 82a-12			Revised 7/10/2015	

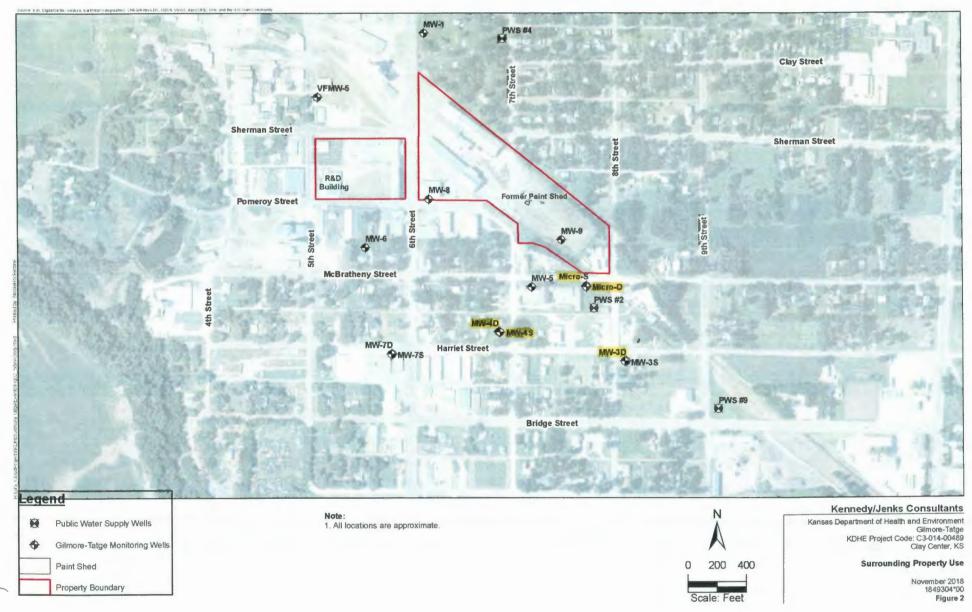

C. Bar