
WATER WELL R			ion of Water	MW-2D		
Original Record			rces App. No.	Well ID		
1 LOCATION OF W.	ATER WELL: Fraction		on Number	Township Number Range Number		
County: Clay	NW14 NW14 1	VE 1/4 SW 1/4	8	T 8 S $R 3 \blacksquare E \square W$		
2 WELL OWNER: Last Name: First: Street or Rural Address where well is located (if unknown, distance and						
Business: KDHE direction from nearest town or intersection): If at owner's address, check here:						
Address: 1000 SW Jackson St; Ste. 410 58th Stand Mc Brath ney St.						
Addense:						
City: Topeka	State: KS ZIP: 66612	Clay (enter K	3		
3 LOCATE WELL	4 DEPTH OF COMPLETED WE	J	5 T - 4'4 - 3 -	39. 37091 (decimal degrees)		
WITH "X" IN	4 DEPTH OF COMPLETED WE		5 Latitude:	e: ~97.12141 (decimal degrees)		
SECTION BOX:	Depth(s) Groundwater Encountered: 1).		Longitud	e: (decimal degrees)		
N	2)		Horizonta	Datum: ■ WGS 84 □ NAD 83 □ NAD 27		
	WEŁL'S STATIC WATER LEVEL: ft. □ below land surface, measured on (mo-day-yr)			Source for Latitude/Longitude: GPS (unit make/model: Garmin etrek)		
' '			GPS (unit make/model:		
NW NE	above land surface, measured on (me			WAAS enabled? Yes No)		
	Pump test data: Well water was			Survey Topographic Map		
W X E	after hours pumping			e Mapper:		
SW SE						
	after hours pumping	gpm	6 Elevation	:ft. Ground Level TOC		
S	Estimated Yield:gpm Bore Hole Diameter:8.5 in. to	58 &		Land Survey GPS Topographic Map		
mile	Bore Hole Diameter:	It. and		Other		
7 1111.0						
7 WELL WATER TO BE USED AS:						
1. Domestic:	5. Public Water Supply: well			eld Water Supply: lease		
Household	6. ☐ Dewatering: how many we			: well ID		
Lawn & Garden	7. ☐ Aquifer Recharge: well ID8. ☐ Monitoring: well ID	MW-2D		Uncased Geotechnical		
Livestock				al: how many bores?		
2. Irrigation	9. Environmental Remediation: v			Loop Horizontal Vertical		
3. ☐ Feedlot		apor Extraction		Loop ☐ Surface Discharge ☐ Inj. of Water		
4. ☐ Industrial ☐ Recovery ☐ Injection 13. ☐ Other (specify):						
Was a chemical/bacteriological sample submitted to KDHE? Yes No If yes, date sample was submitted:						
Water well disinfected? ☐ Yes ■ No						
8 TYPE OF CASING USED: ☐ Steel ☐ PVC ☐ Other						
Casing diameter 2 in to 48 ft., Diameter in to ft., Diameter in to ft. Casing height above land surface 6 in Weight 1bs./ft. Wall thickness or gauge No. sch 40 ft.						
Casing height above land s	surface -6 in Weight	lbs /ft	Wall thicknes	s or gauge No. sch 40		
	PERFORATION MATERIAL:			o		
1	nless Steel Fiberglass F	DVC	□ Other (Specify)		
		None used (open hole)		opecity)		
SCREEN OR PERFORATION OPENINGS ARE:						
Continuous Slot		□ Toroh Cut □ Dr	illad Holes	Other (Specify)		
☐ Continuous Slot ☐ Mill Slot ☐ Gauze Wrapped ☐ Torch Cut ☐ Drilled Holes ☐ Other (Specify) ☐ Louvered Shutter ☐ Key Punched ☐ Wire Wrapped ☐ Saw Cut ☐ None (Open Hole)						
SCREEN-PERFORATED INTERVALS: From .48 ft. to .58 ft., From ft. to ft. to ft.						
GRAVEL PACK INTERVALS: From						
9 GROUT MATERIA	L: Neat cement	■ Bentonite □ Ot	her			
9 GROUT MATERIAL: ☐ Neat cement ☐ Cement grout ☐ Bentonite ☐ Other ☐ Other ☐ Grout Intervals: From ☐ ft. to ☐ ft., From ☐ ft. to ☐ ft., From ☐ ft. to ☐ ft.						
Nearest source of possible contamination:						
☐ Septic Tank ☐ Lateral Lines ☐ Pit Privy ☐ Livestock Pens ☐ Insecticide Storage						
☐ Sewer Lines ☐ Cess Pool ☐ Sewage Lagoon ☐ Fuel Storage ☐ Abandoned Water Well						
☐ Watertight Sewer Lines ☐ Seepage Pit ☐ Feedyard ☐ Fertilizer Storage ☐ Oil Well/Gas Well						
☐ Other (Specify) Direction from well? Distance from well? ft.						
10 FROM TO	LITHOLOGIC LOG	FROM	TO LI	THO. LOG (cont.) or PLUGGING INTERVALS		
	Black silty clay					
	ight Brown silty clay					
25 30 L	ight brown medium sand					
30 60 L	ight brown medium sand; increasing grain size					
		Notes:	l			
		Notes:				
11 CONTRACTOR'S OR LANDOWNER'S CERTIFICATION: This water well was constructed, reconstructed, or plugged						
under my jurisdiction and was completed on (mo-day-year) 5/31/2019 and this record is trace to the best of my knowledge and belief.						
Kansas Water Well Contractor's License No. 710 This Water Well Record was completed on (no-day-year) 06/26/2019						
under the business name of Below Ground Surface, Inc. Mail 1 white copy along with a fee of \$5.00 for each constructed well to: Kansas Department of Health and Environment, Bureau of Water, GWTS Section,						
Mail I white copy along with a fee of \$5.00 for each constructed well to: Kansas Department of Health and Warvironment, Bureauth Water, GWTS Section, 1000 SW Jackson St., Suite 420, Topeka, Kansas 66612-1367. Mail one to Water Well Owner and retain one for your records. Telephone 785-296-5524.						
Visit us at http://www.kdheks	s.gov/waterwell/index.html	KSA 82a-121	L	Revised 7/10/2015		

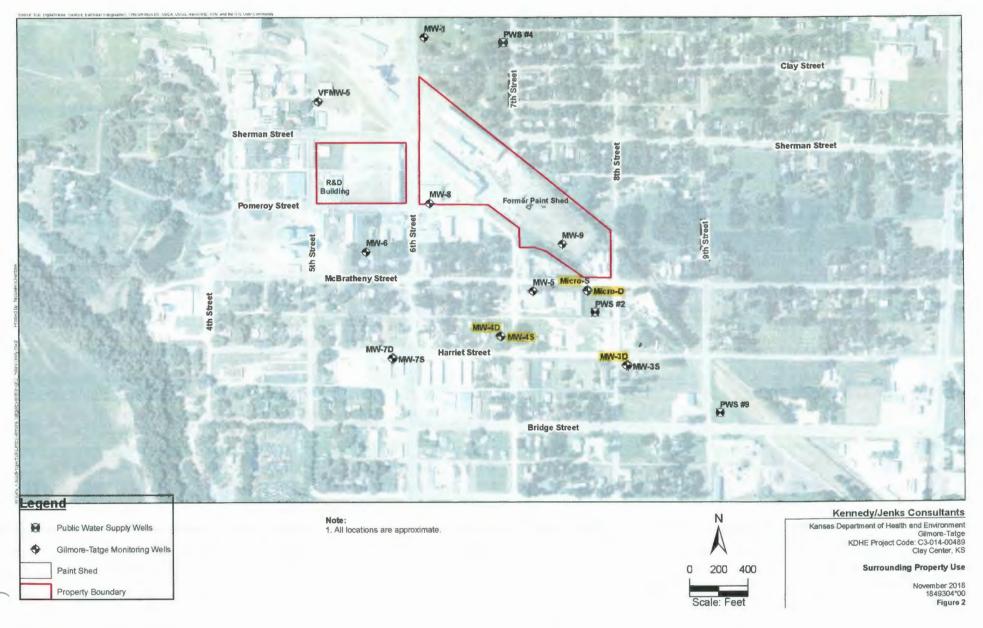

() and