
	WWC-5		ision of Water		Gmw-17	
	e in Well Use		urces App. No		Well ID	
1 LOCATION OF WATER WELL:	Fraction		tion Number			
County: Jefferson	SE¼ SE¼ NW¼		9	T 9 S	R 17 ■E □ W	
2 WELL OWNER: Last Name:					(if unknown, distance and	
Business: US ARMY CORP of engineers Address: 601 East 12th street	Kansas City district	irection from	nearest town or i	ntersection): If at owne	r's address, check here:	
Address: OUT East 12th street						
City: Kansas city State: MO	ZIP: 64106					
2 LOCATE WELL		22 0		20 2705	20	
WITH "Y" IN 4 DEPTH OF CON	IPLETED WELL:		5 Latitud	le:39.2/93	29 (decimal degrees)	
	Encountered: 1)				399 (decimal degrees)	
	2)					
	WELL'S STATIC WATER LEVEL:ft. Source for Latitude/Longitude: □ below land surface, measured on (mo-day-yr)					
	above land surface, measured on (mo-day-yr)			(WAAS enabled? ☐ Yes ☐ No)		
	Pump test data: Well water was			☐ Land Survey ☐ Topographic Map		
	after hours pumping gpm			Online Mapper:		
Well v	Well water was ft.					
afterhour	after hours pumping gpm			6 Elevation:ft. Ground Level TOC		
Estimated Yield:	Estimated Yield:gpm			Source: Land Survey GPS Topographic Map		
	Bore Hole Diameter:6 in. to25 ft. and			Other		
7 WELL WATER TO BE USED AS:	stor Cumples		10 🗆 🗠	Field Weter Commun.	222	
	5. Public Water Supply: well ID					
	6. ☐ Dewatering: how many wells?			11. Test Hole: well ID		
☐ Livestock 8. ■ Monitorin	8. Monitoring: well ID					
2. Irrigation 9. Environment	9. Environmental Remediation: well ID					
	☐ Air Sparge ☐ Soil Vapor Extraction b) Open Loop ☐ Surface Discharge ☐ Inj. of Water					
4. Industrial Recovery Injection 13. Other (specify):						
Was a chemical/bacteriological sample submitted to KDHE? ☐ Yes ■ No If yes, date sample was submitted:						
Water well disinfected? Yes No						
8 TYPE OF CASING USED: ☐ Steel ■ PVC ☐ Other						
Casing diameter 2 in to 12 ft Diameter in to ft Diameter in to ft						
Casing diameter						
TYPE OF SCREEN OR PERFORATION MATERIAL:						
☐ Steel ☐ Stainless Steel ☐ Fiberglass ■ PVC ☐ Other (Specify)						
☐ Brass ☐ Galvanized Steel ☐ Concrete tile ☐ None used (open hole)						
SCREEN OR PERFORATION OPENINGS ARE:						
☐ Continuous Slot ☐ Mill Slot ☐ Gauze Wrapped ☐ Torch Cut ☐ Drilled Holes ☐ Other (Specify)						
☐ Louvered Shutter ☐ Key Punched ☐ Wire Wrapped ☐ Saw Cut ☐ None (Open Hole)						
SCREEN-PERFORATED INTERVALS: From .12 ft. to .22 ft., From ft. to ft., From ft. to ft.						
GRAVEL PACK INTERVALS: From						
9 GROUT MATERIAL; ☐ Neat cement ☐ Cement grout ☐ Bentonite ☐ Other						
Nearest source of possible contamination: Septic Tank						
□ Septic Tank □ Lateral Lines □ Pit Privy □ Livestock Pens □ Insecticide Storage □ Sewer Lines □ Cess Pool □ Sewage Lagoon □ Fuel Storage □ Abandoned Water Well						
Sewel Enles						
■ Other (Specify) N/A						
Direction from well?						
10 FROM TO LITHOLO		FROM			PLUGGING INTERVALS	
0 14 clay						
14 25 limestone						
		Notes:				
11 CONTRACTOR'S OR LANDOWNER'S CERTIFICATION: This water well was constructed, reconstructed, or plugged						
under my jurisdiction and was completed on (mo-day-year) .10-1.7:.17 and this record is true to the best of my knowledge and belief.						
Kansas Water Well Contractor's License No. 597. This Water Well Record was completed the day year 10 11 17 17 17 19 19 19 19 19 19 19 19 19 19 19 19 19						
Mail 1 white copy along with a fee of \$5.00 for any	ch constructed well to Kana		of Health and	nvironment Ruragu a II.	ater GWTS Section	
Mail 1 white copy along with a fee of \$5.00 for each constructed well to: Kansas Department of Health and Environment, Bureau Water, GWTS Section, 1000 SW Jackson St., Suite 420, Topeka, Kansas 66612-1367. Mail one to Water Well Owner and retain one for your records. Telephone 785-296-5524.						
Visit us at http://www.kdheks.gov/waterwell/index.html KSA 82a-1212 Revised 7/10/2015						

U.S. Army Corps of Engineers Kansas City District

Missile Site S-1

Jefferson County, Kansas

HAH

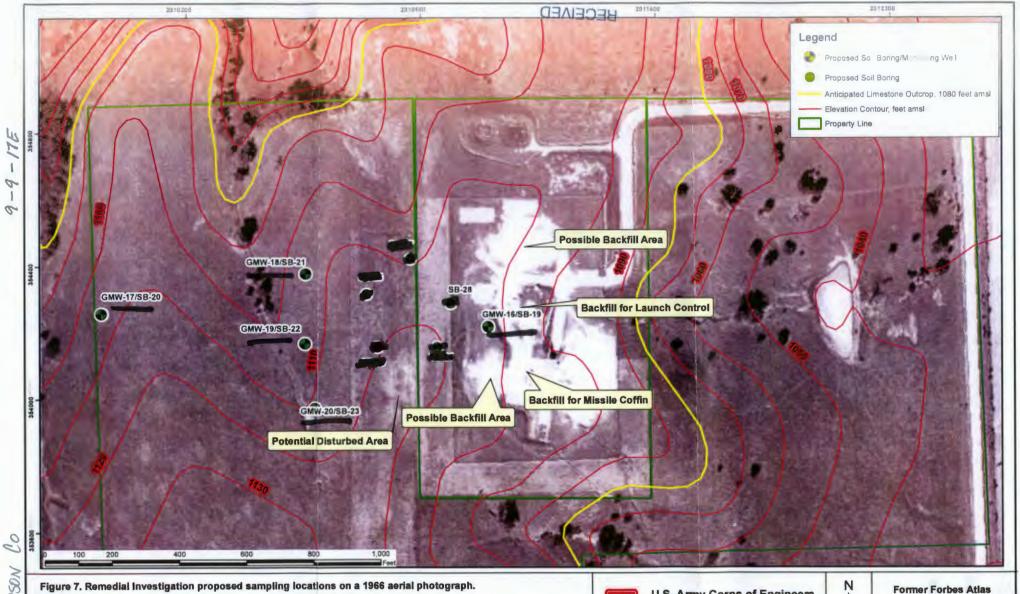

EFFERSON

Base map source - ESRI Digital Globe Elevation contours (feet AMSL) - USGS