
	ATER WELL RECORD Form WWC-5			ision of Water		Janu - 18	
Original Record		ge in Well Use		urces App. No.	T1	Well ID	
1 LOCATION OF W County: Jefferson	ATER WELL:	Fraction SE¼ NE¼ NW¼		tion Number 9	Township Numbe	r Range Number R 17 ■ E □ W	
2 WELL OWNER: La	act Name:						
2 WELL OWNER: Last Name: First: Street or Rural Address where well is located (if unknown, distance and direction from nearest town or intersection): If at owner's address, check here:							
Address: 601 East 12th street							
Address:	a MO	777 04400					
City: Kansas cit	y State: MO	ZIP: 64106		T			
3 LOCATE WELL WITH "X" IN	4 DEPTH OF COMPLETED WELL:23 ft. 4				. 39.28025	9(decimal degrees)	
SECTION BOX:	Depth(s) Groundwater Encountered: 1) ft.				de: -95.5497	30(decimal degrees)	
N N	2) ft. 3) ft., or 4) Dry Well				Horizontal Datum: ■ WGS 84 □ NAD 83 □ NAD 27		
	WELL'S STATIC WA		Source for	r Latitude/Longitude:			
	☐ below land surface ☐ above land surface		■ GPS	(unit make/model:!!)	phone)		
NW NE	Pump test data: Well v		1	(WAAS enabled? ☐ Yes ☐ No) ☐ Land Survey ☐ Topographic Map			
W E	after hour			Online Mapper:			
1 1 1 1 1	Well v	vater was ft.	ic iviapper				
SW SE	after hours pumping gpm						
	Estimated Yield:gpm Bore Hole Diameter:6 in. to25 ft. and				6 Elevation:ft. ☐ Ground Level ☐ TOC Source: ☐ Land Survey ☐ GPS ☐ Topographic Map		
S 1 mile	Bore Hole Diameter:				I Topograpine Wap		
1 mile in, to ft. Uther							
1. Domestic:		ater Supply: well ID		10. □ Oil F	eld Water Supply: lea	ise	
☐ Household	5. Public Water Supply: well ID				10. ☐ Oil Field Water Supply: lease		
☐ Lawn & Garden	7. Aquifer R			☐ Cased ☐ Uncased ☐ Geotechnical			
☐ Livestock	8. Monitorin	/-18		12. Geothermal: how many bores?			
2. Irrigation	9. Environment			a) Closed Loop Horizontal Vertical			
3. Feedlot Soil Vapor Extraction b) Open Loc					Loop Surface Disc	charge 🔲 Inj. of Water	
4. ☐ Industrial ☐ Recovery ☐ Injection 13. ☐ Other (specify):							
Was a chemical/bacteriological sample submitted to KDHE? Yes No If yes, date sample was submitted:							
Water well disinfected? ☐ Yes ■ No							
8 TYPE OF CASING USED: ☐ Steel PVC ☐ Other							
Casing diameter							
TYPE OF SCREEN OR PERFORATION MATERIAL:							
☐ Steel ☐ Stainless Steel ☐ Fiberglass ■ PVC ☐ Other (Specify)							
☐ Brass ☐ Galvanized Steel ☐ Concrete tile ☐ None used (open hole)							
SCREEN OR PERFORATION OPENINGS ARE:							
☐ Continuous Slot ☐ Mill Slot ☐ Gauze Wrapped ☐ Torch Cut ☐ Drilled Holes ☐ Other (Specify)							
☐ Louvered Shutter ☐ Key Punched ☐ Wire Wrapped ☐ Saw Cut ☐ None (Open Hole) SCREEN-PERFORATED INTERVALS: From							
SCREEN-PERFORATE	ED INTERVALS: From	16 0 24	ft., From	ft. to	ft., From	ft. to ft.	
GRAVEL PACK INTERVALS: From							
9 GROUT MATERIAL: □ Neat cement □ Cement grout ■ Bentonite □ Other							
Nearest source of possible contamination:							
☐ Septic Tank ☐ Lateral Lines ☐ Pit Privy ☐ Livestock Pens ☐ Insecticide Storage							
☐ Sewer Lines ☐ Cess Pool ☐ Sewage Lagoon ☐ Fuel Storage ☐ Abandoned Water Well							
☐ Watertight Sewer Lines ☐ Seepage Pit ☐ Feedyard ☐ Fertilizer Storage ☐ Oil Well/Gas Well							
Direction from well?							
Direction from well?	LITHOLO	Distance from wel	FROM			OLLICCING DITERVALO	
	lay	GIC LOG	FROM	IO LI	THO. LOG (cont.) of I	PLUGGING INTERVALS	
1.0	mestone						
.5	IIIO3torio						
	1. 11.		Notes:				
11 CONTRACTOR'S OR LANDOWNER'S CERTIFICATION: This water well was constructed, reconstructed, or plugged							
under my jurisdiction and was completed on (mo-day-year) .10-1.7:-17 and this record is true to the best of my knowledge and belief.							
Kansas Water Well Contractor's License No. 597. This Water Well Record was complete to (mo day year) 10/17/17. under the business name of Cascade Drilling. Signature							
Mail 1 white copy along with a fee of \$5.00 for each constructed well to: Kansas Department of Health and Environment, Bareau of Water, GWTS Section,							
1000 SW Jackson St., Suite 420, Topeka, Kansas 66612-1367. Mail one to Water Well Owner and retain one for your records. Telephone 785-296-5524.							
Visit us at http://www.kdheks.gov/waterwell/index.html KSA 82a-1212 Revised 7/10/2015							

U.S. Army Corps of Engineers Kansas City District

Missile Site S-1

Jefferson County, Kansas

HAH

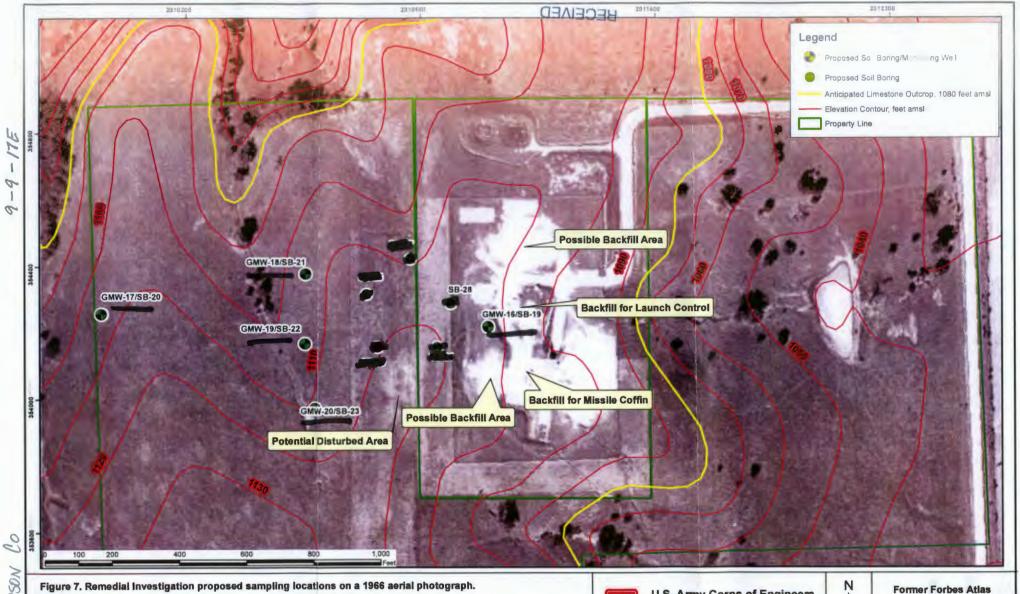

EFFERSON

Base map source - ESRI Digital Globe Elevation contours (feet AMSL) - USGS